


SEC. 7-79-3

240th St / Le Claire Rd.

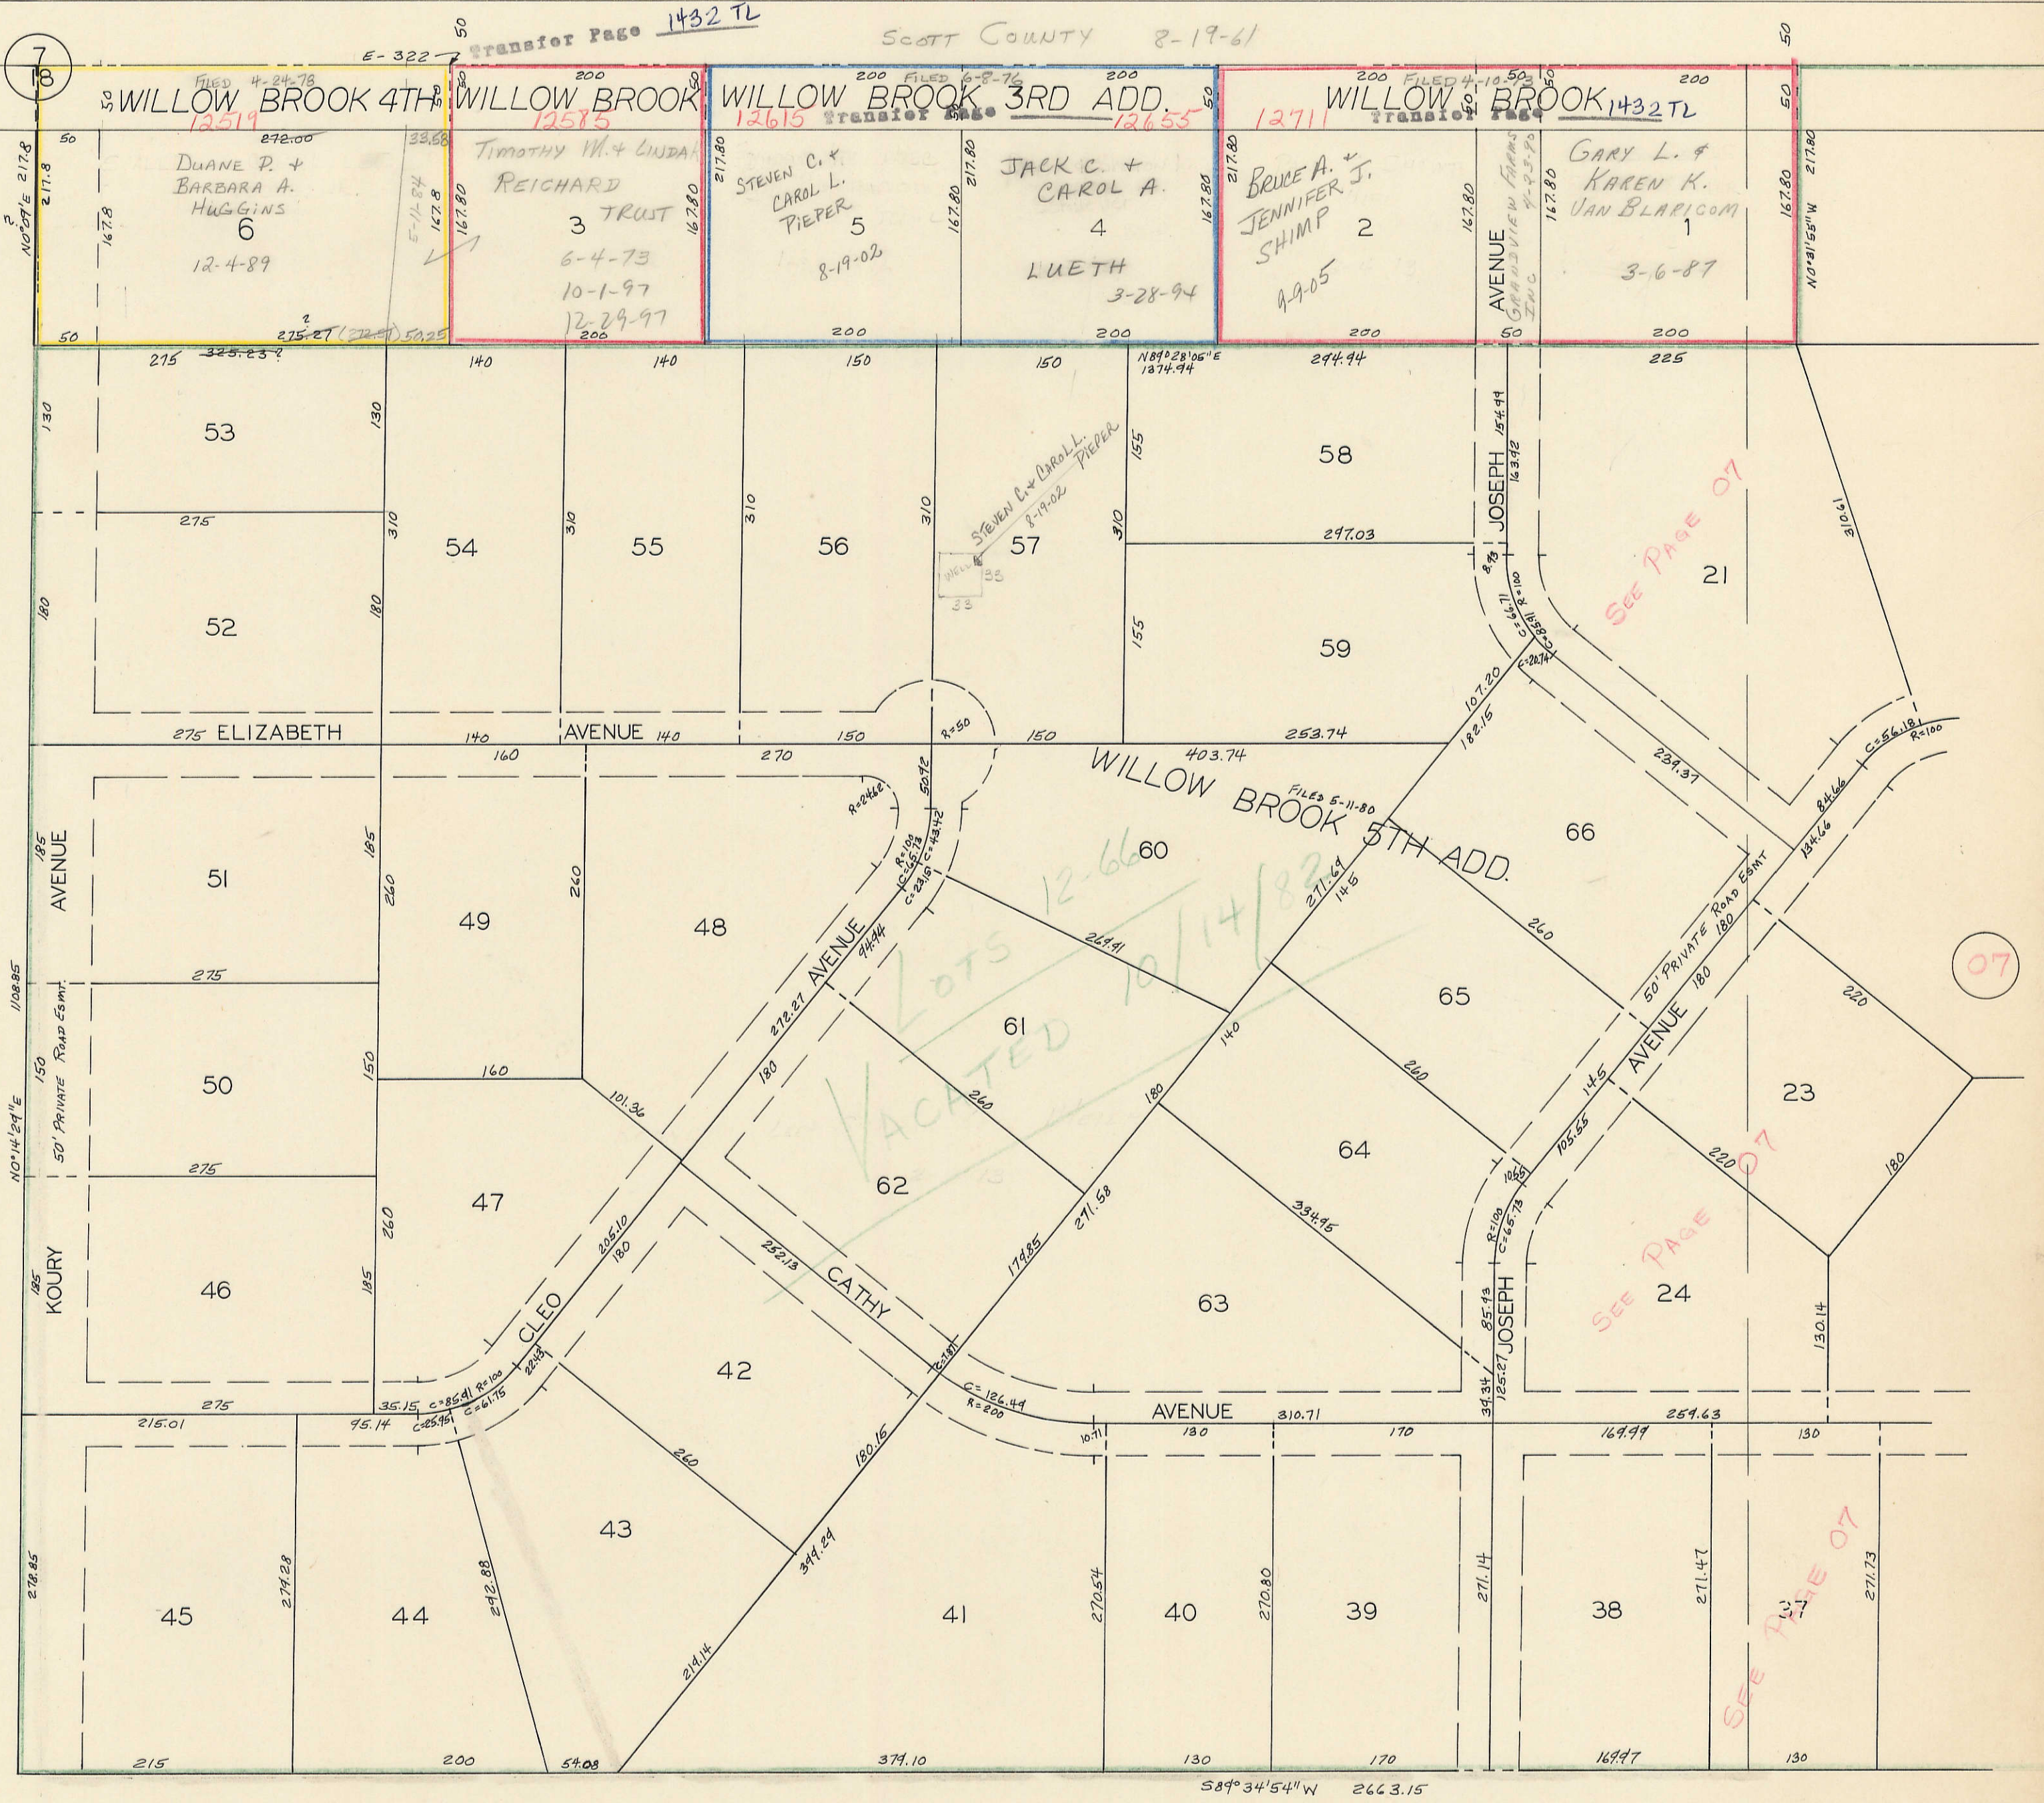

LOTS 12-66 VACATED 10/14/82 # 13443-82
 BLANK LOTS: GRANDVIEW FARMS INC
 11-12-92