

SECTION
11

ANNEX 3-12-96
6-12-03

SCALE IN CHAINS



Township 79-North; Range 3
EAST OF THE FIFTH PRINCIPAL MERIDIAN

SCALE IN FEET




SCOTT COUNTY, IOWA

SHERIDAN TOWNSHIP

Transfer Page 435

NORTH

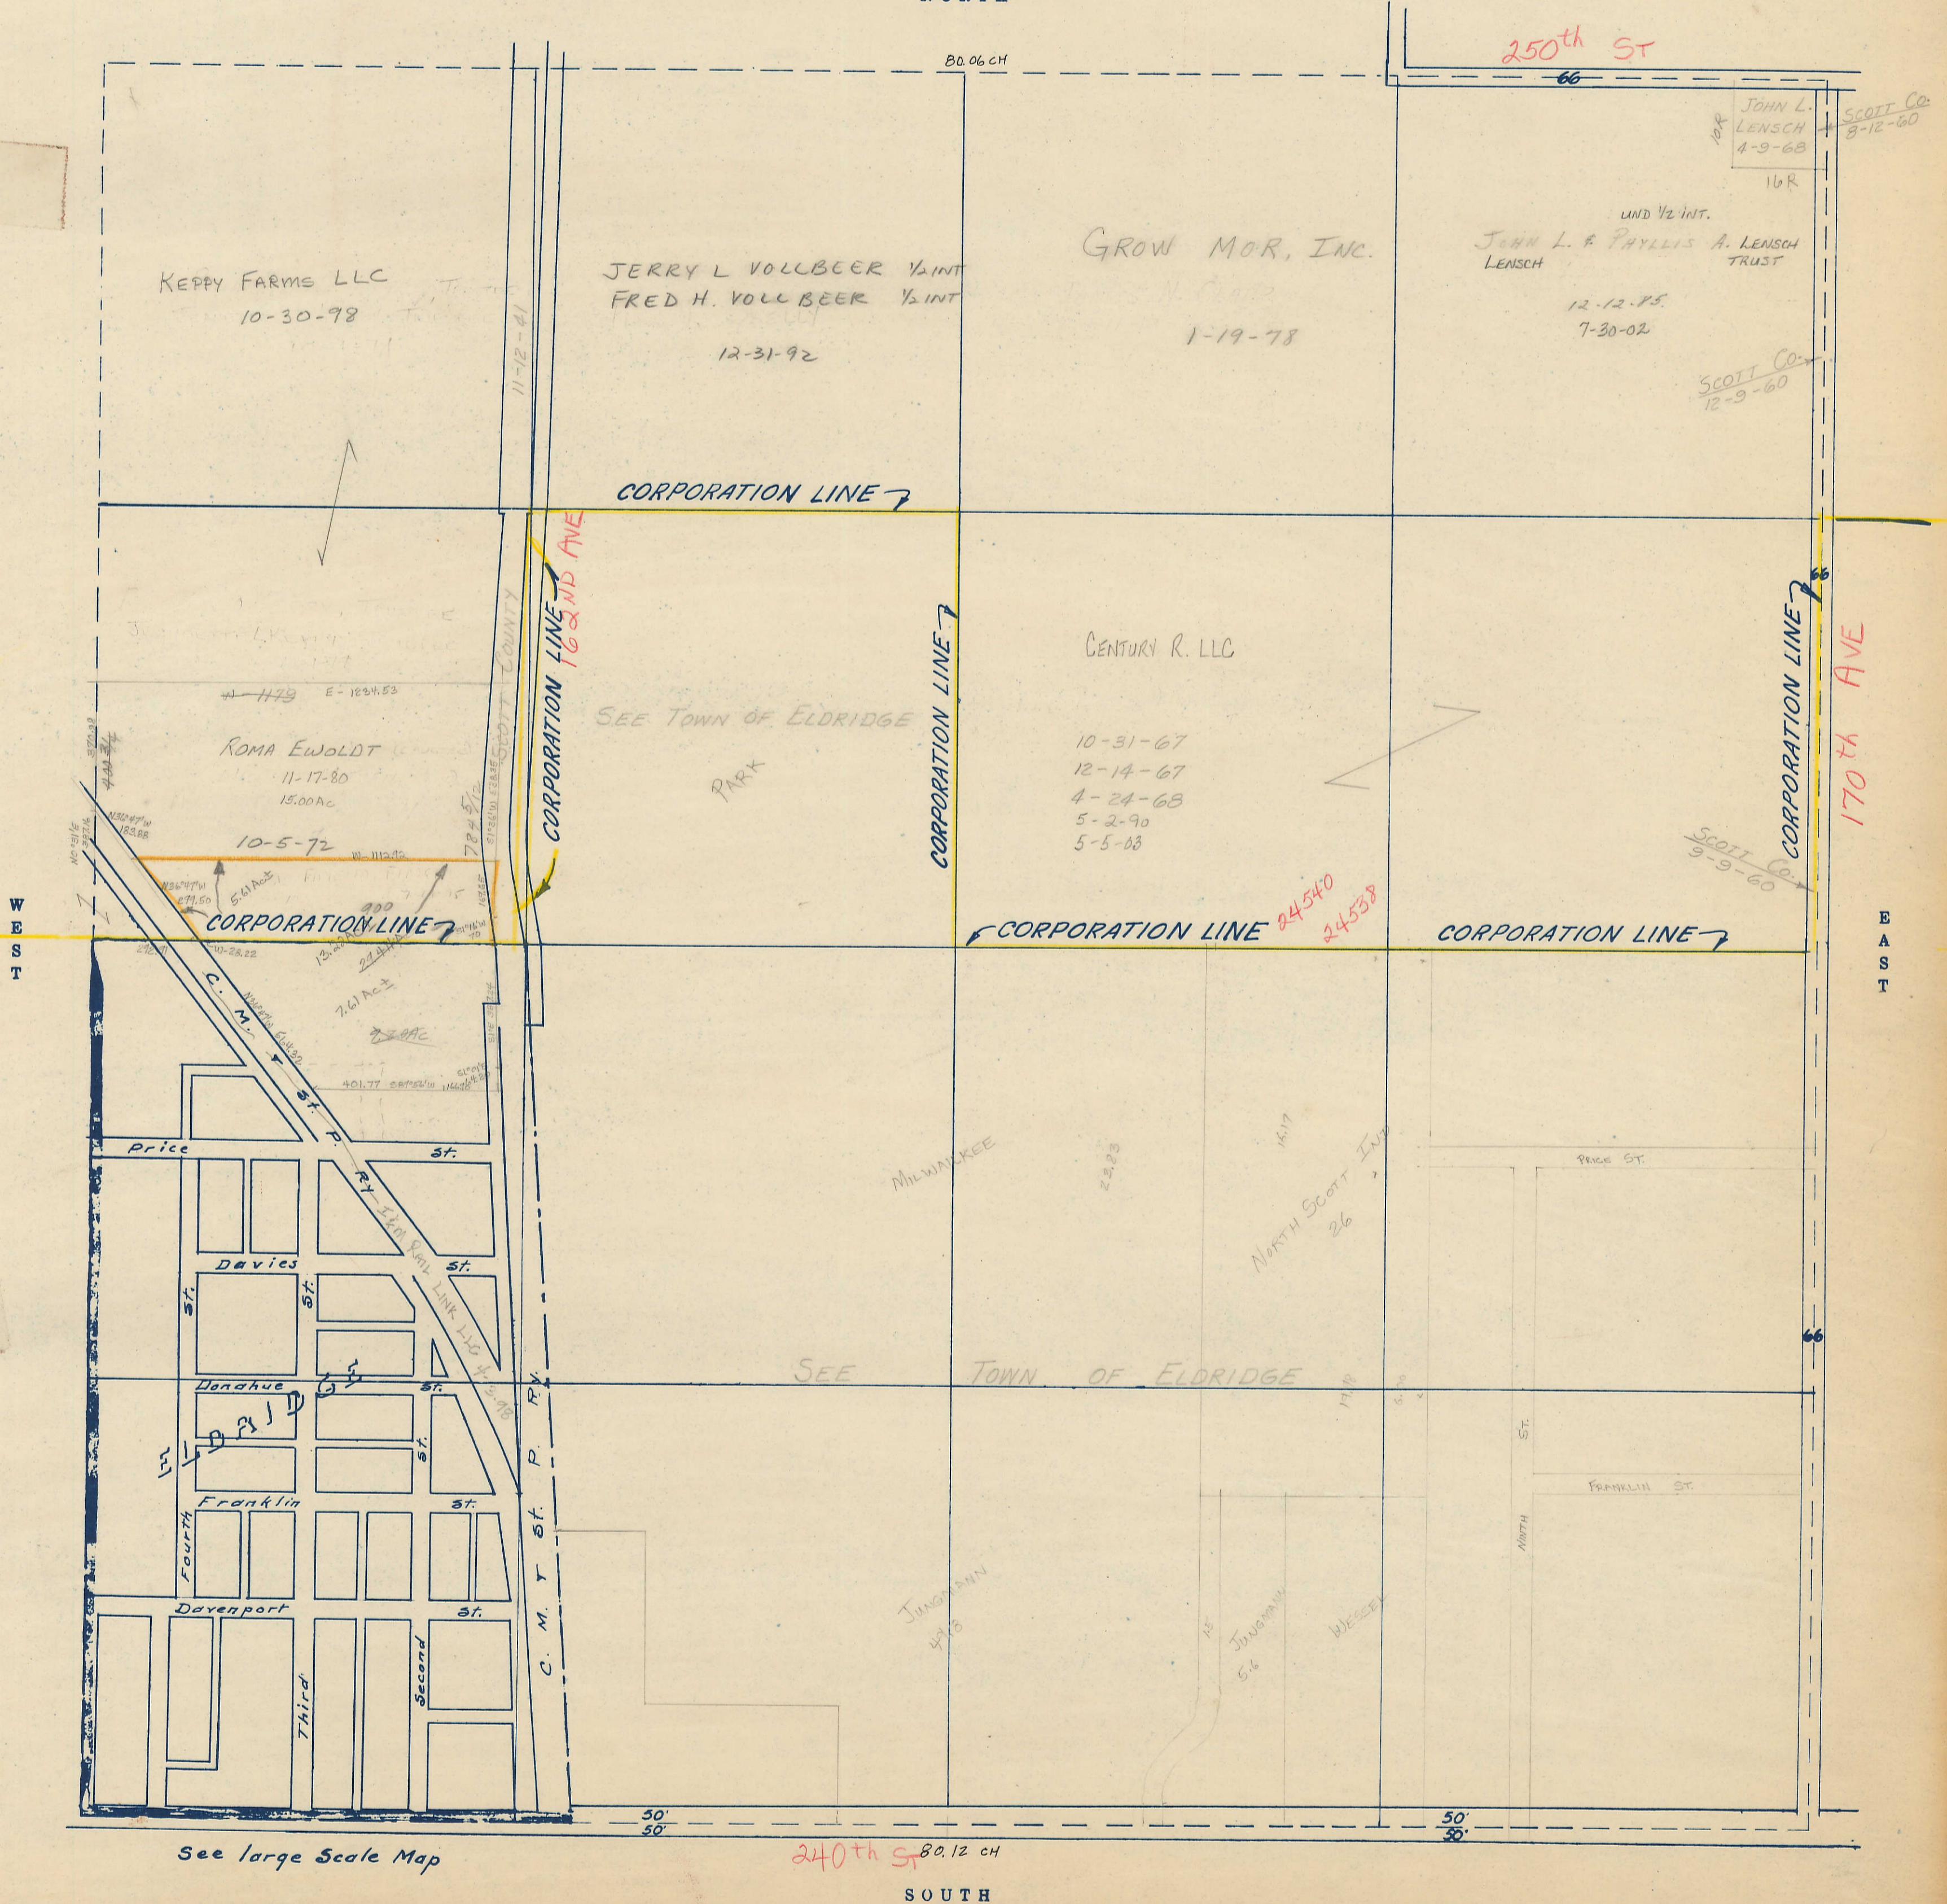

See large Scale Map

240th ST 80.12 CH

SOUTH