

SECTION  
36

SCALE IN CHAINS



Township 79-North; Range 3

EAST OF THE FIFTH PRINCIPAL MERIDIAN

SCOTT COUNTY, IOWA

SHERIDAN TOWNSHIP


SCALE IN FEET



ANNEXATION- 5 OCT. 76 #18614-76  
3-12-96 #6052-96

Transfer Page 460

NORTH

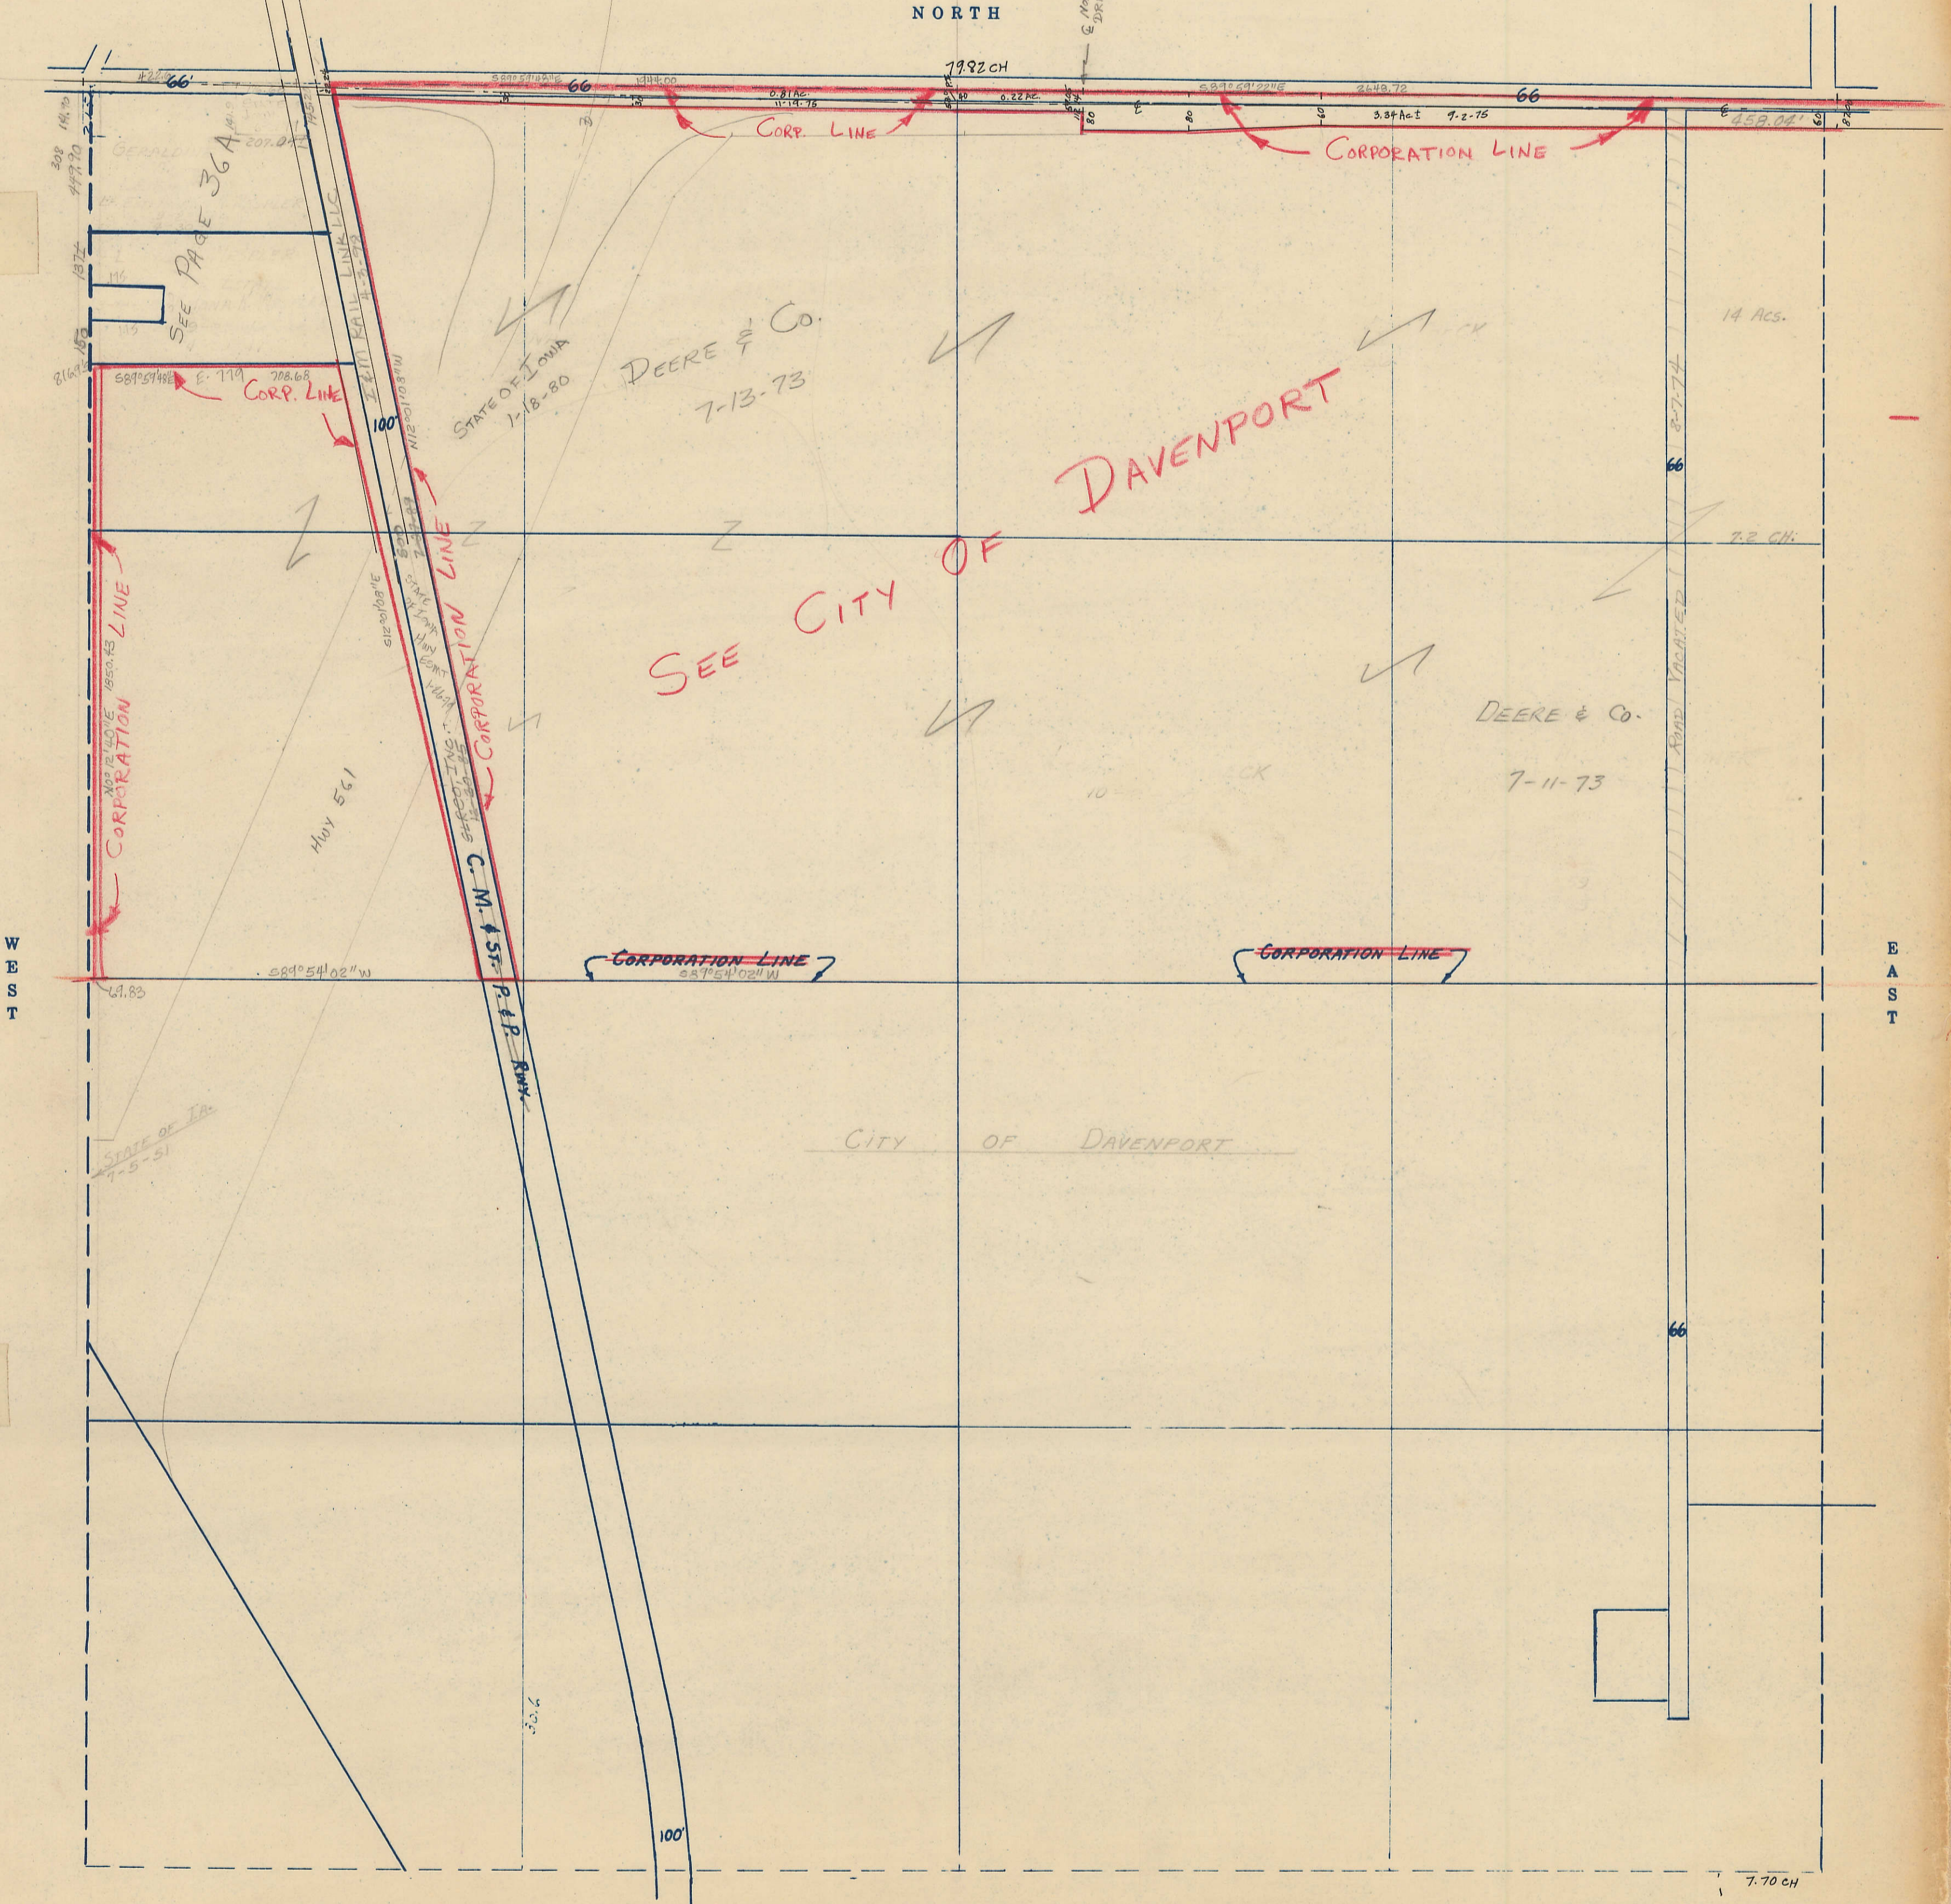

WEST

EAST

SOUTH