


CENTURY ST.

GROVE STREET


Transfer Page 992 T.L.

LINCOLN TOWN OF WALCOTT  
5-22-56

STREET.

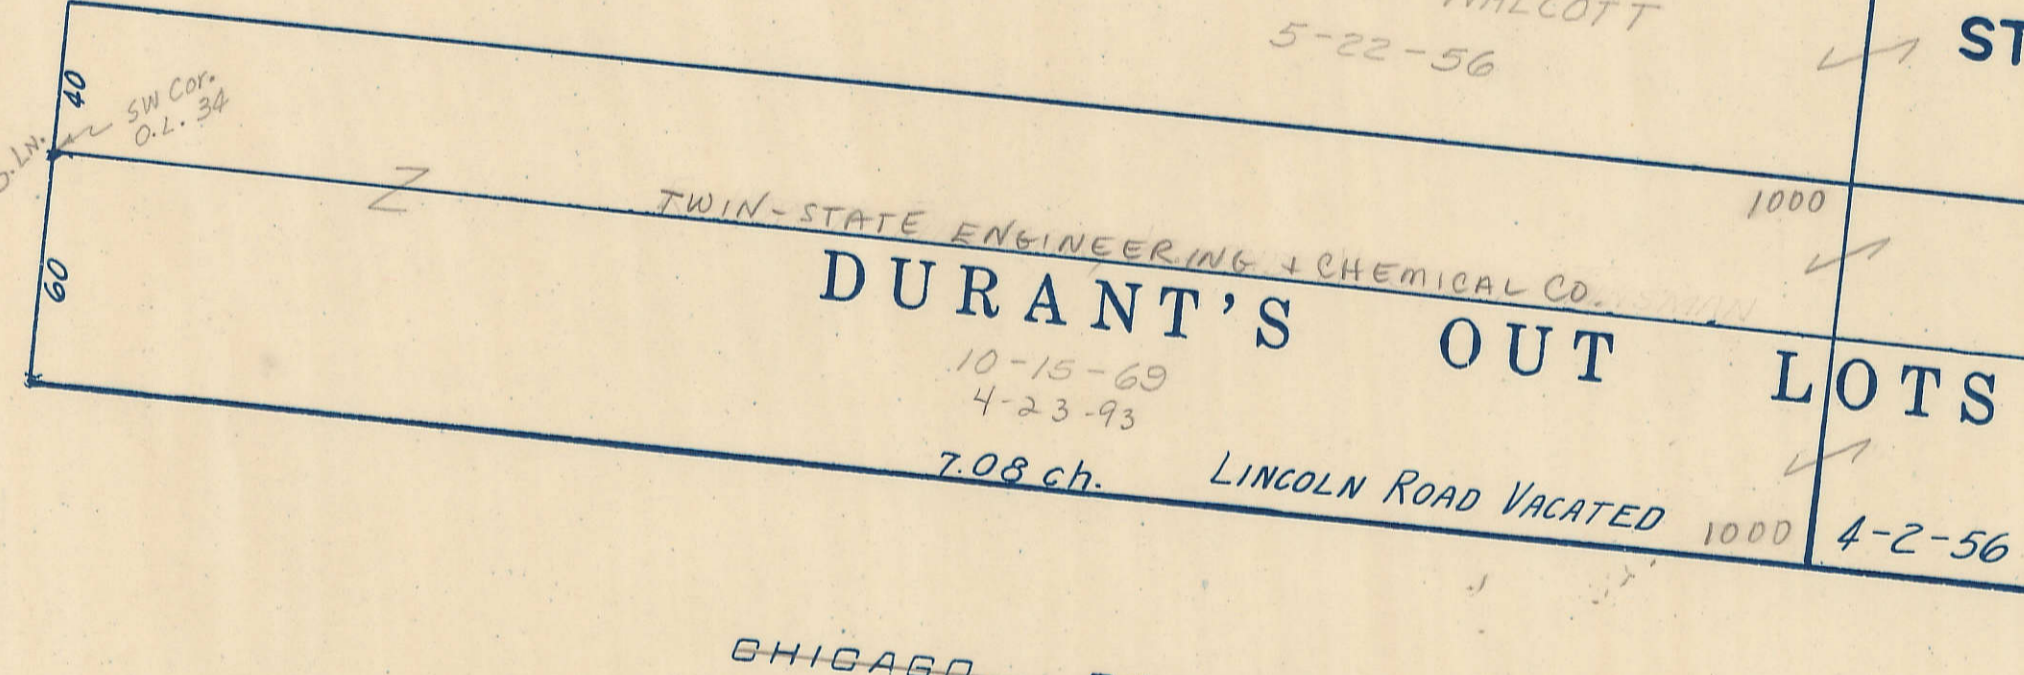

CHICAGO, ROCK ISLAND & PACIFIC R. R.  
Heartland Rail Corporation  
10-12-84

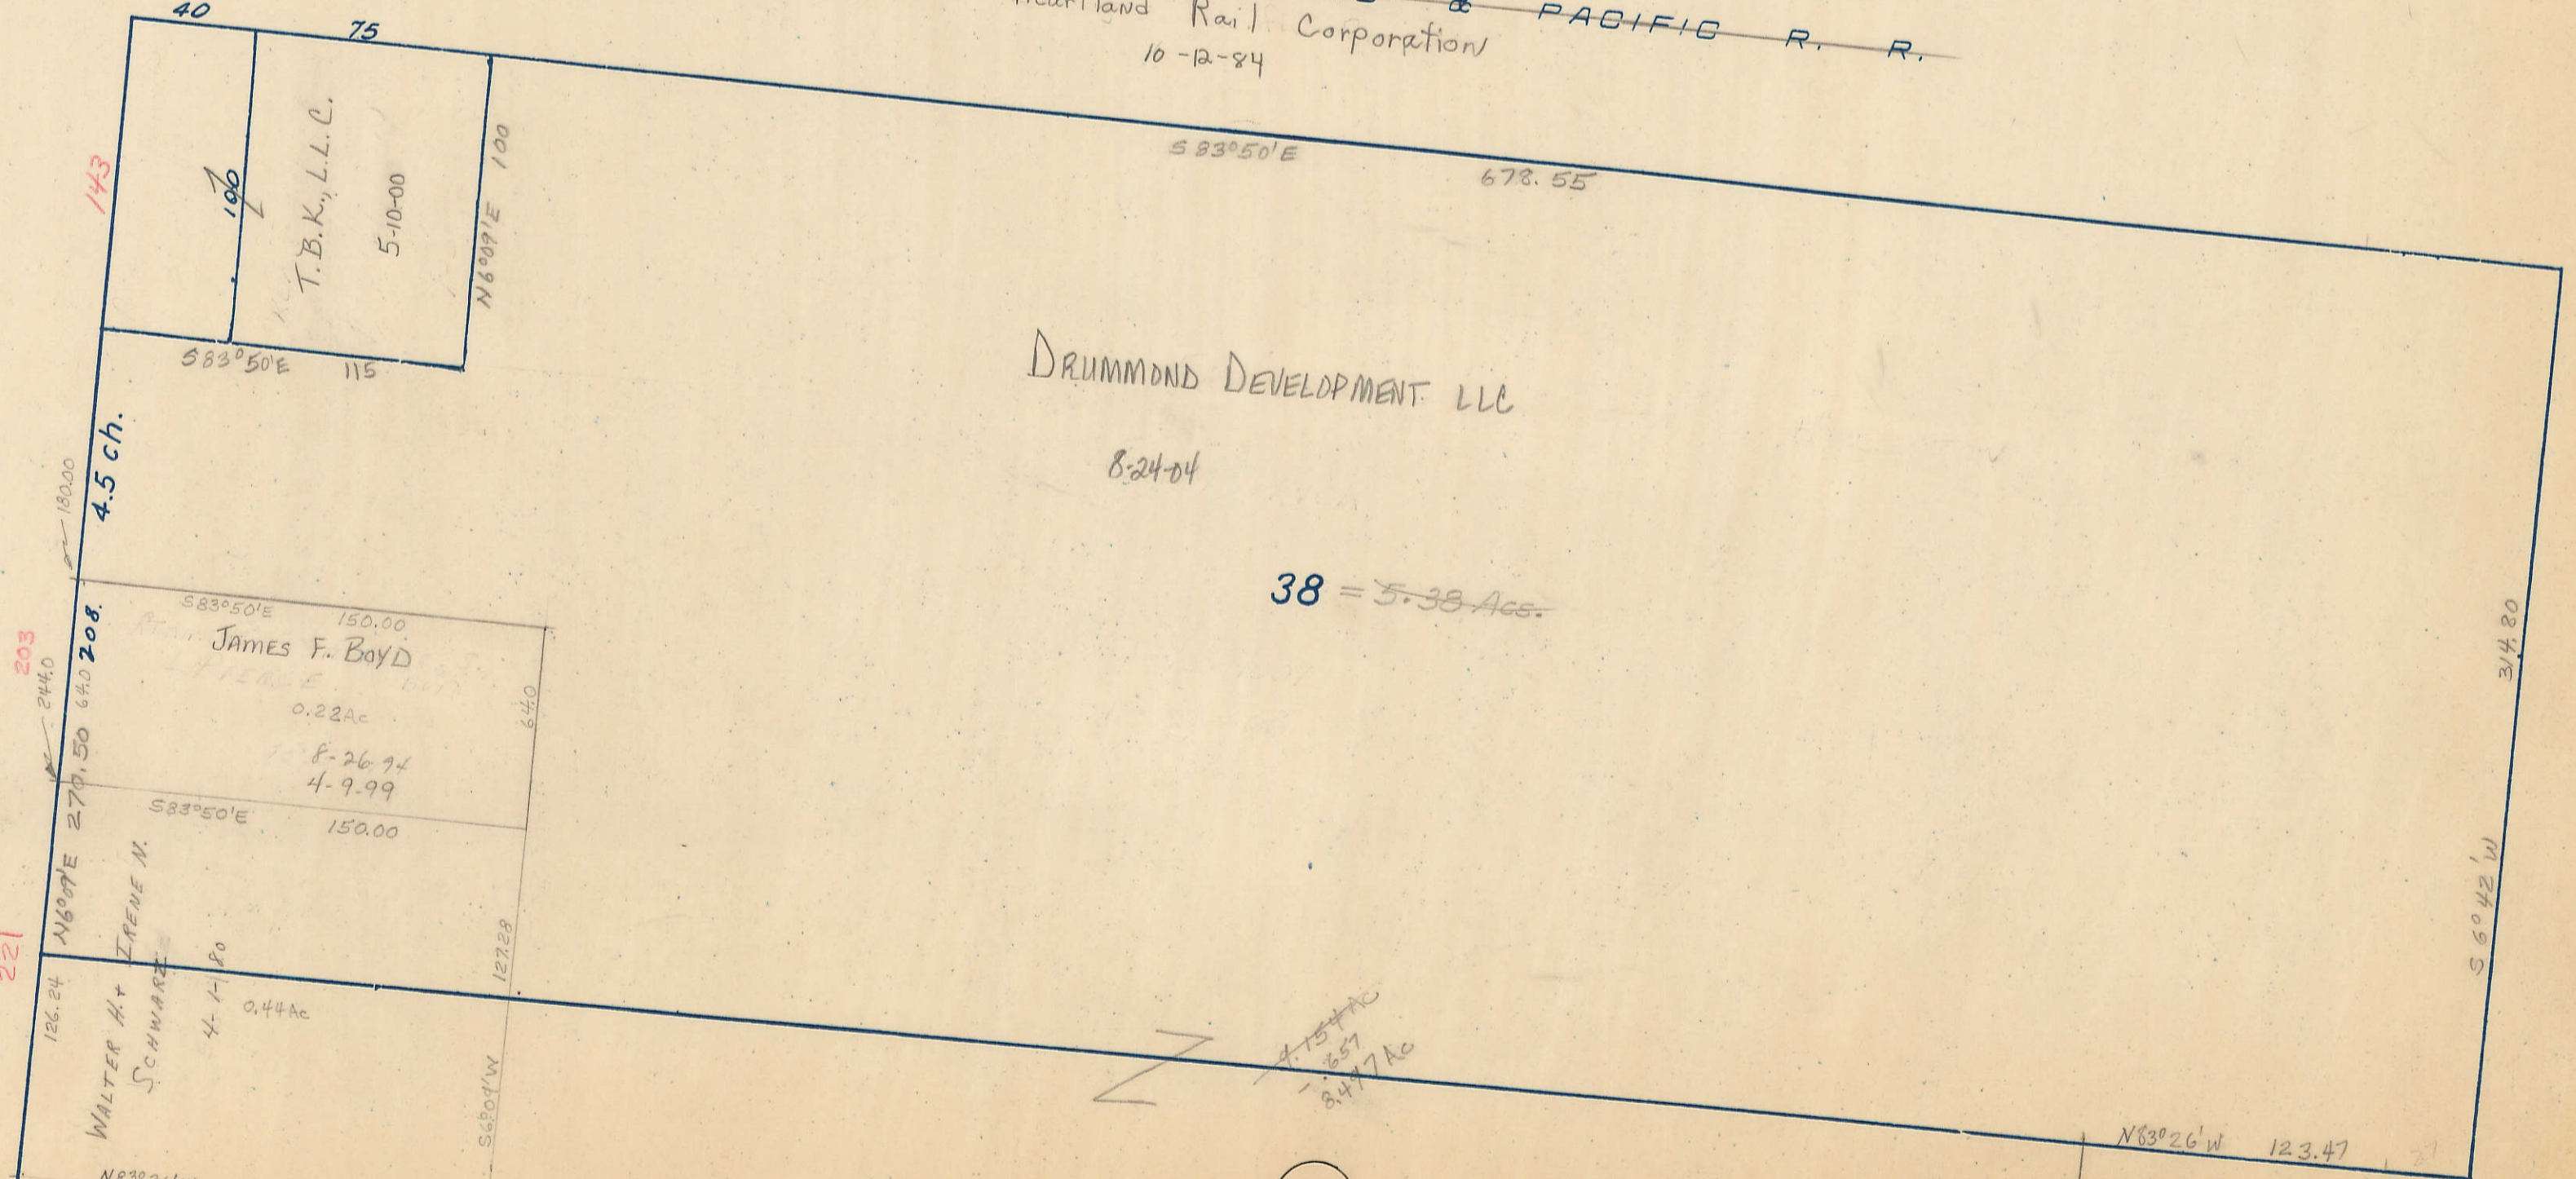

Transfer Page 180 TL