


NE 1/4, SW 1/4 SEC. 30-79-2
SCALE: 1"=100'

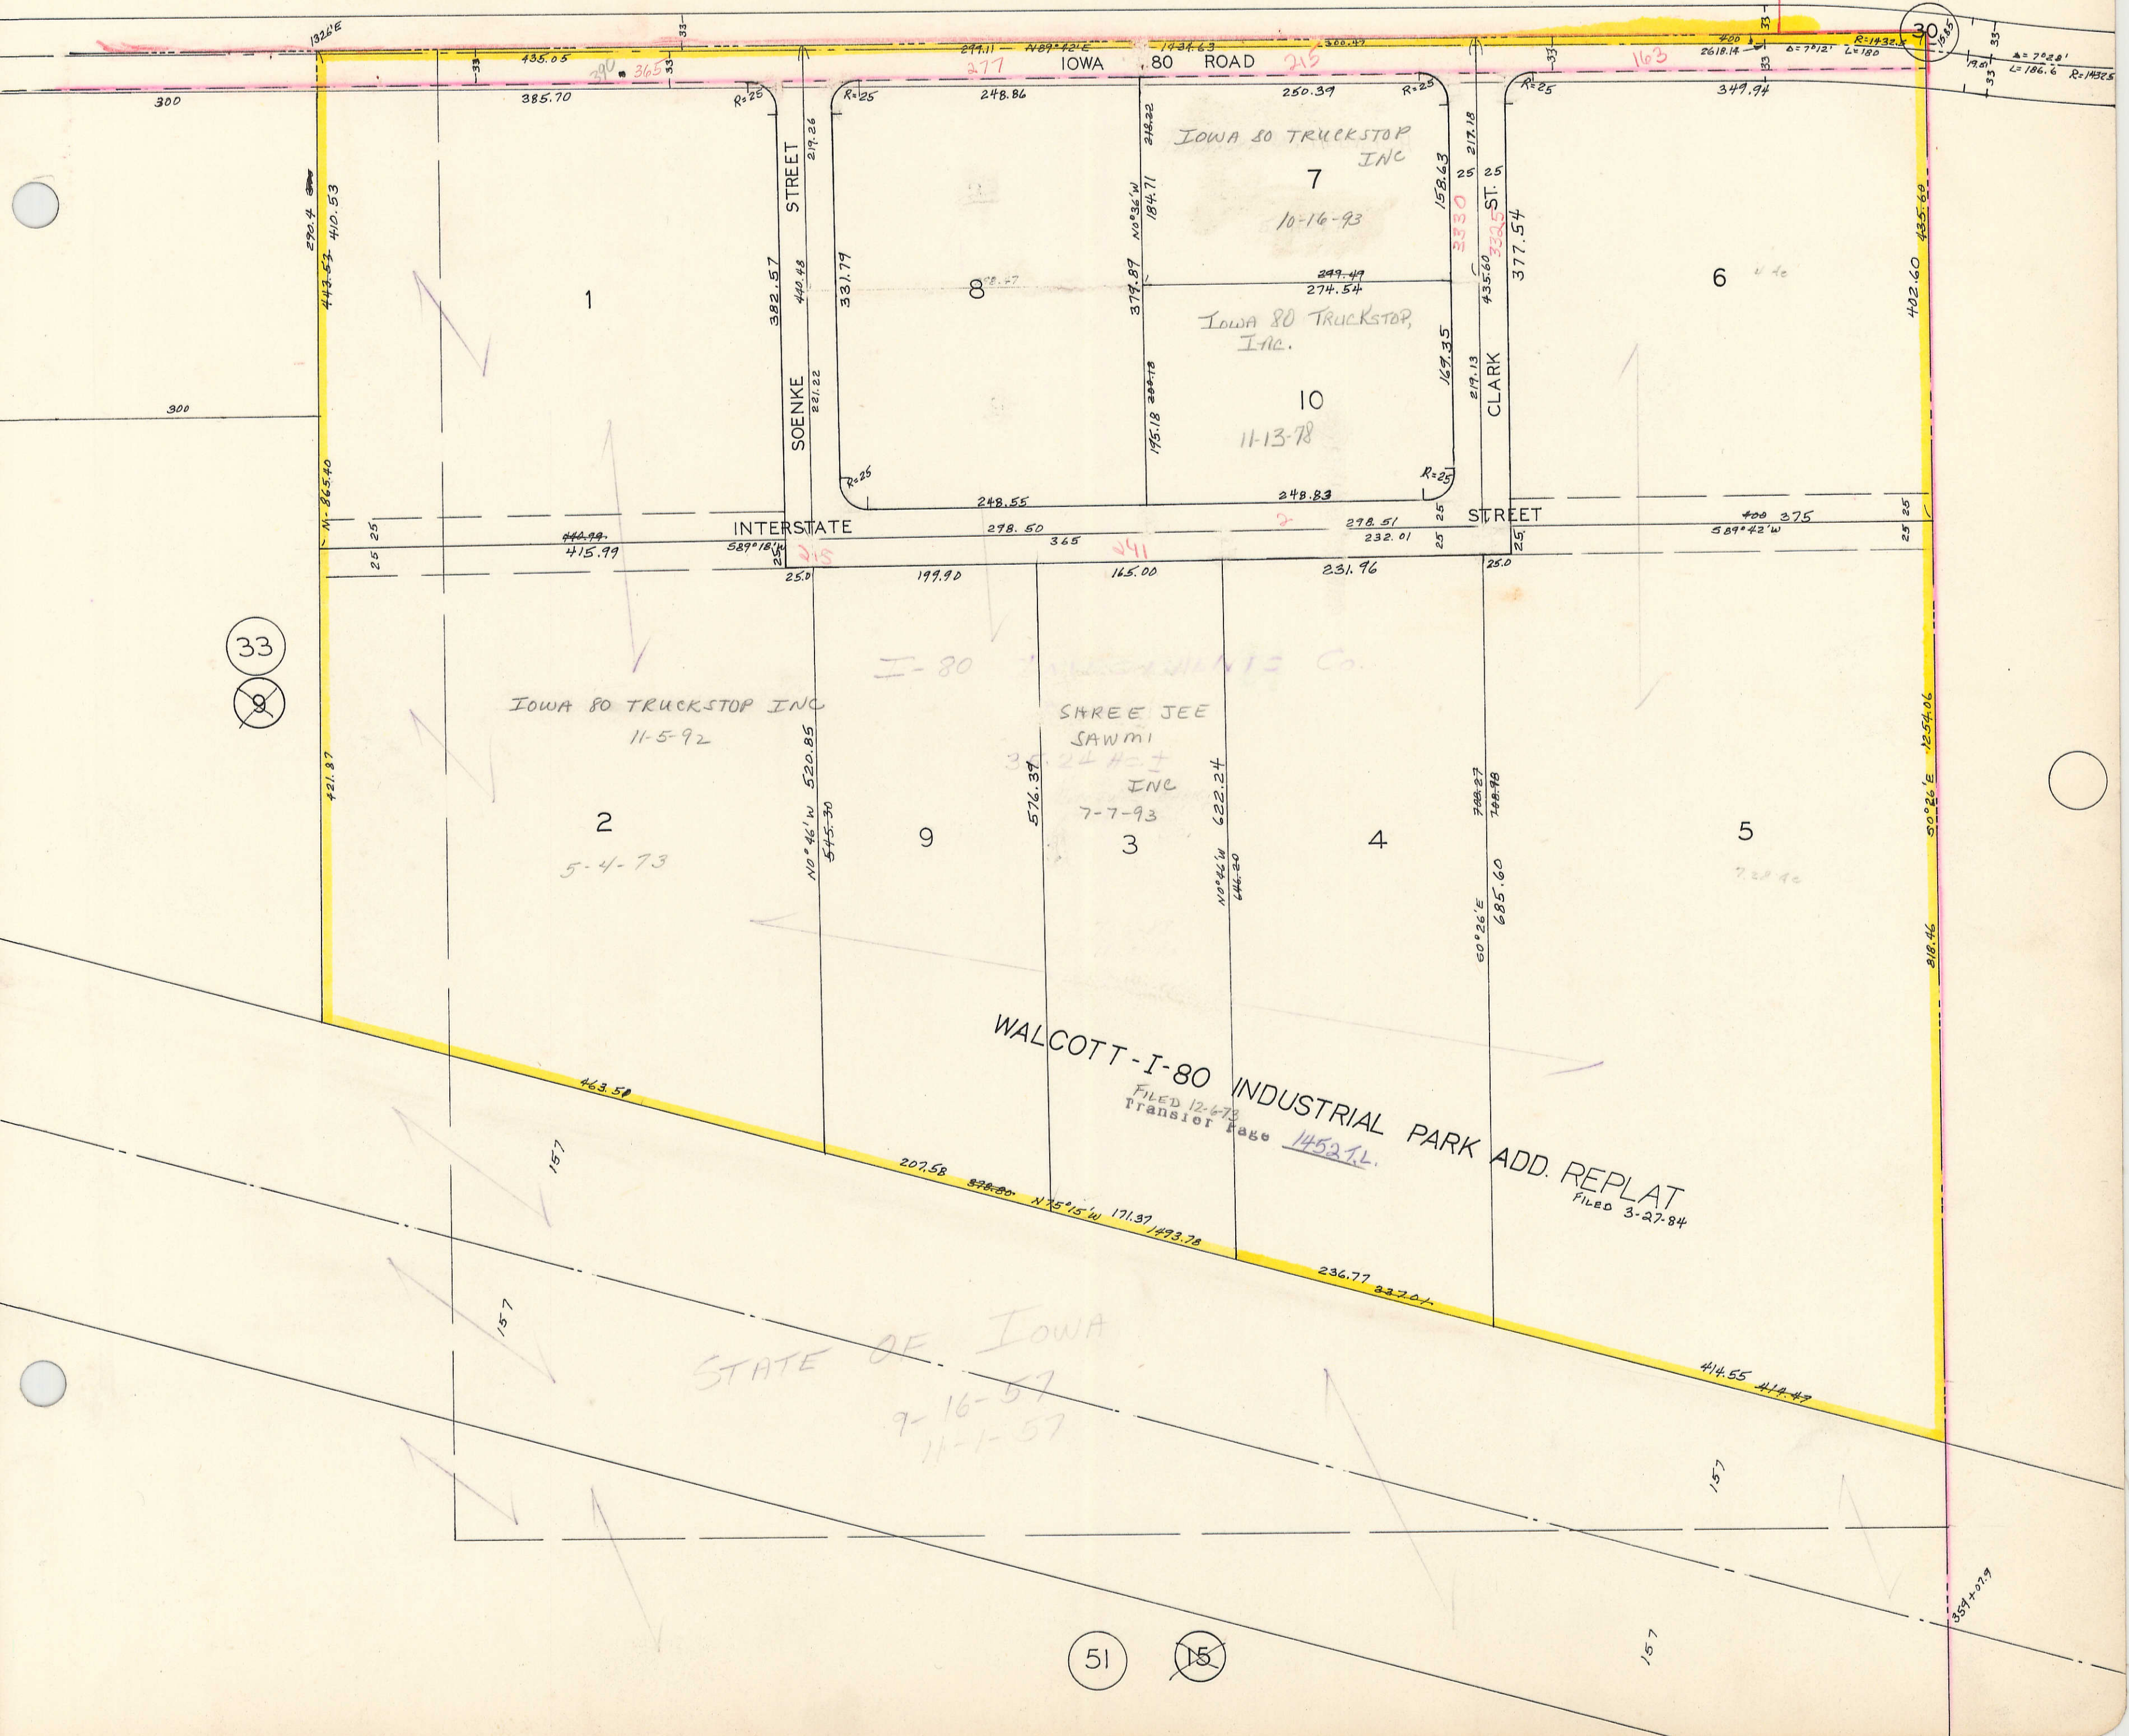

33
9

51

15

157

359+079