

Transfer Page 37 LANDS

7


21

DANA RAY DENKLAU
7-25-91

780 E. James

39

40

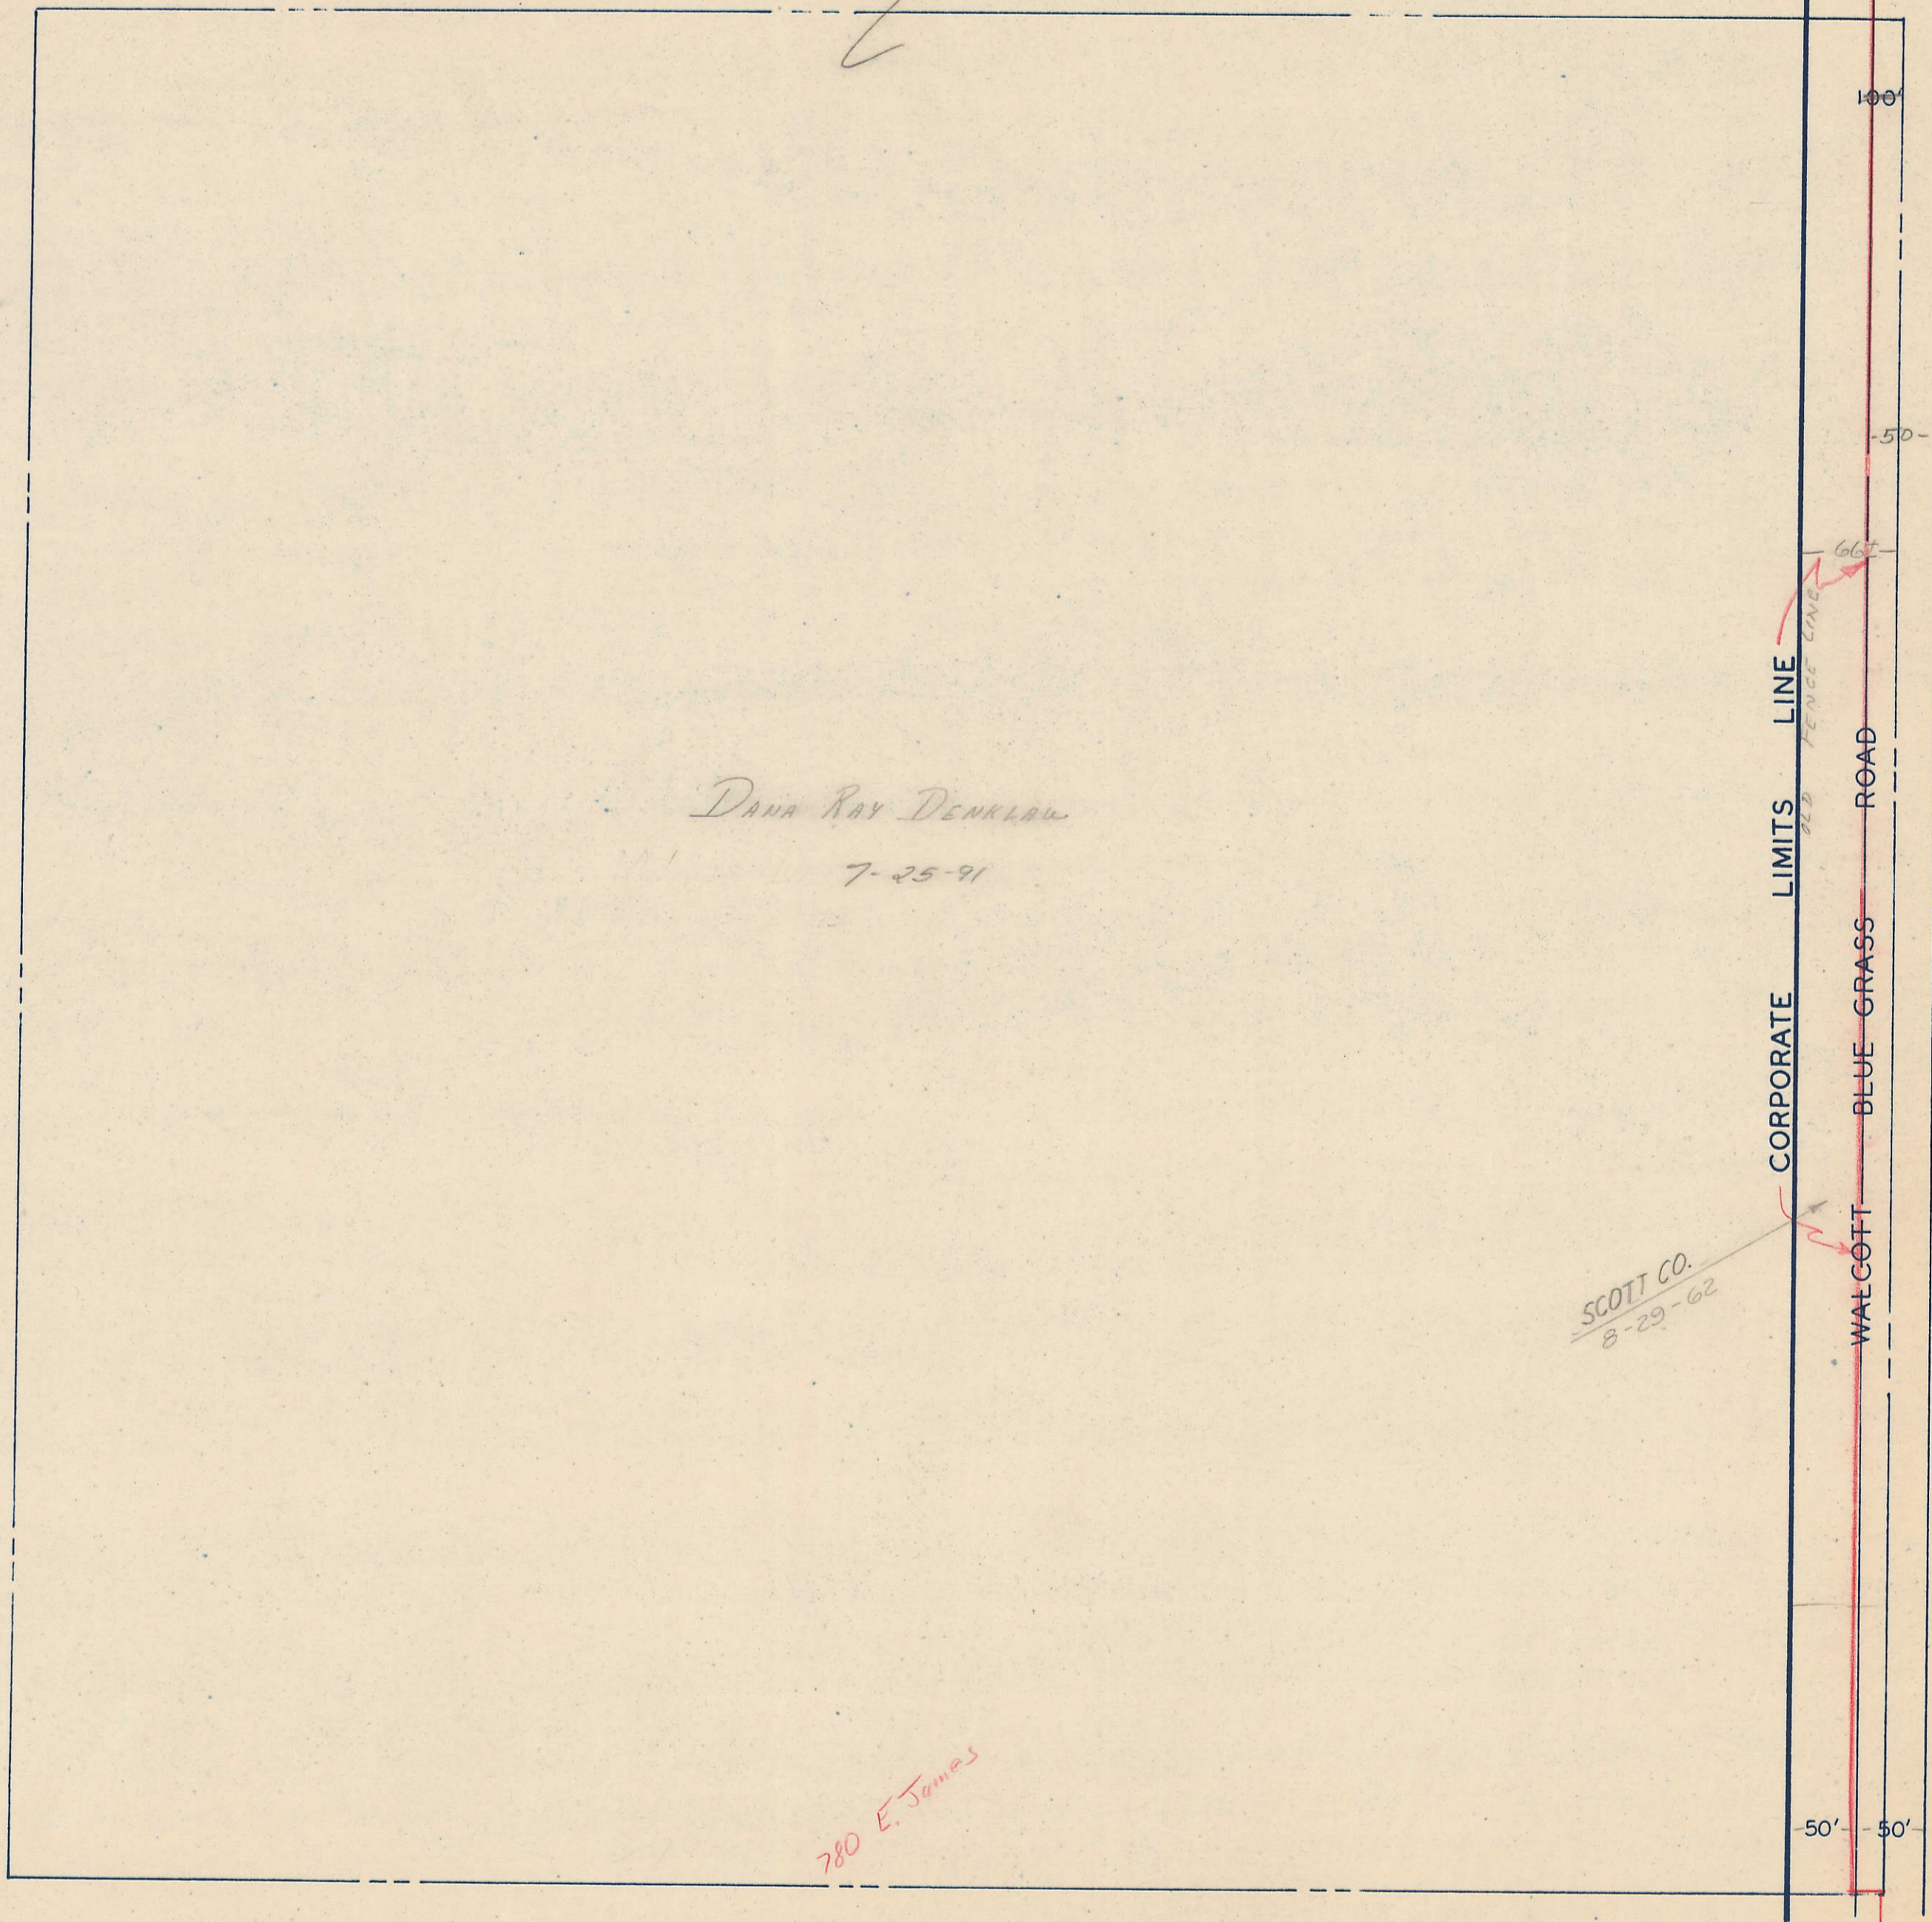

5 SEC. 5
BLUE GRASS TWP.