


① Transfer Page 38 LAND

FULTON TWP.  
MUSCATINE COUNTY

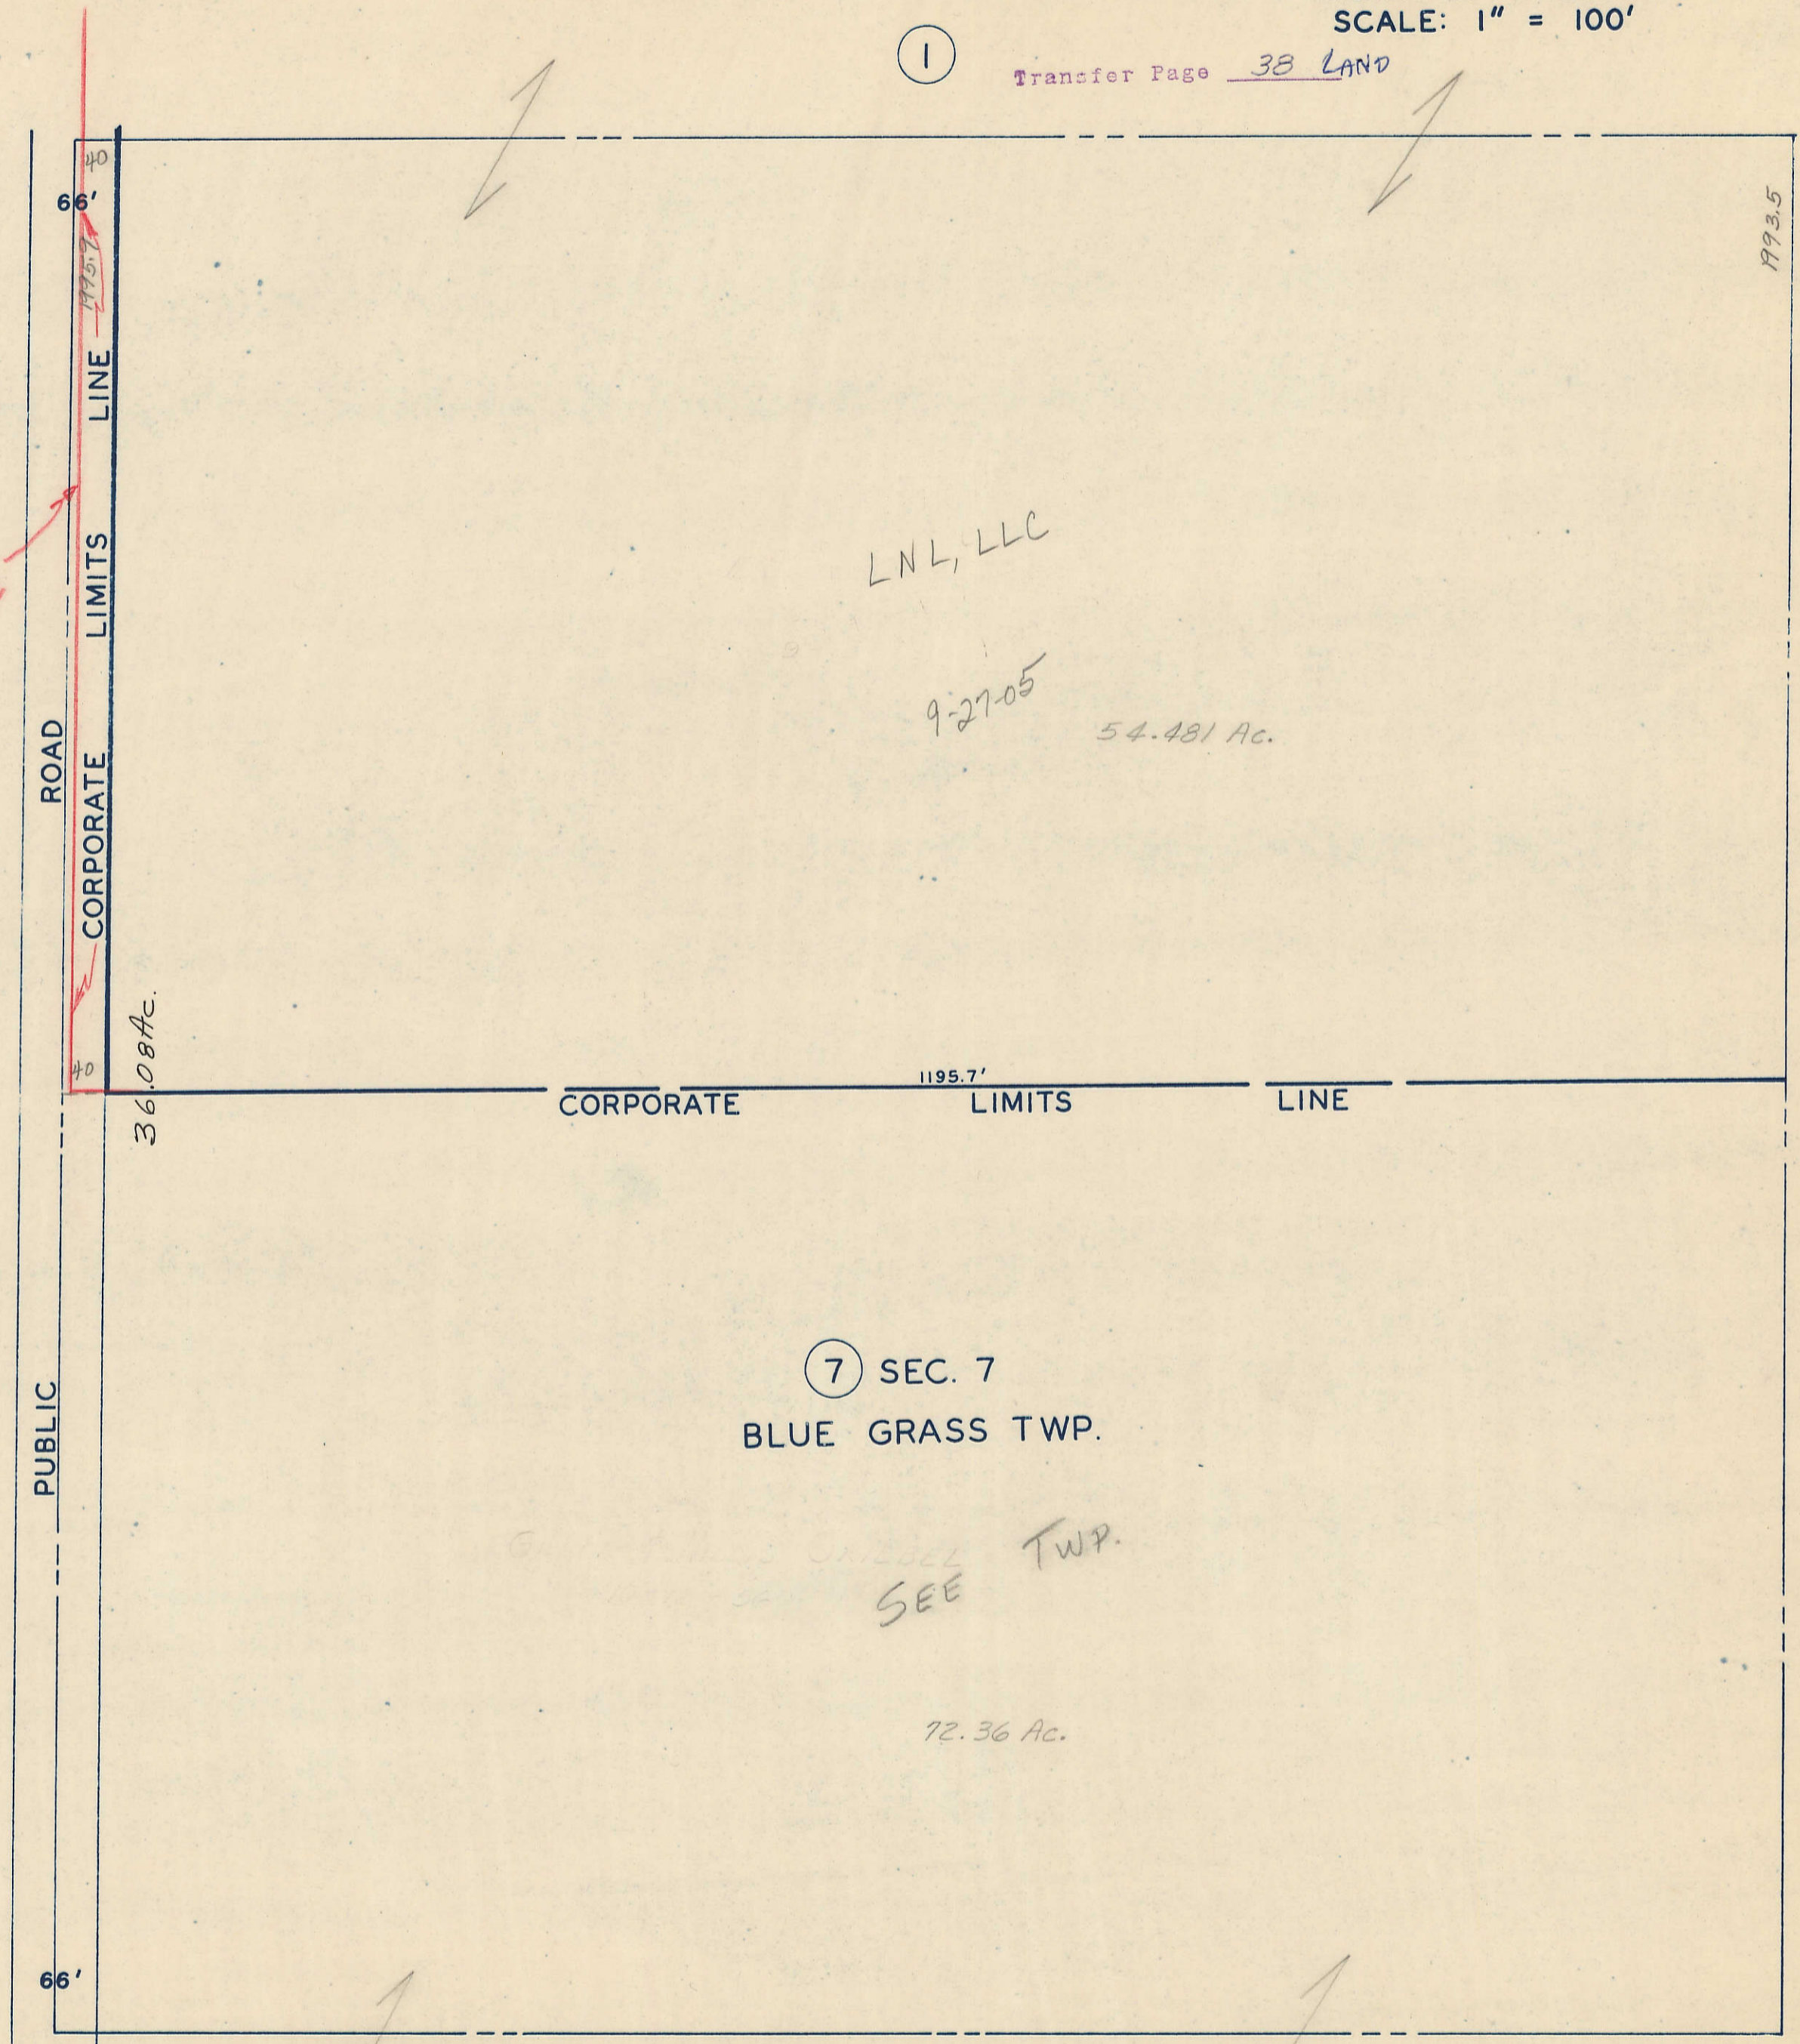

①9

⑦ SEC. 7  
BLUE GRASS TWP.

SEE TWP.

72.36 Ac.

LNL, LLC

9-27-05

54.481 Ac.

66'

66'

1993.5

36.08 Ac.

CORPORATE LIMITS LINE

ROAD

CORPORATE LIMITS LINE

LIMITS

PUBLIC

























