FRACTIONAL NE¼-32-78-4 62
CITY OF BETTENDORF
SCALE: 1 IN. = 100 FT.

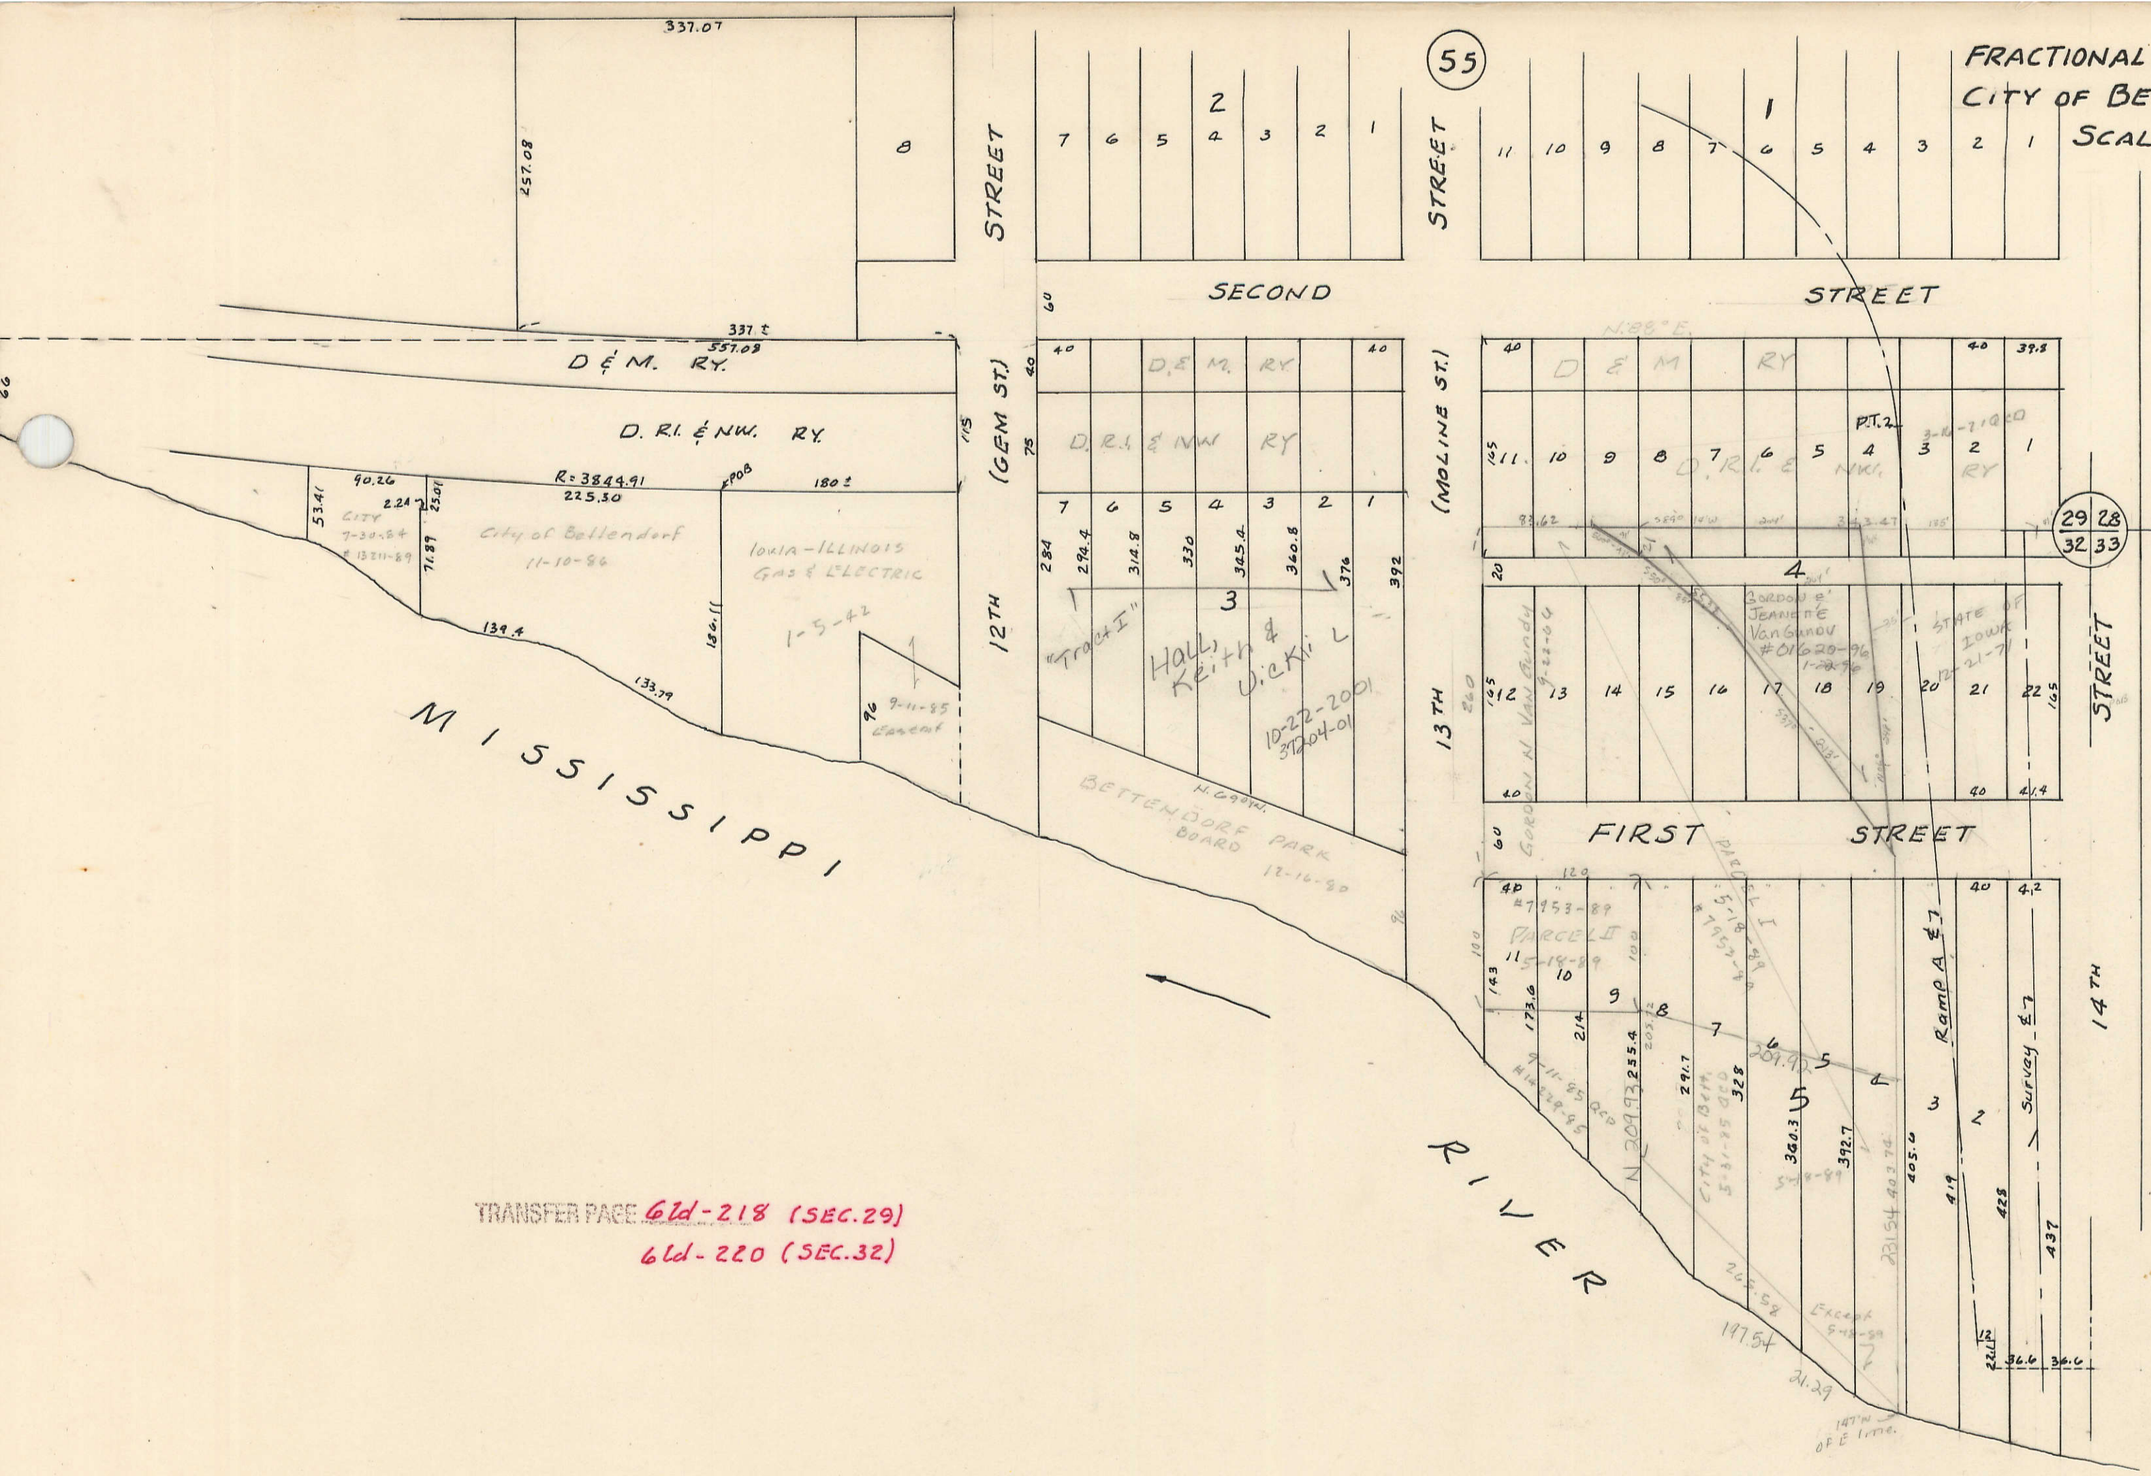

TRANSFER PAGE 6ld-218 (SEC. 29)
6ld-220 (SEC. 32)

BETT. VOL. A, SEC. 32, PG. 62