

VOLUME B
CITY OF
BETTENDORF, IOWA
SECTIONS 28 & 33 T78N, R4E.

Scale 1"=500'



*See p. 33A
(in back of book)*


I-74

29 28
32 33

28 27
33 34

20 21
29 28

21 22
28 27

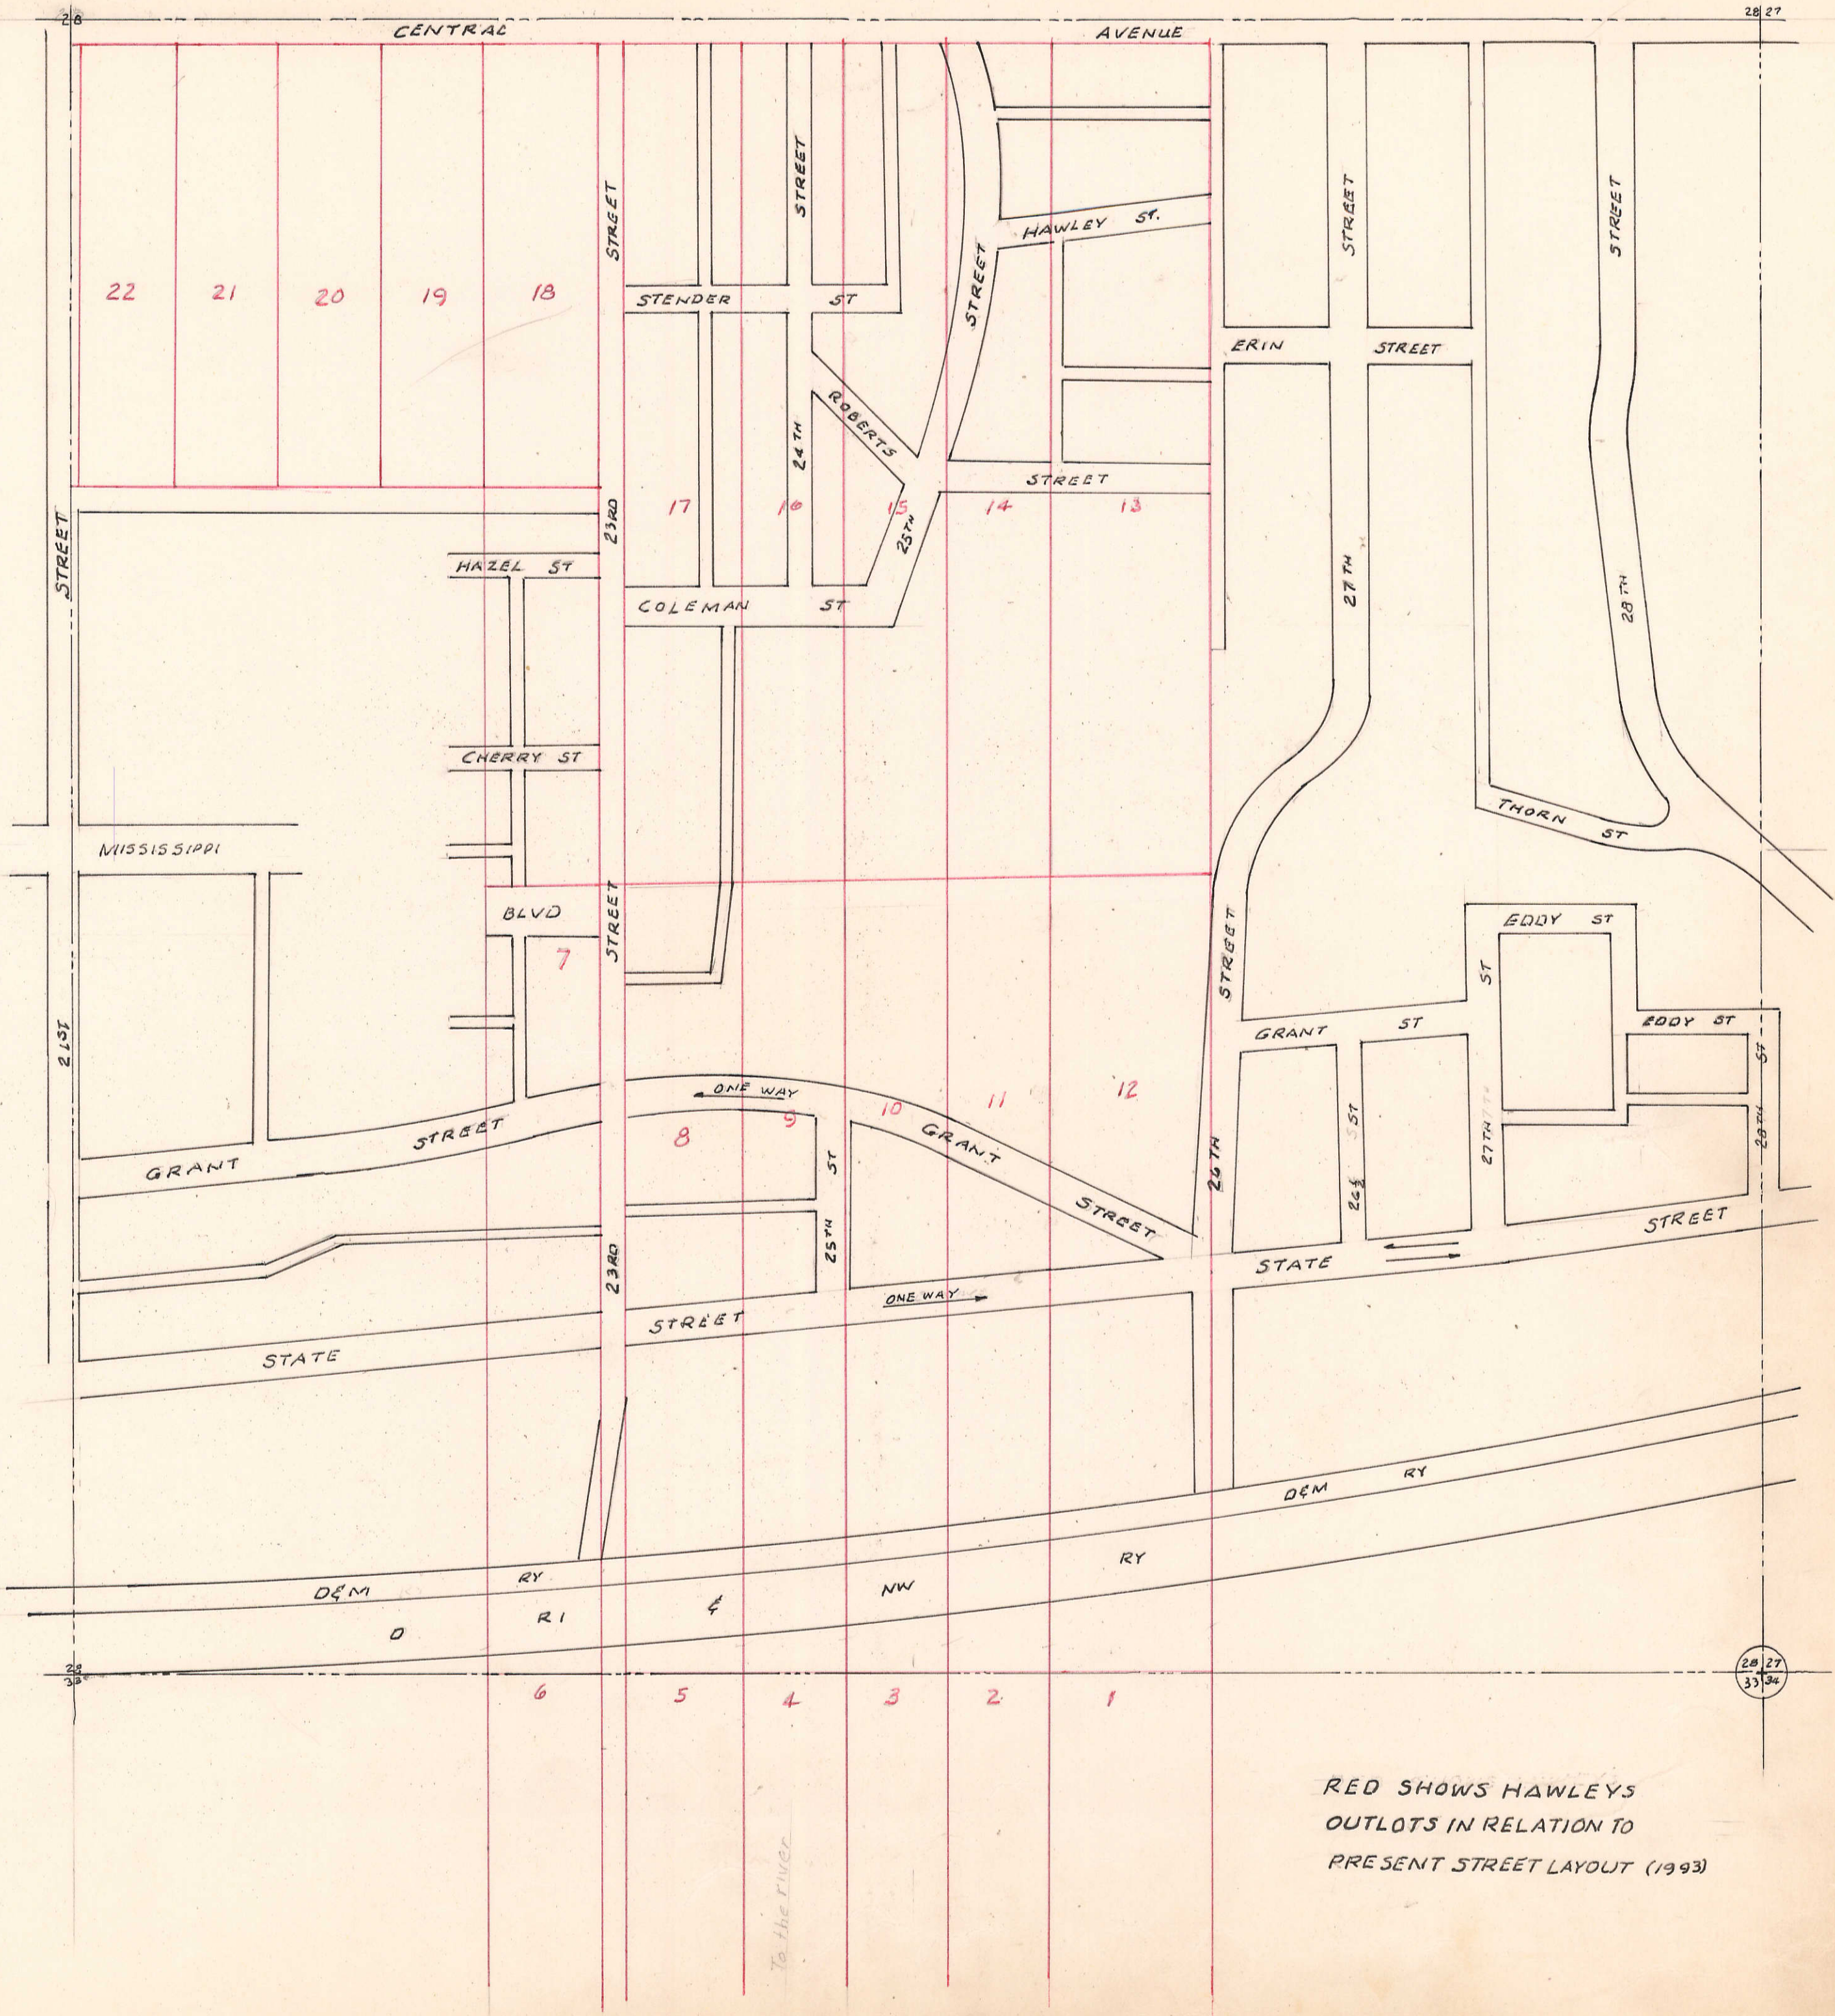

RED SHOWS HAWLEYS
 OUTLOTS IN RELATION TO
 PRESENT STREET LAYOUT (1993)

To the river