


TRANSFER PAGE 237L-1931

Transfer Page 187L-1160

Transfer Page 61ds-216

187L-1129(27-30)
187L-1130(31-45)

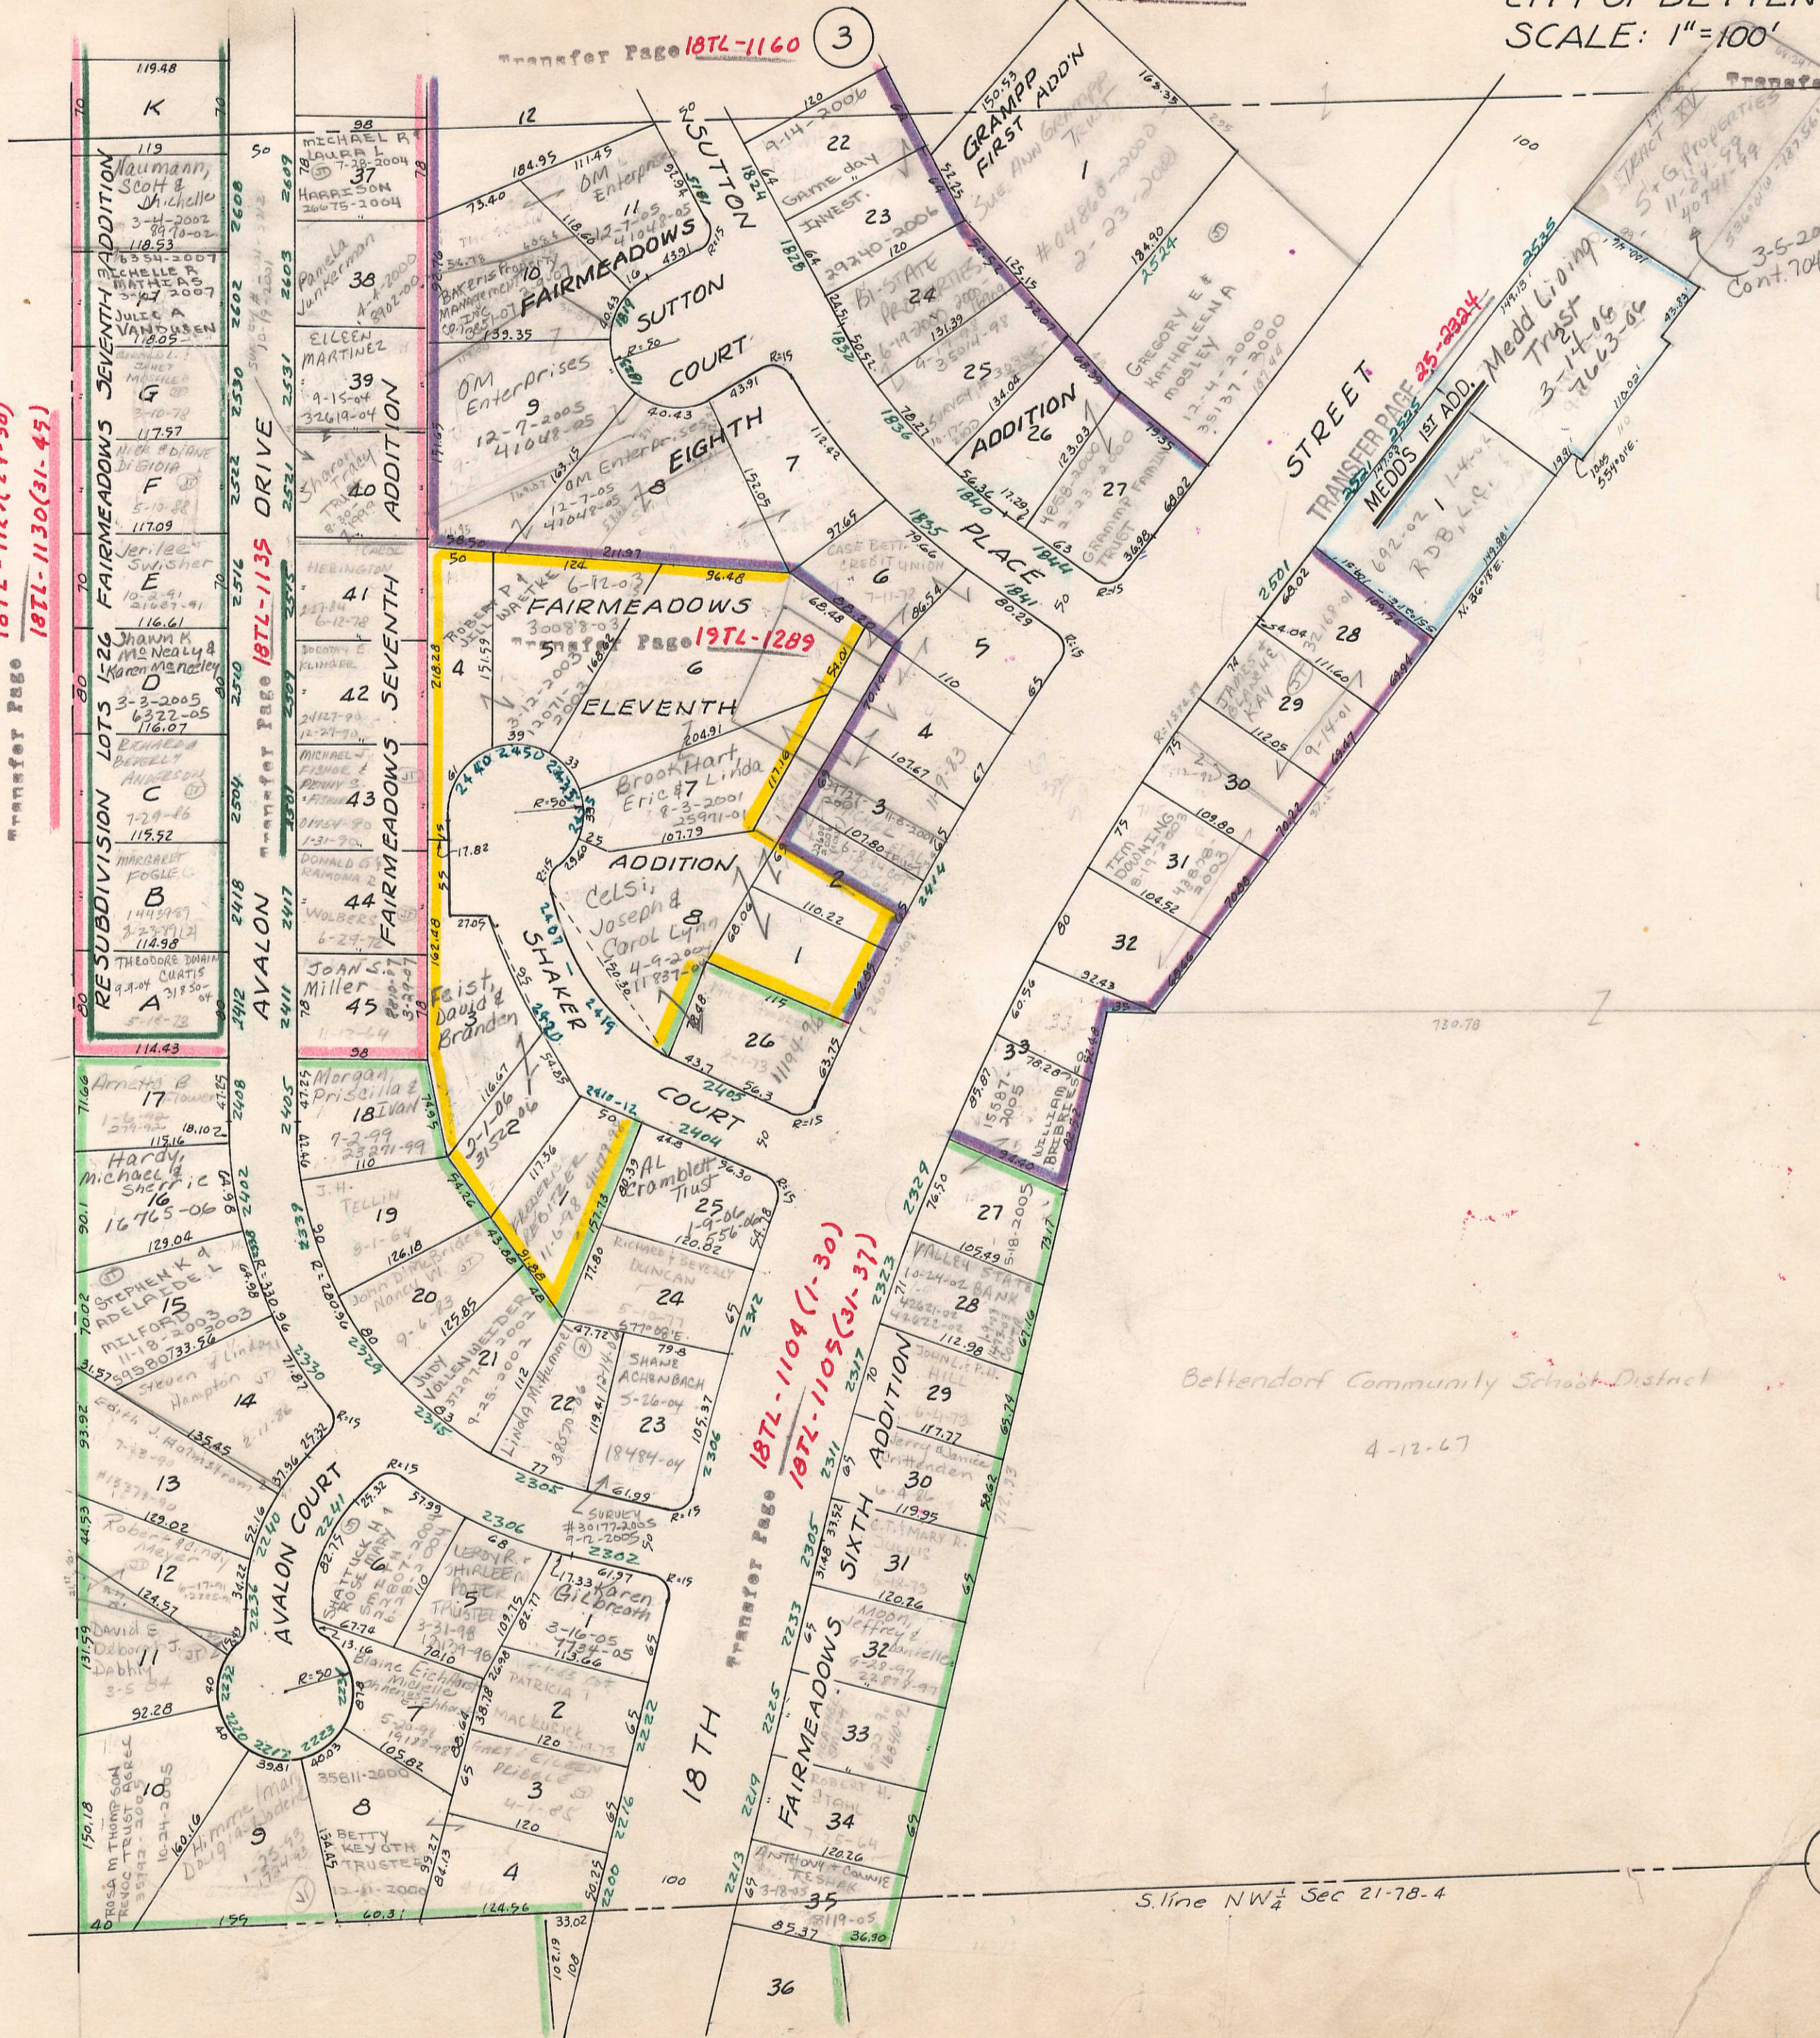

17

21

E. line NW 1/4 Sec 21-78-4

Bettendorf Community School District

4-12-67

S. line NW 1/4 Sec 21-78-4

2-1

Center Sec 21-78-4

35