


Transfer Page 7lds-361

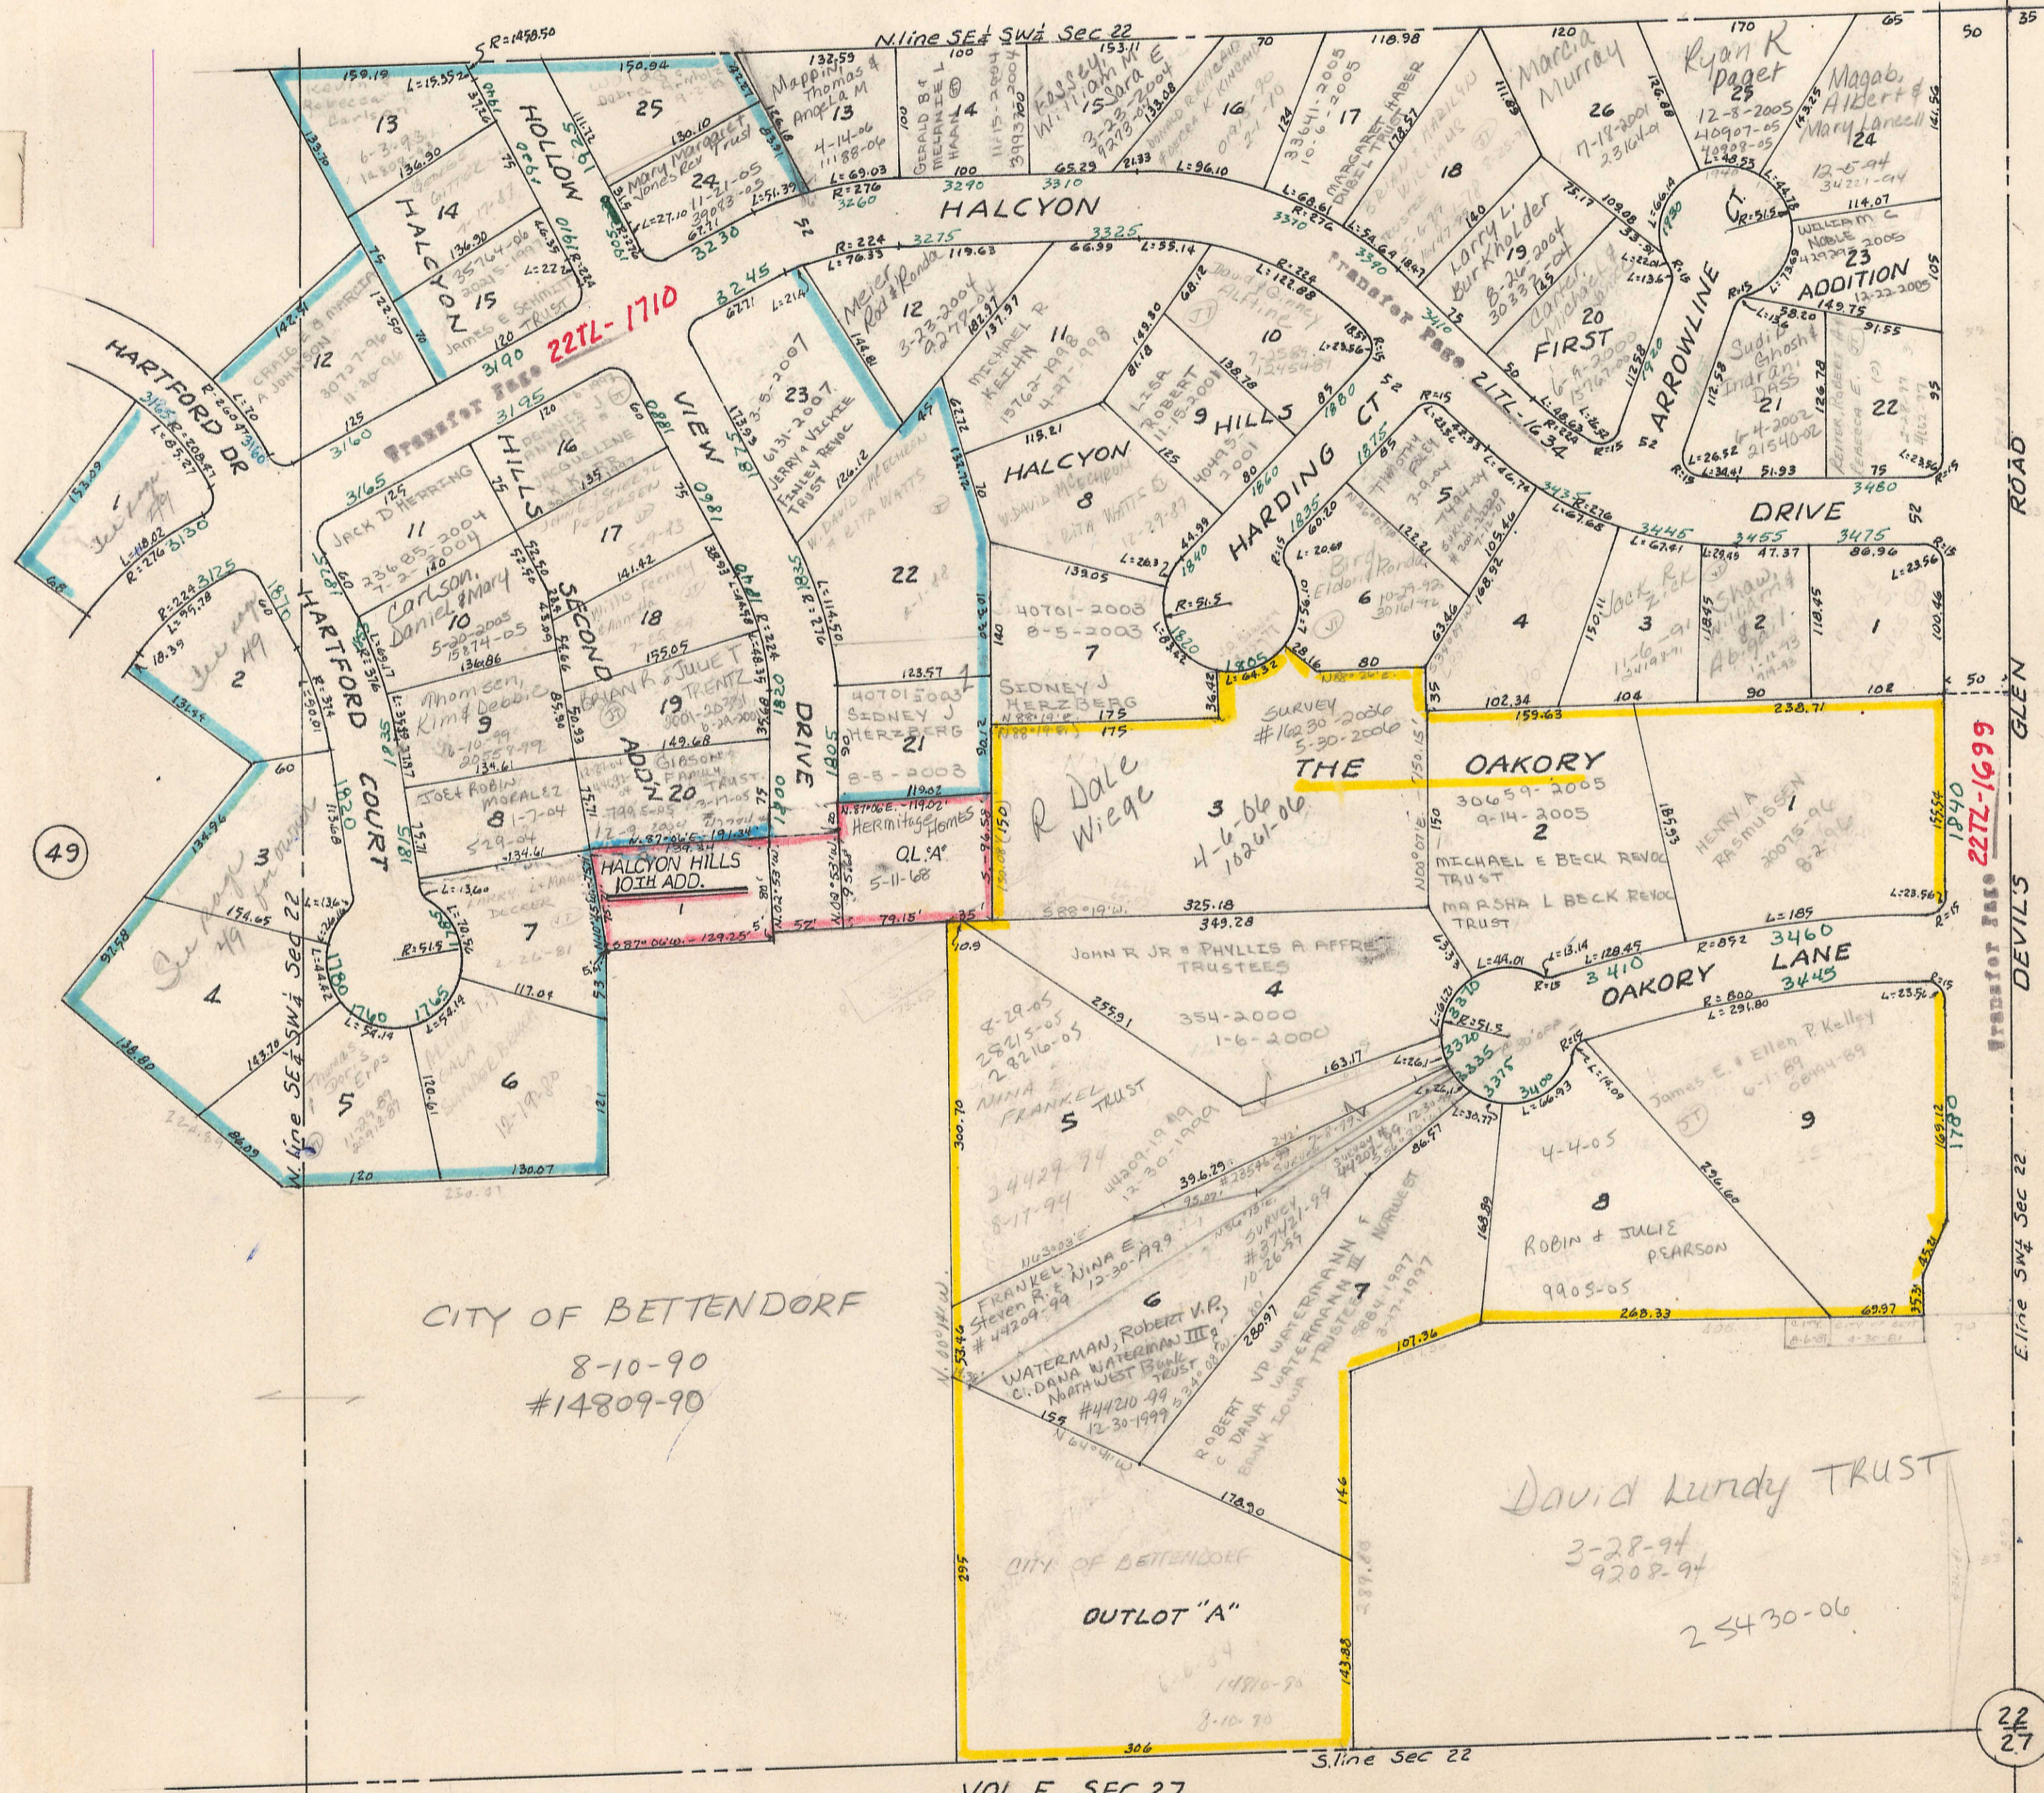

CITY OF BETTENDORF
8-10-90
#14809-90

David Lurdy TRUST
3-28-94
9208-94
2-5430-06

VOL F SEC 27

3/4 Corner Sec 22