


37

DEERBROOK ESTATES 2ND ADD. DEERBROOK ESTATES 3RD ADD.

REPLAT #00132-88

TRANSFER PAGE 237L-1901

TRANSFER PAGE 237L-1927

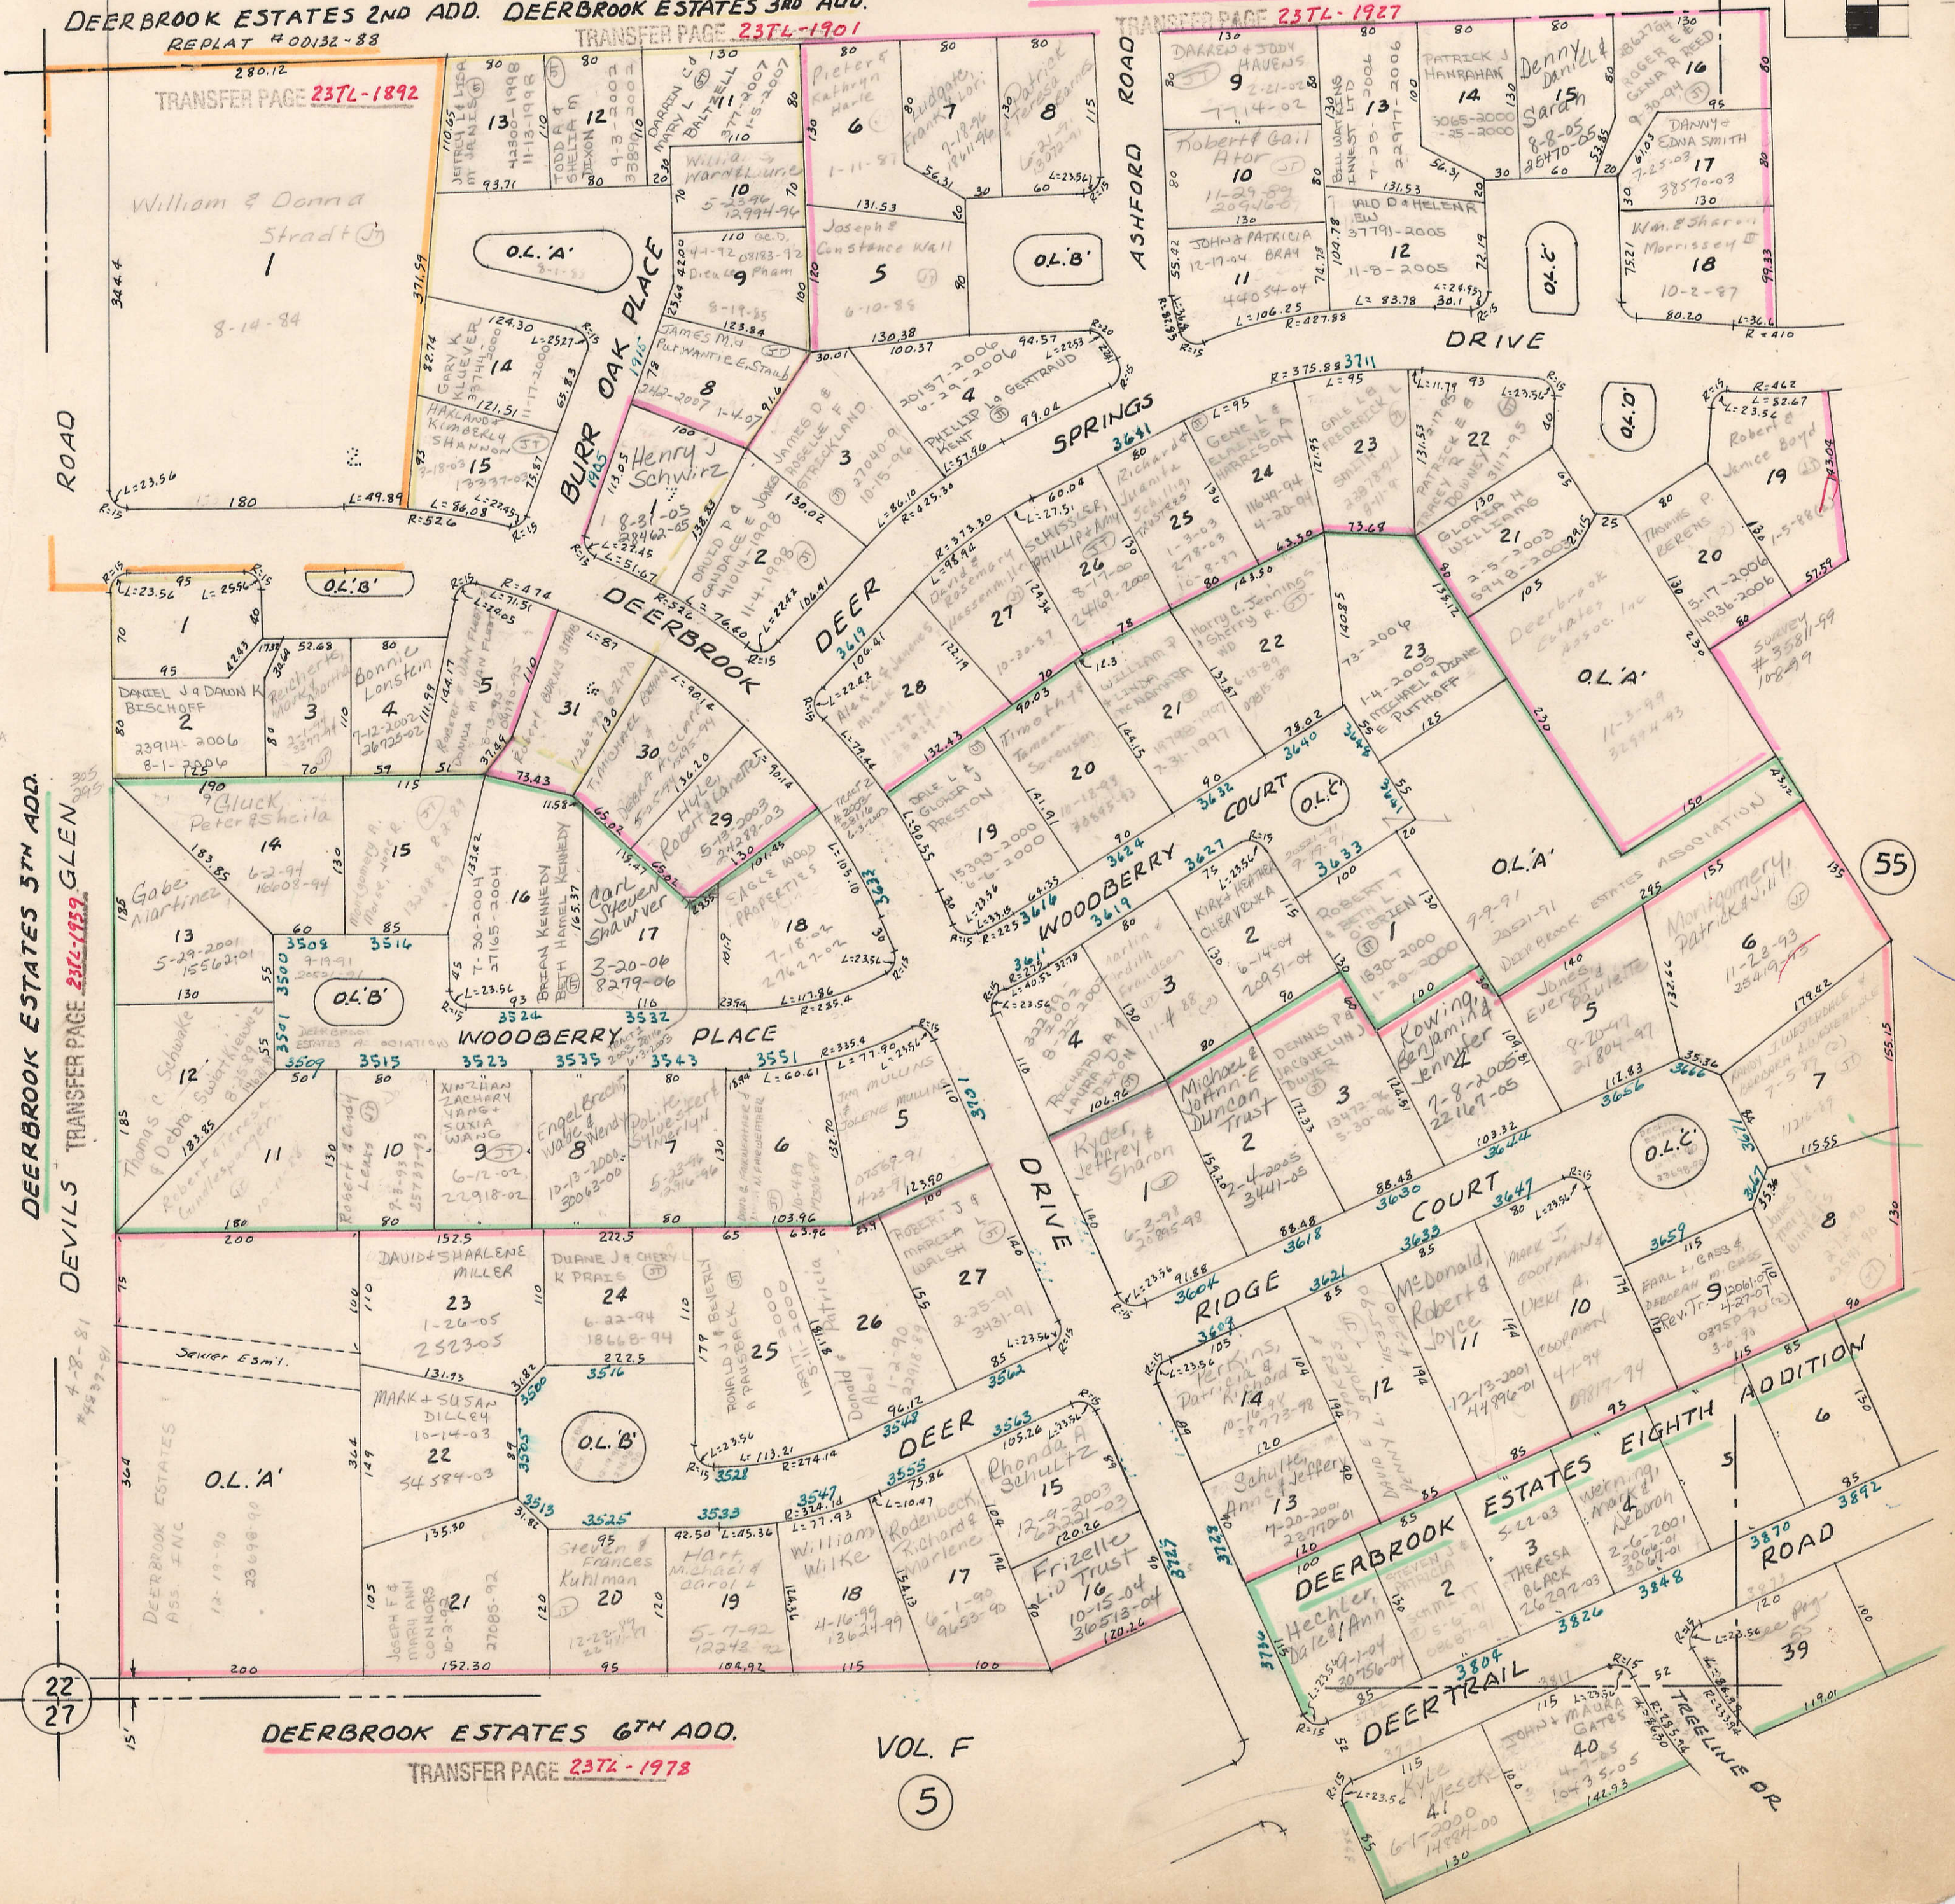

DEERBROOK ESTATES 6TH ADD.

TRANSFER PAGE 237L-1978

VOL. F

5

22  
27

51

55