
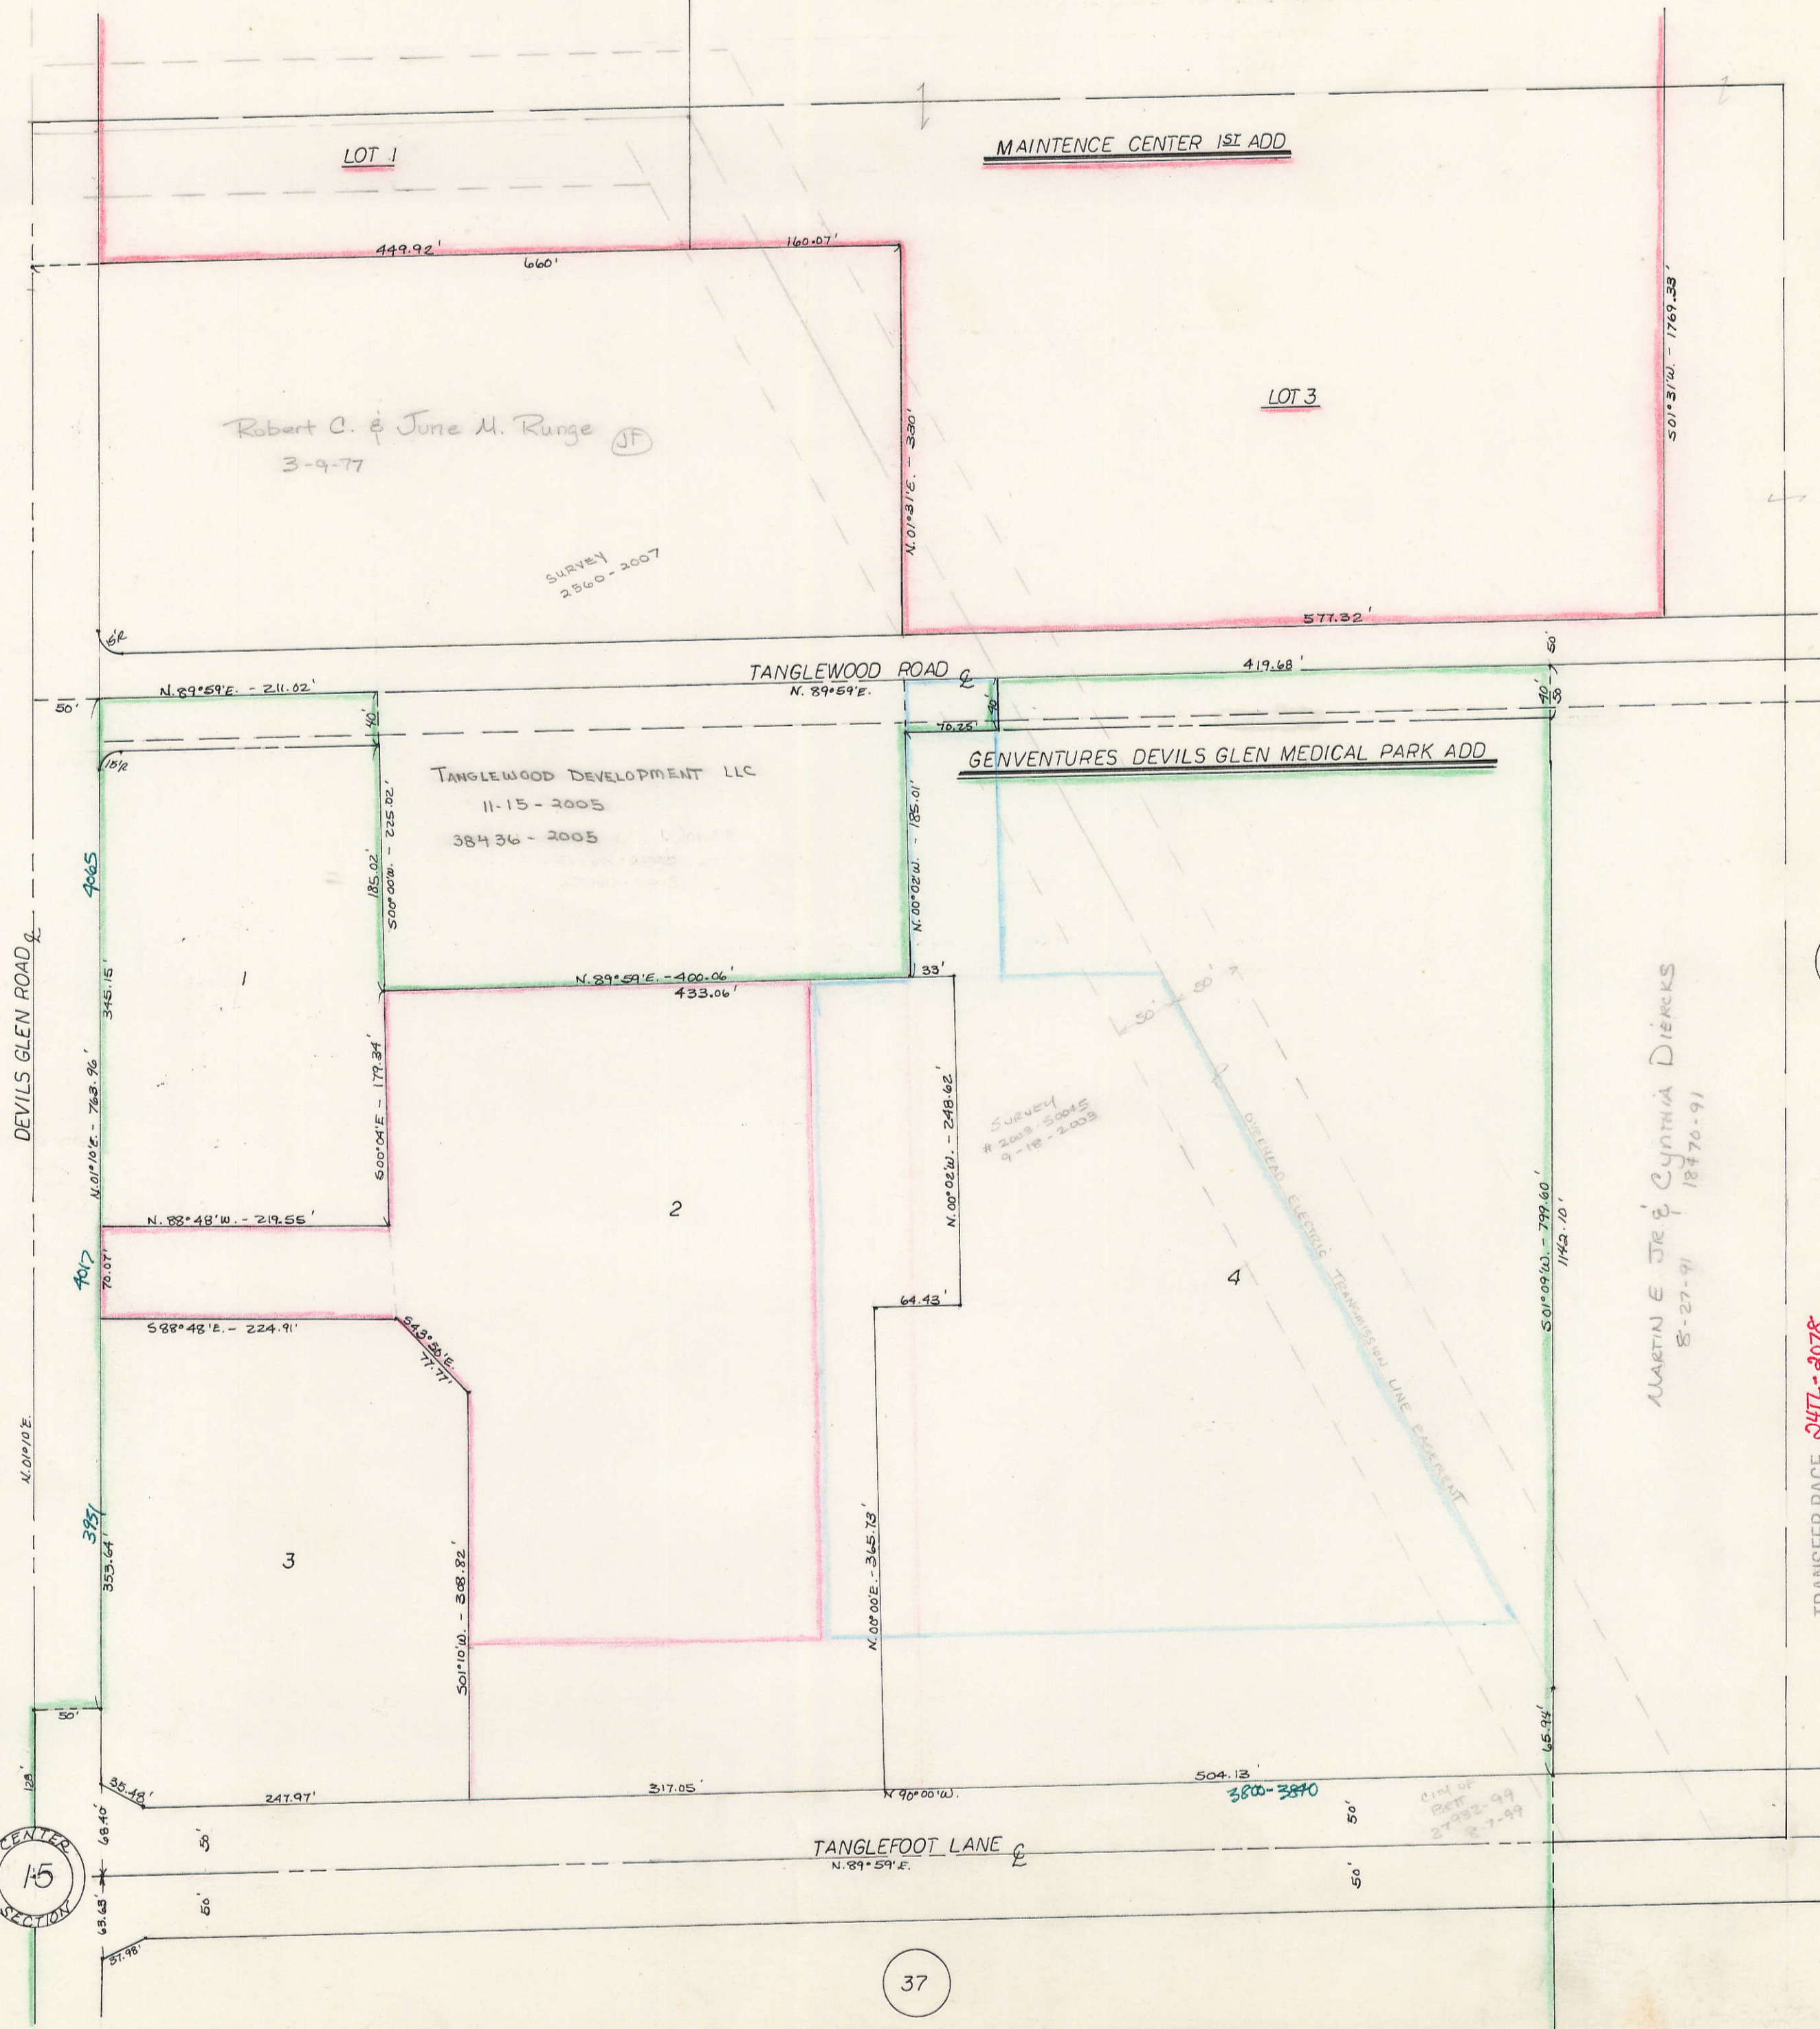


TRANSFER PAGE 71d-360

5

TRANSFER PAGE

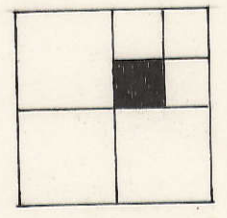

19

BLANKS TO:
DAVIED, INC.
3-5-92
5426-92
23-499-91
10-24-91

23

TRANSFER PAGE 247L-2078
(BETTENDORF MEDICAL CENTER 1ST ADD.)
TRANSFER PAGE 247L-2110
(BETTENDORF MEDICAL CENTER 2ND ADD.)

CENTER SECTION 15

37