


ASPEN HEIGHTS
TRANSFER PAGE 237L-1875

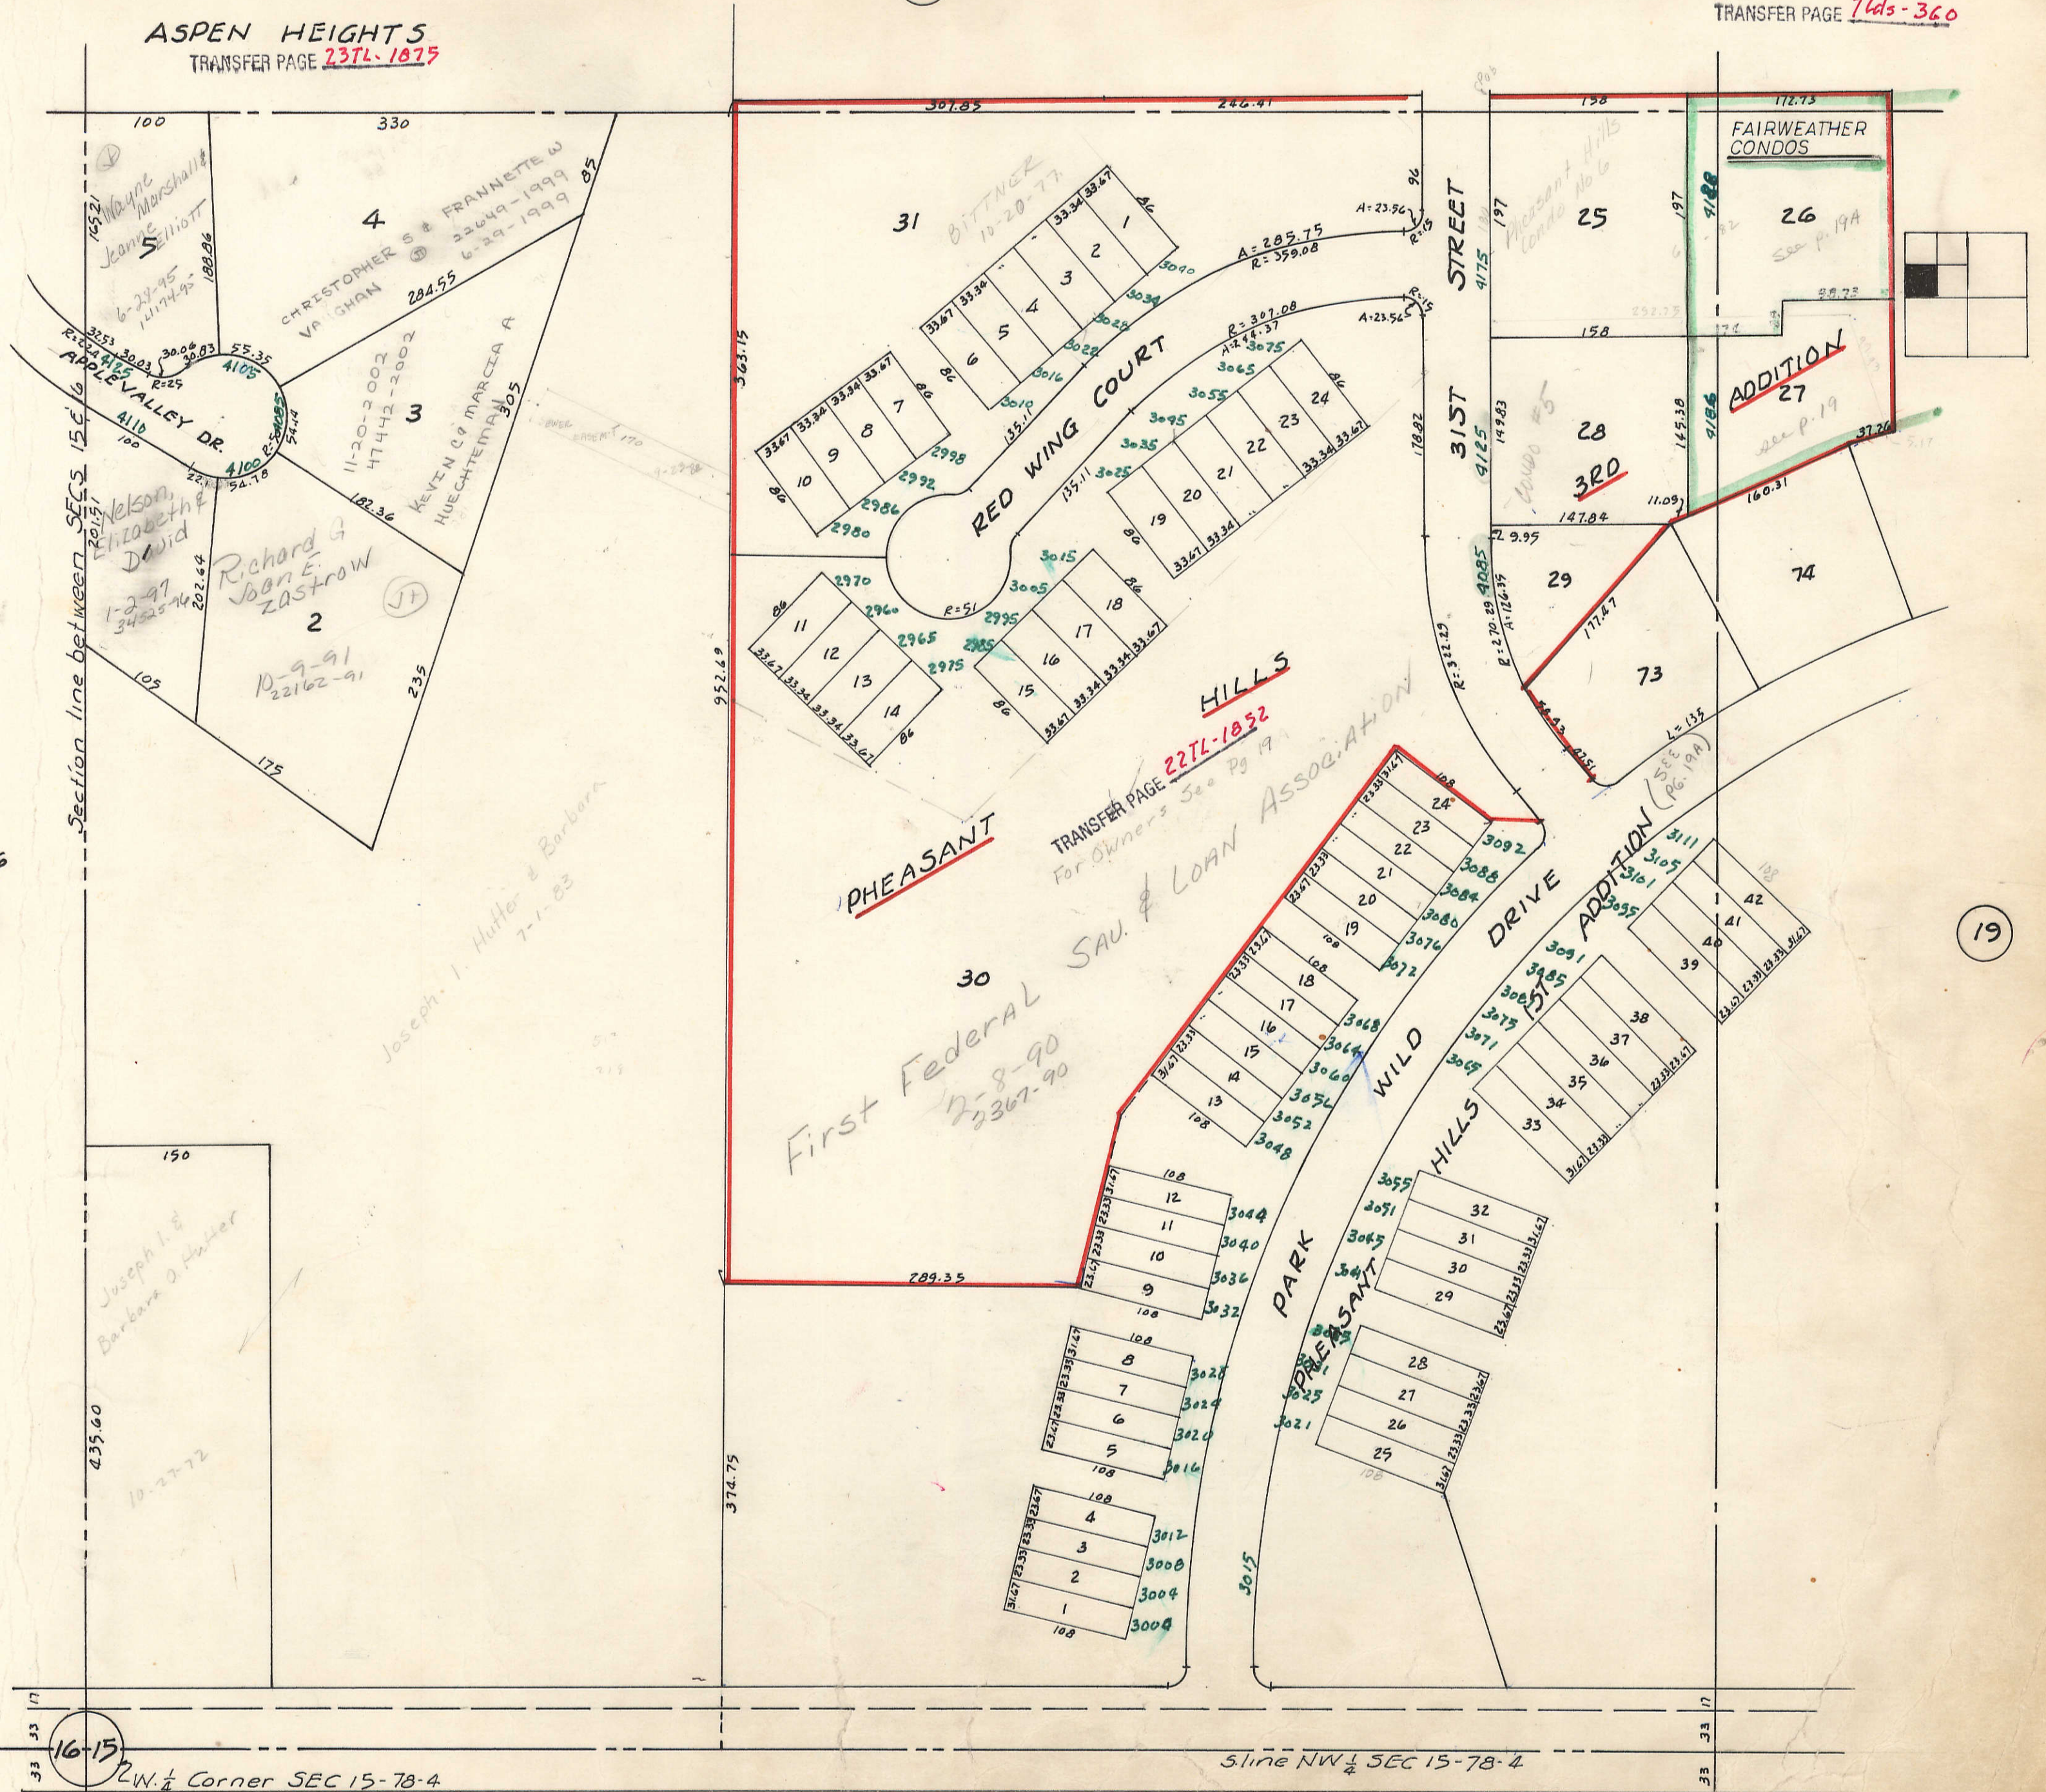

158.21
Wayne Marshall
Jeanne Elliott
6-27-95
1117495-
188.06

4
CHRISTOPHER S & FRANNETTE W VAUGHAN
32649-1999
6-29-1999
284.55

3
11-20-2002
47442-2002
182.36

KEVIN C & MARCIA A HUECHTMAN
305

2
Richard G & Joan E ZASTROW
10-9-91
22162-91
235

150
Joseph I & Barbara J Hutter
10-27-72

31 BITTNER
10-20-77

RED WING COURT

PHEASANT HILLS
TRANSFER PAGE 227L-1852
For Owners See Pg 19

SAV. & LOAN ASSOCIATION

WILD DRIVE

ADDITION 27

ADDITION (SEE PG. 19A)

FAIRWEATHER CONDOS

25
26
28
29
30
31
32
33
34
35
36
37
38
39
40
41
42

SEC 16

23

19

16-15

NW 1/4 Corner SEC 15-78-4

S line NW 1/4 SEC 15-78-4

33