


(21)

Transfer Page 71ds-359

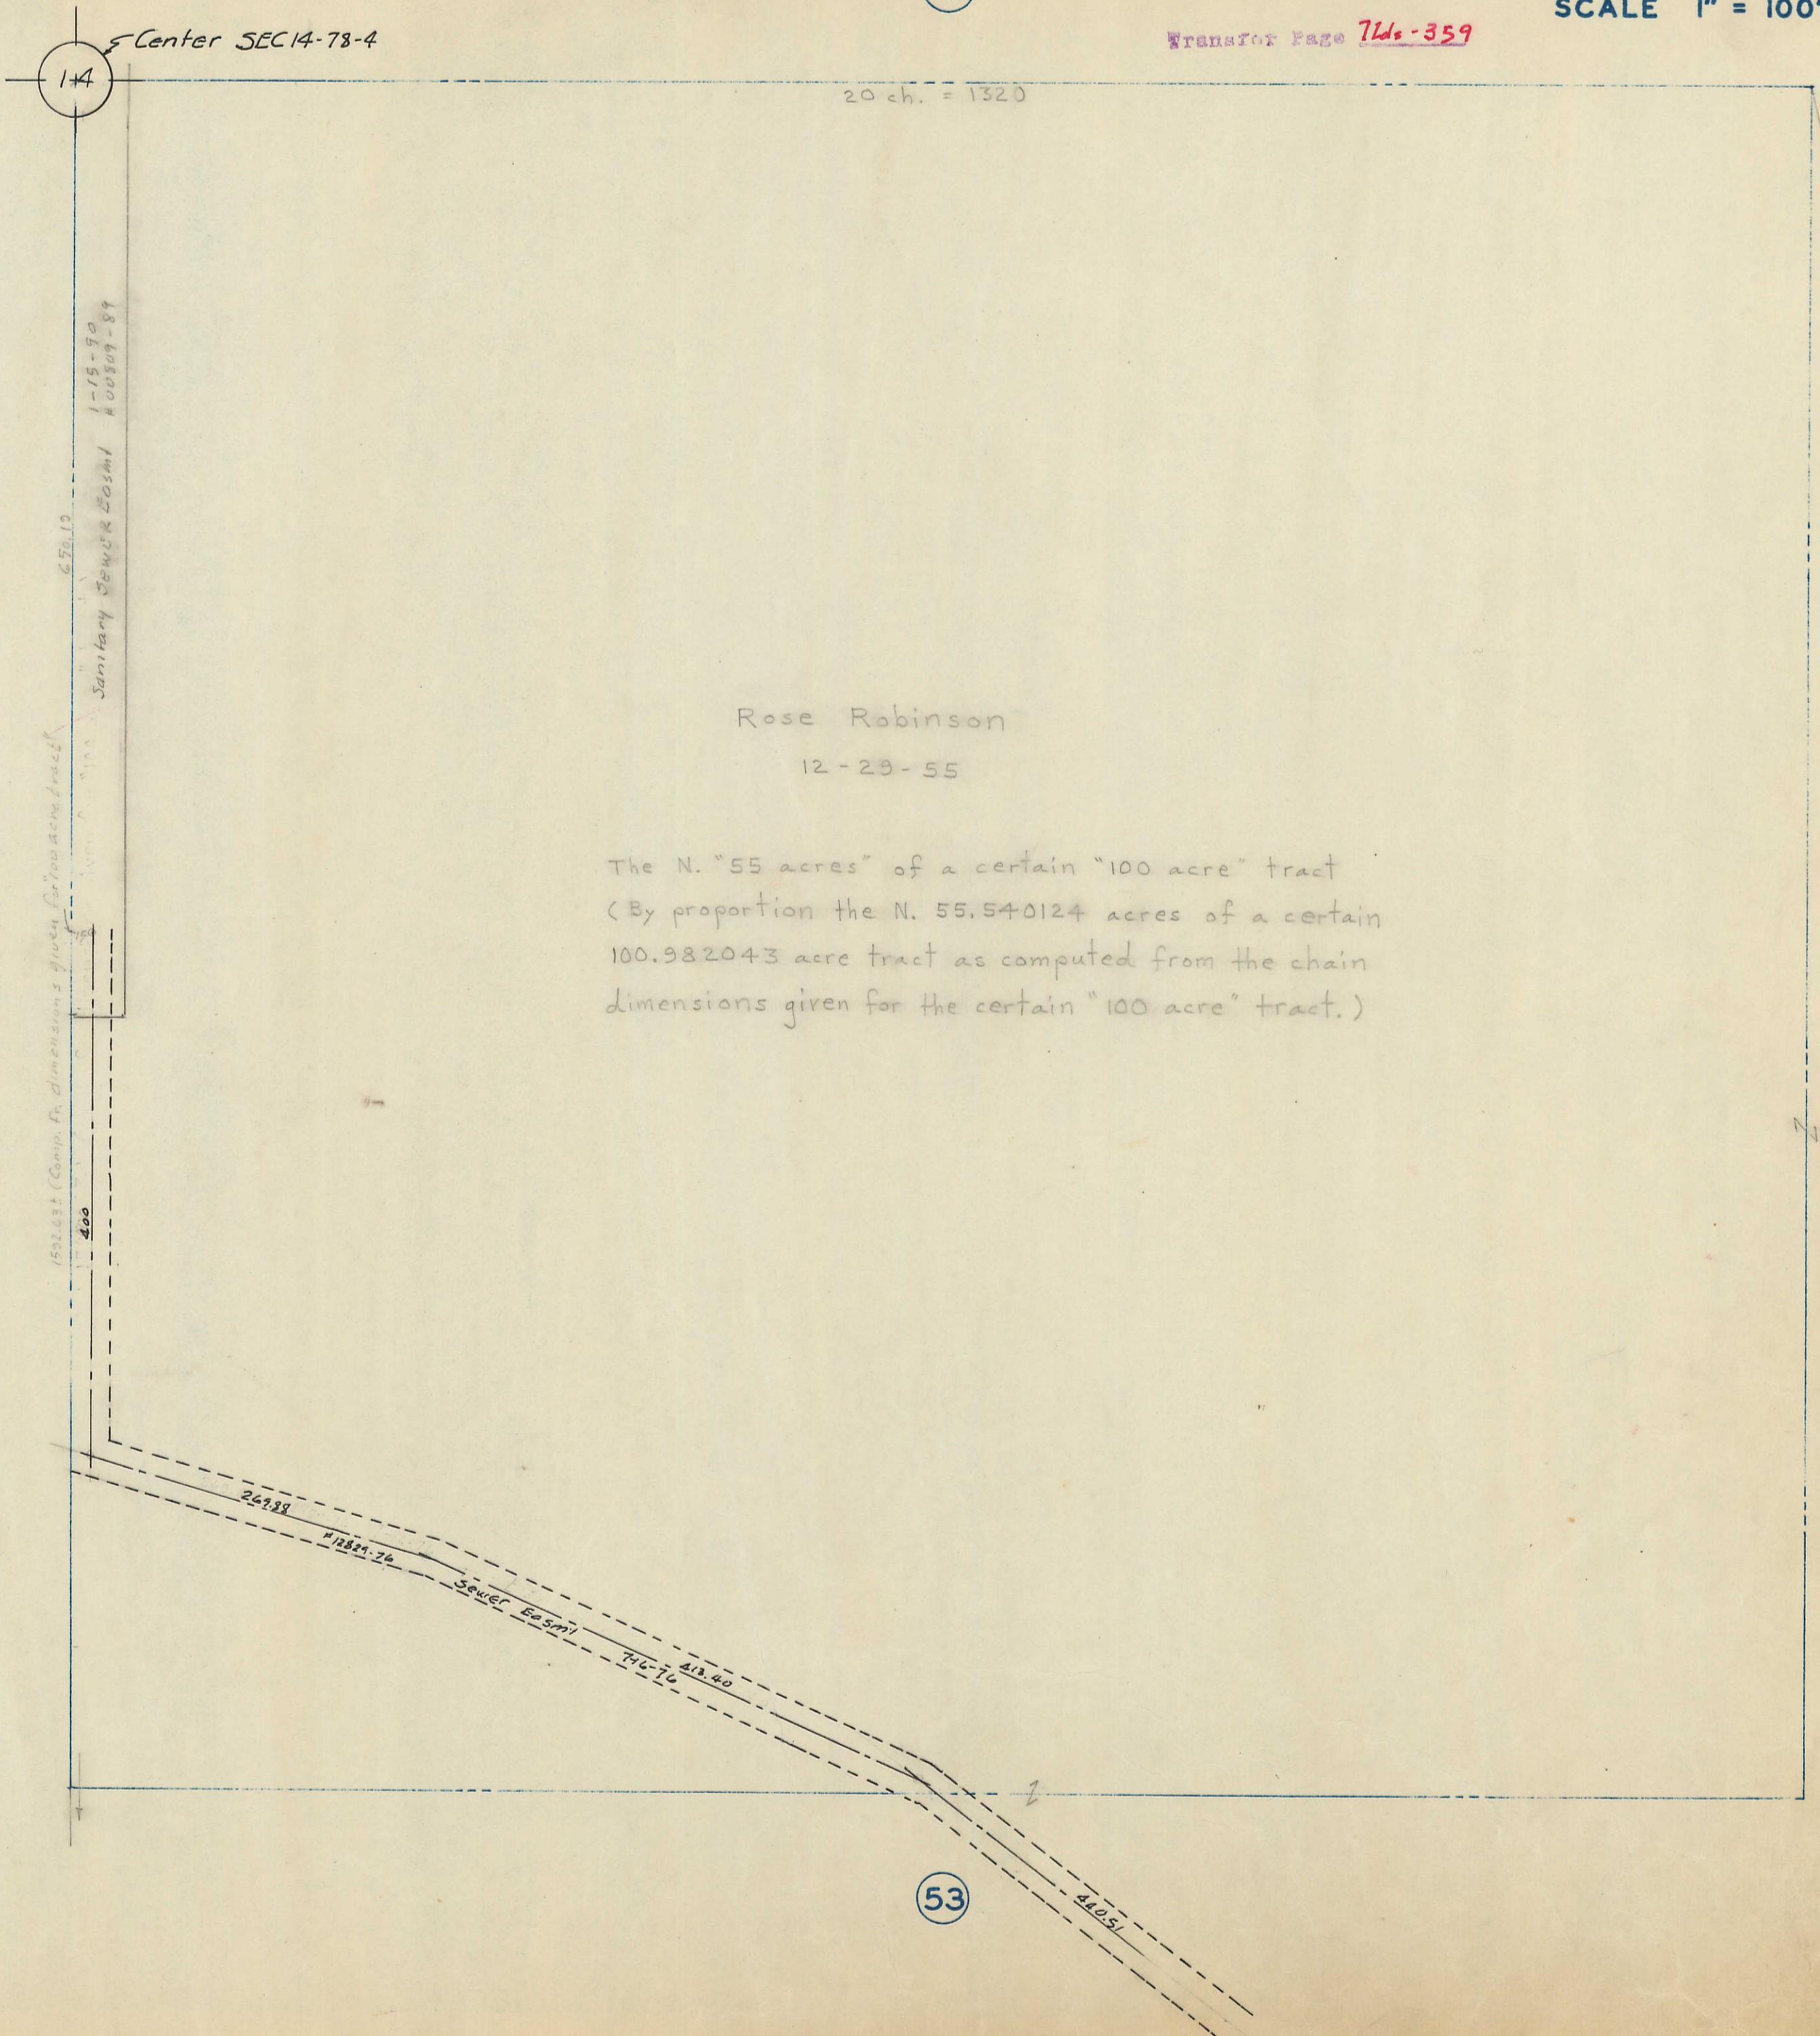

(35)

(39)

(53)