
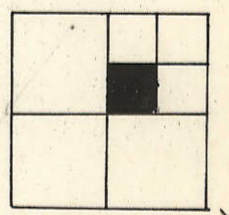


TRANSFER PAGE 74-358

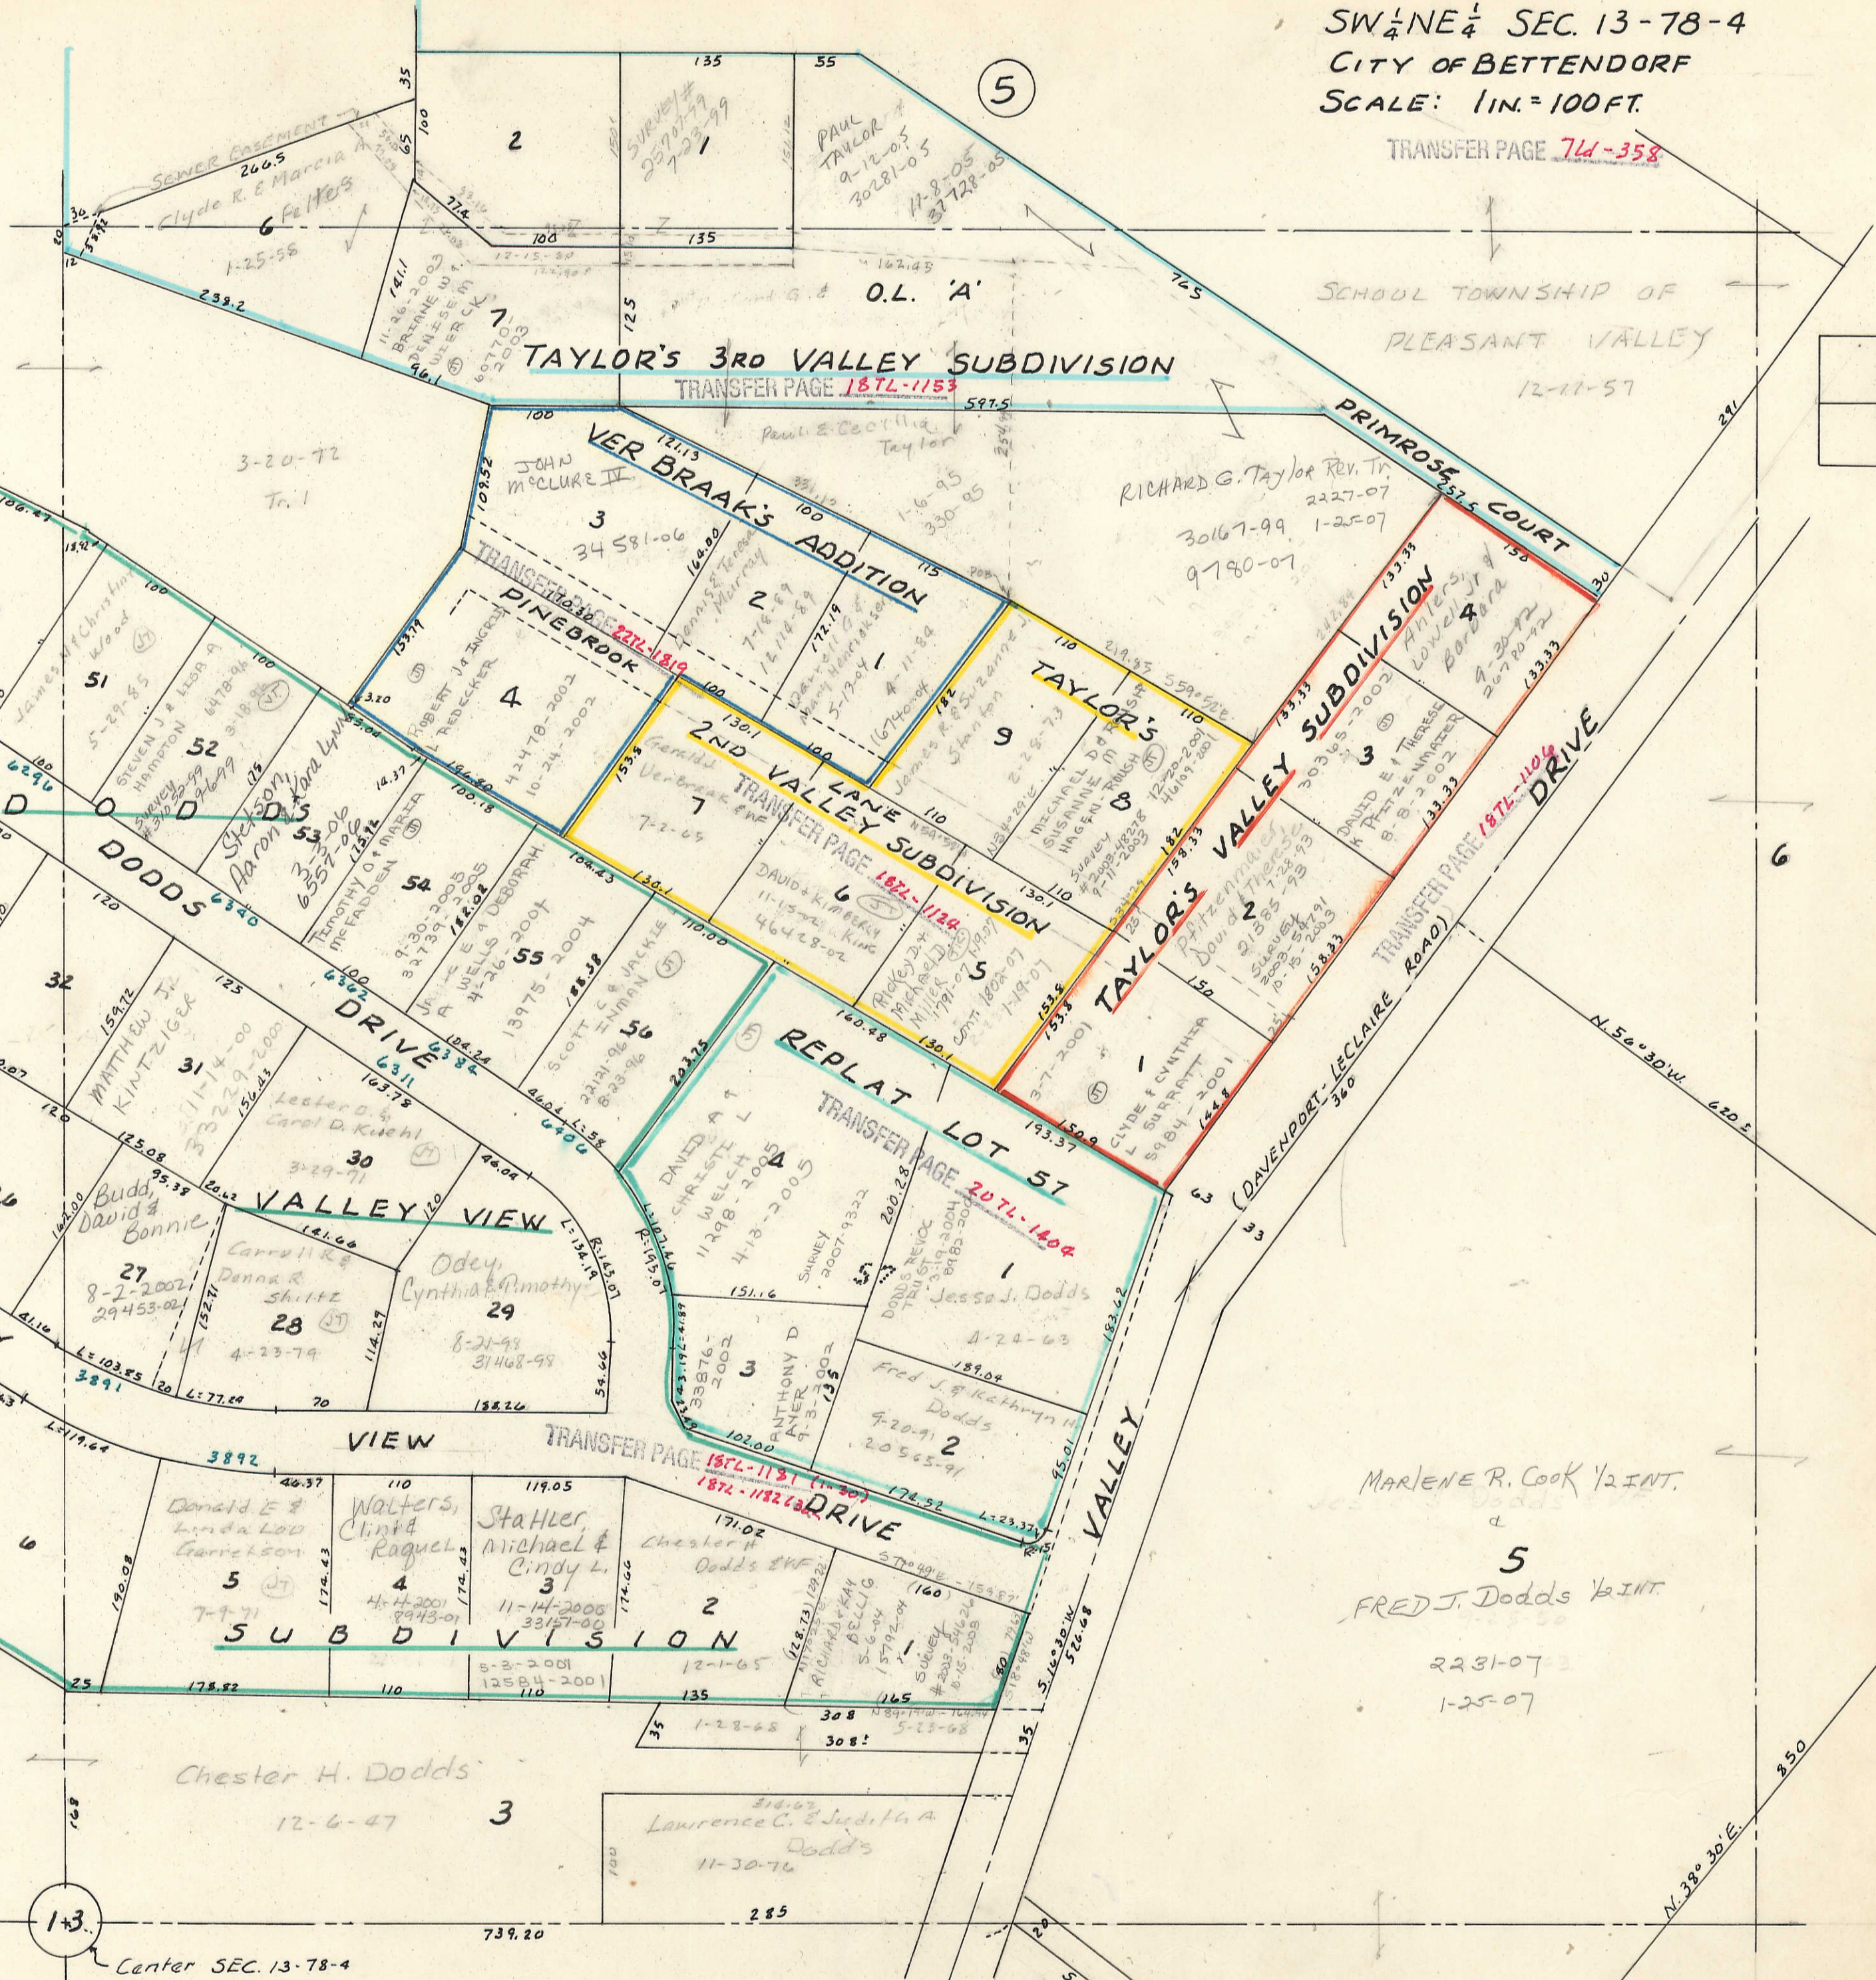

23

19

13

37

Center SEC. 13-78-4

MARLENE R. COOK 1/2 INT.
DODD'S
5
FRED J. DODDS 1/2 INT.
2231-07
1-25-07