
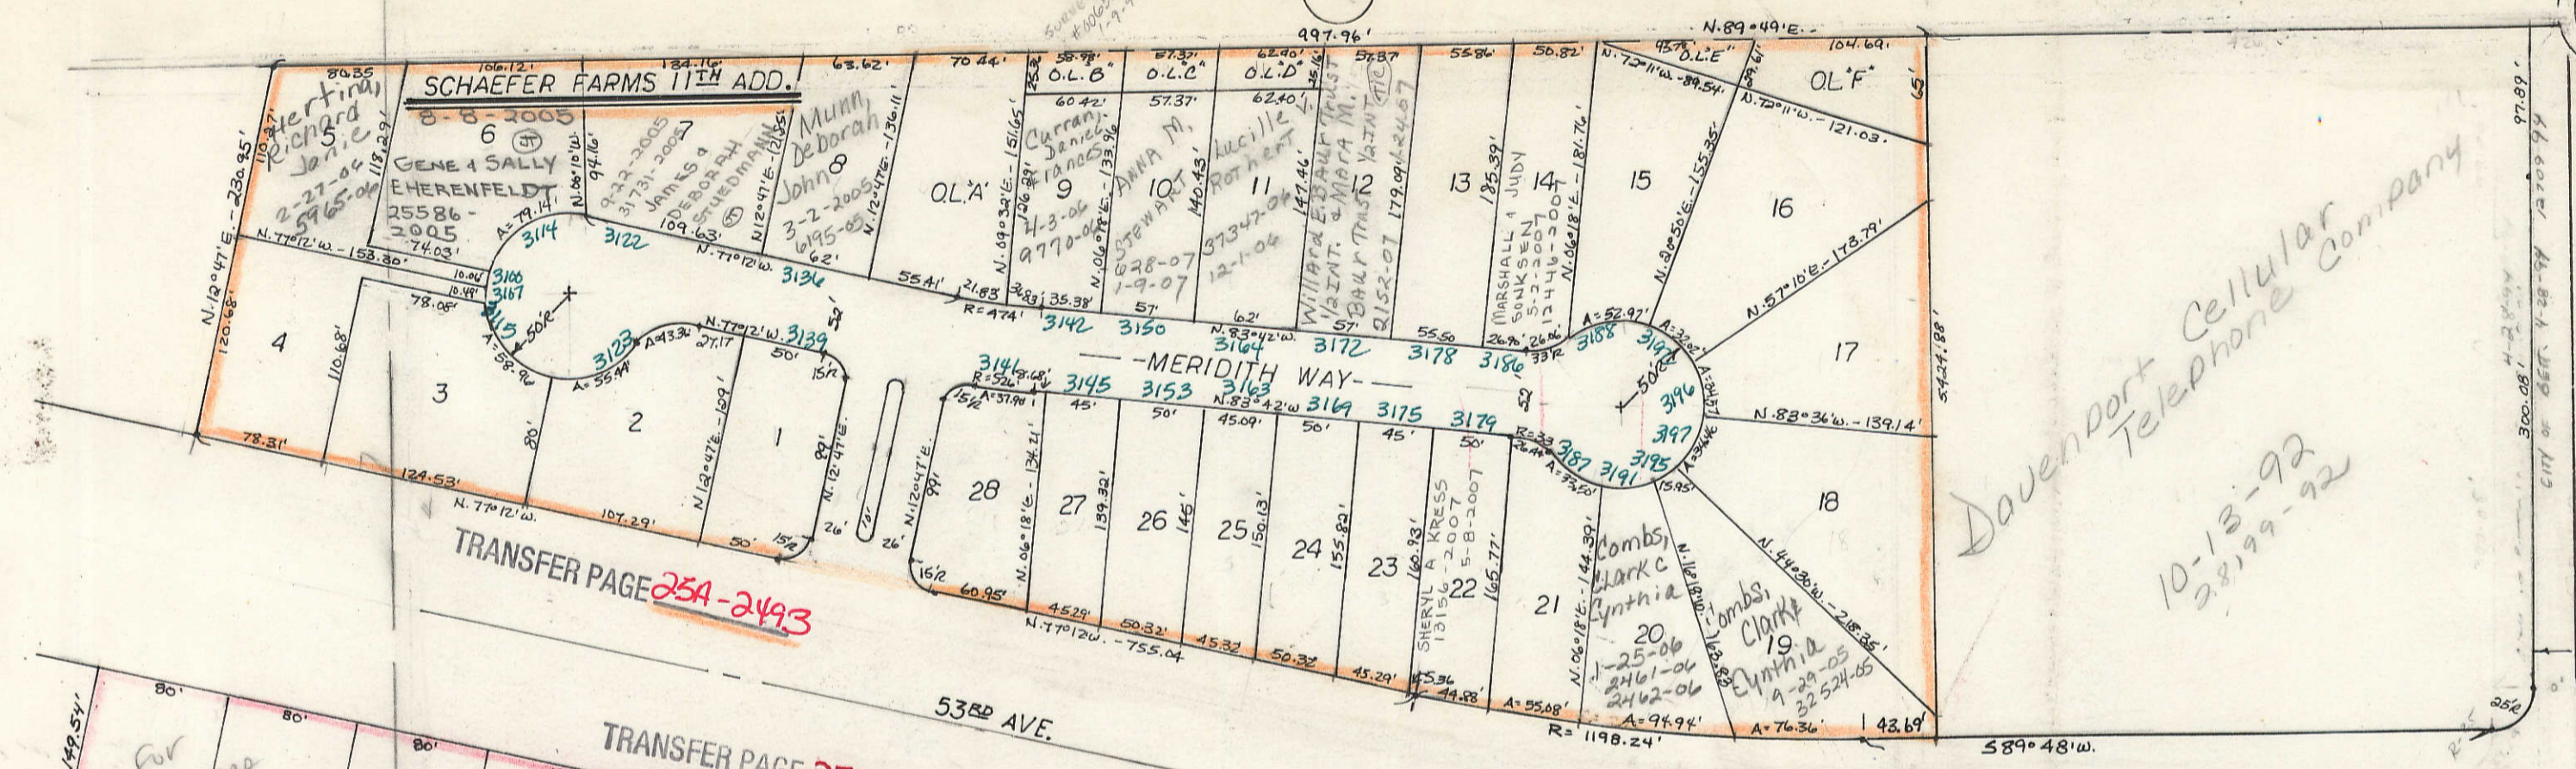


19


10
SECTION

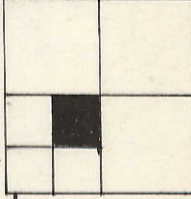

Davenport Cellular Telephone Company
10-13-92
28199-92

TRANSFER PAGE 25A-2493

TRANSFER PAGE 25-2339

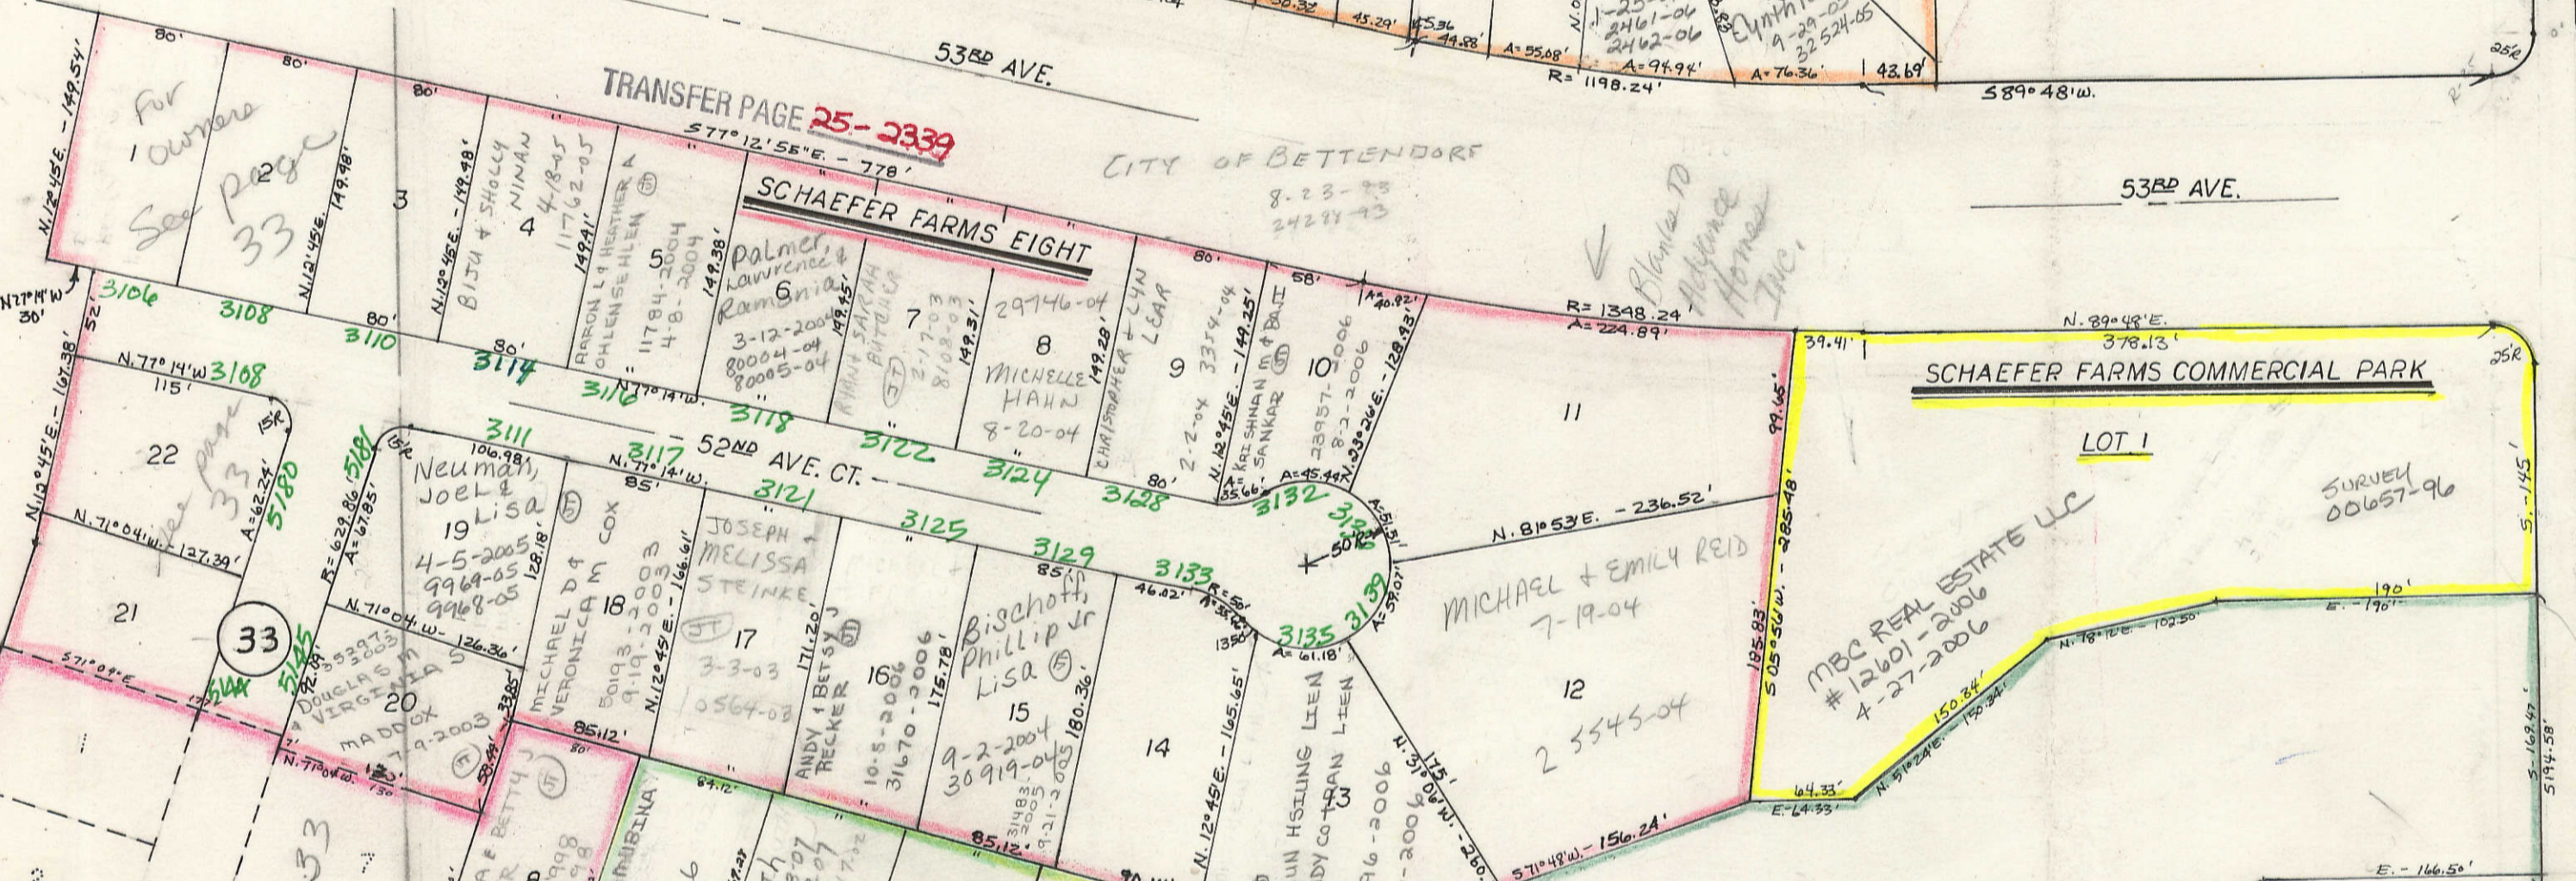


for owners
See page 33

33

37

BLANKS TO
ADVANCE
HOMES
INC.
00650-96

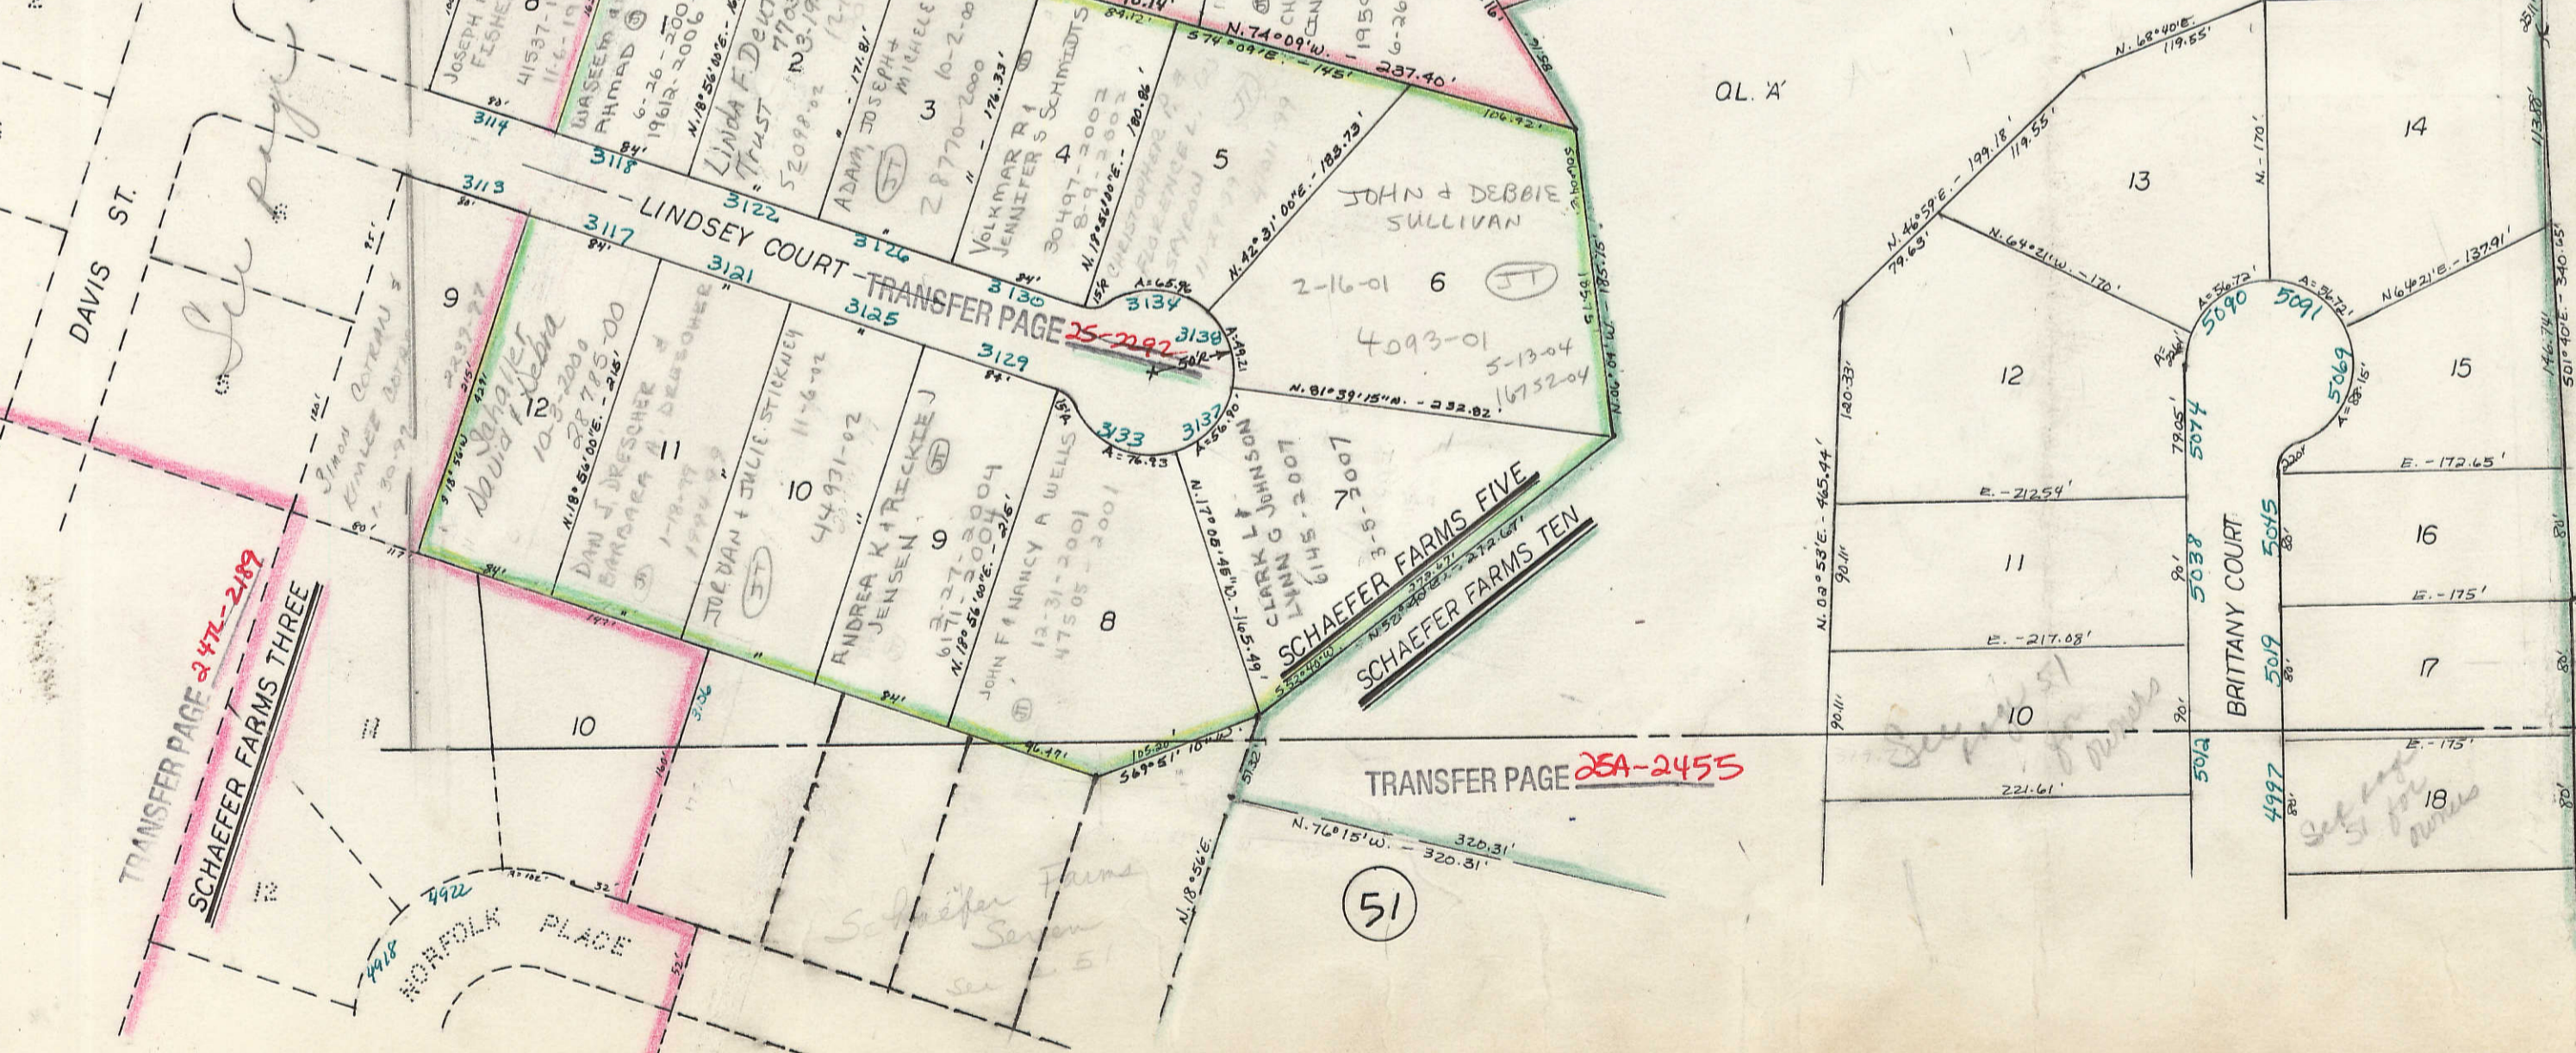

TRANSFER PAGE 2472-2189
SCHAEFER FARMS THREE

TRANSFER PAGE 25A-2455

51

NORFOLK PLACE

DEVILS GLEN ROAD

Survey
19167-90
5-20-92
21662-97
8-12-97