

4.591 AC. 49


Transfer Page 6 of 210
NW 1/4, NE 1/4 SEC. 9-78-4
SCALE: 1"=100'

Crow Valley Golf Club
11-2-79

SELLERS ESTABLISHMENT, INC.
2-31-67

18.253 AC.

SEC. 9-78-4

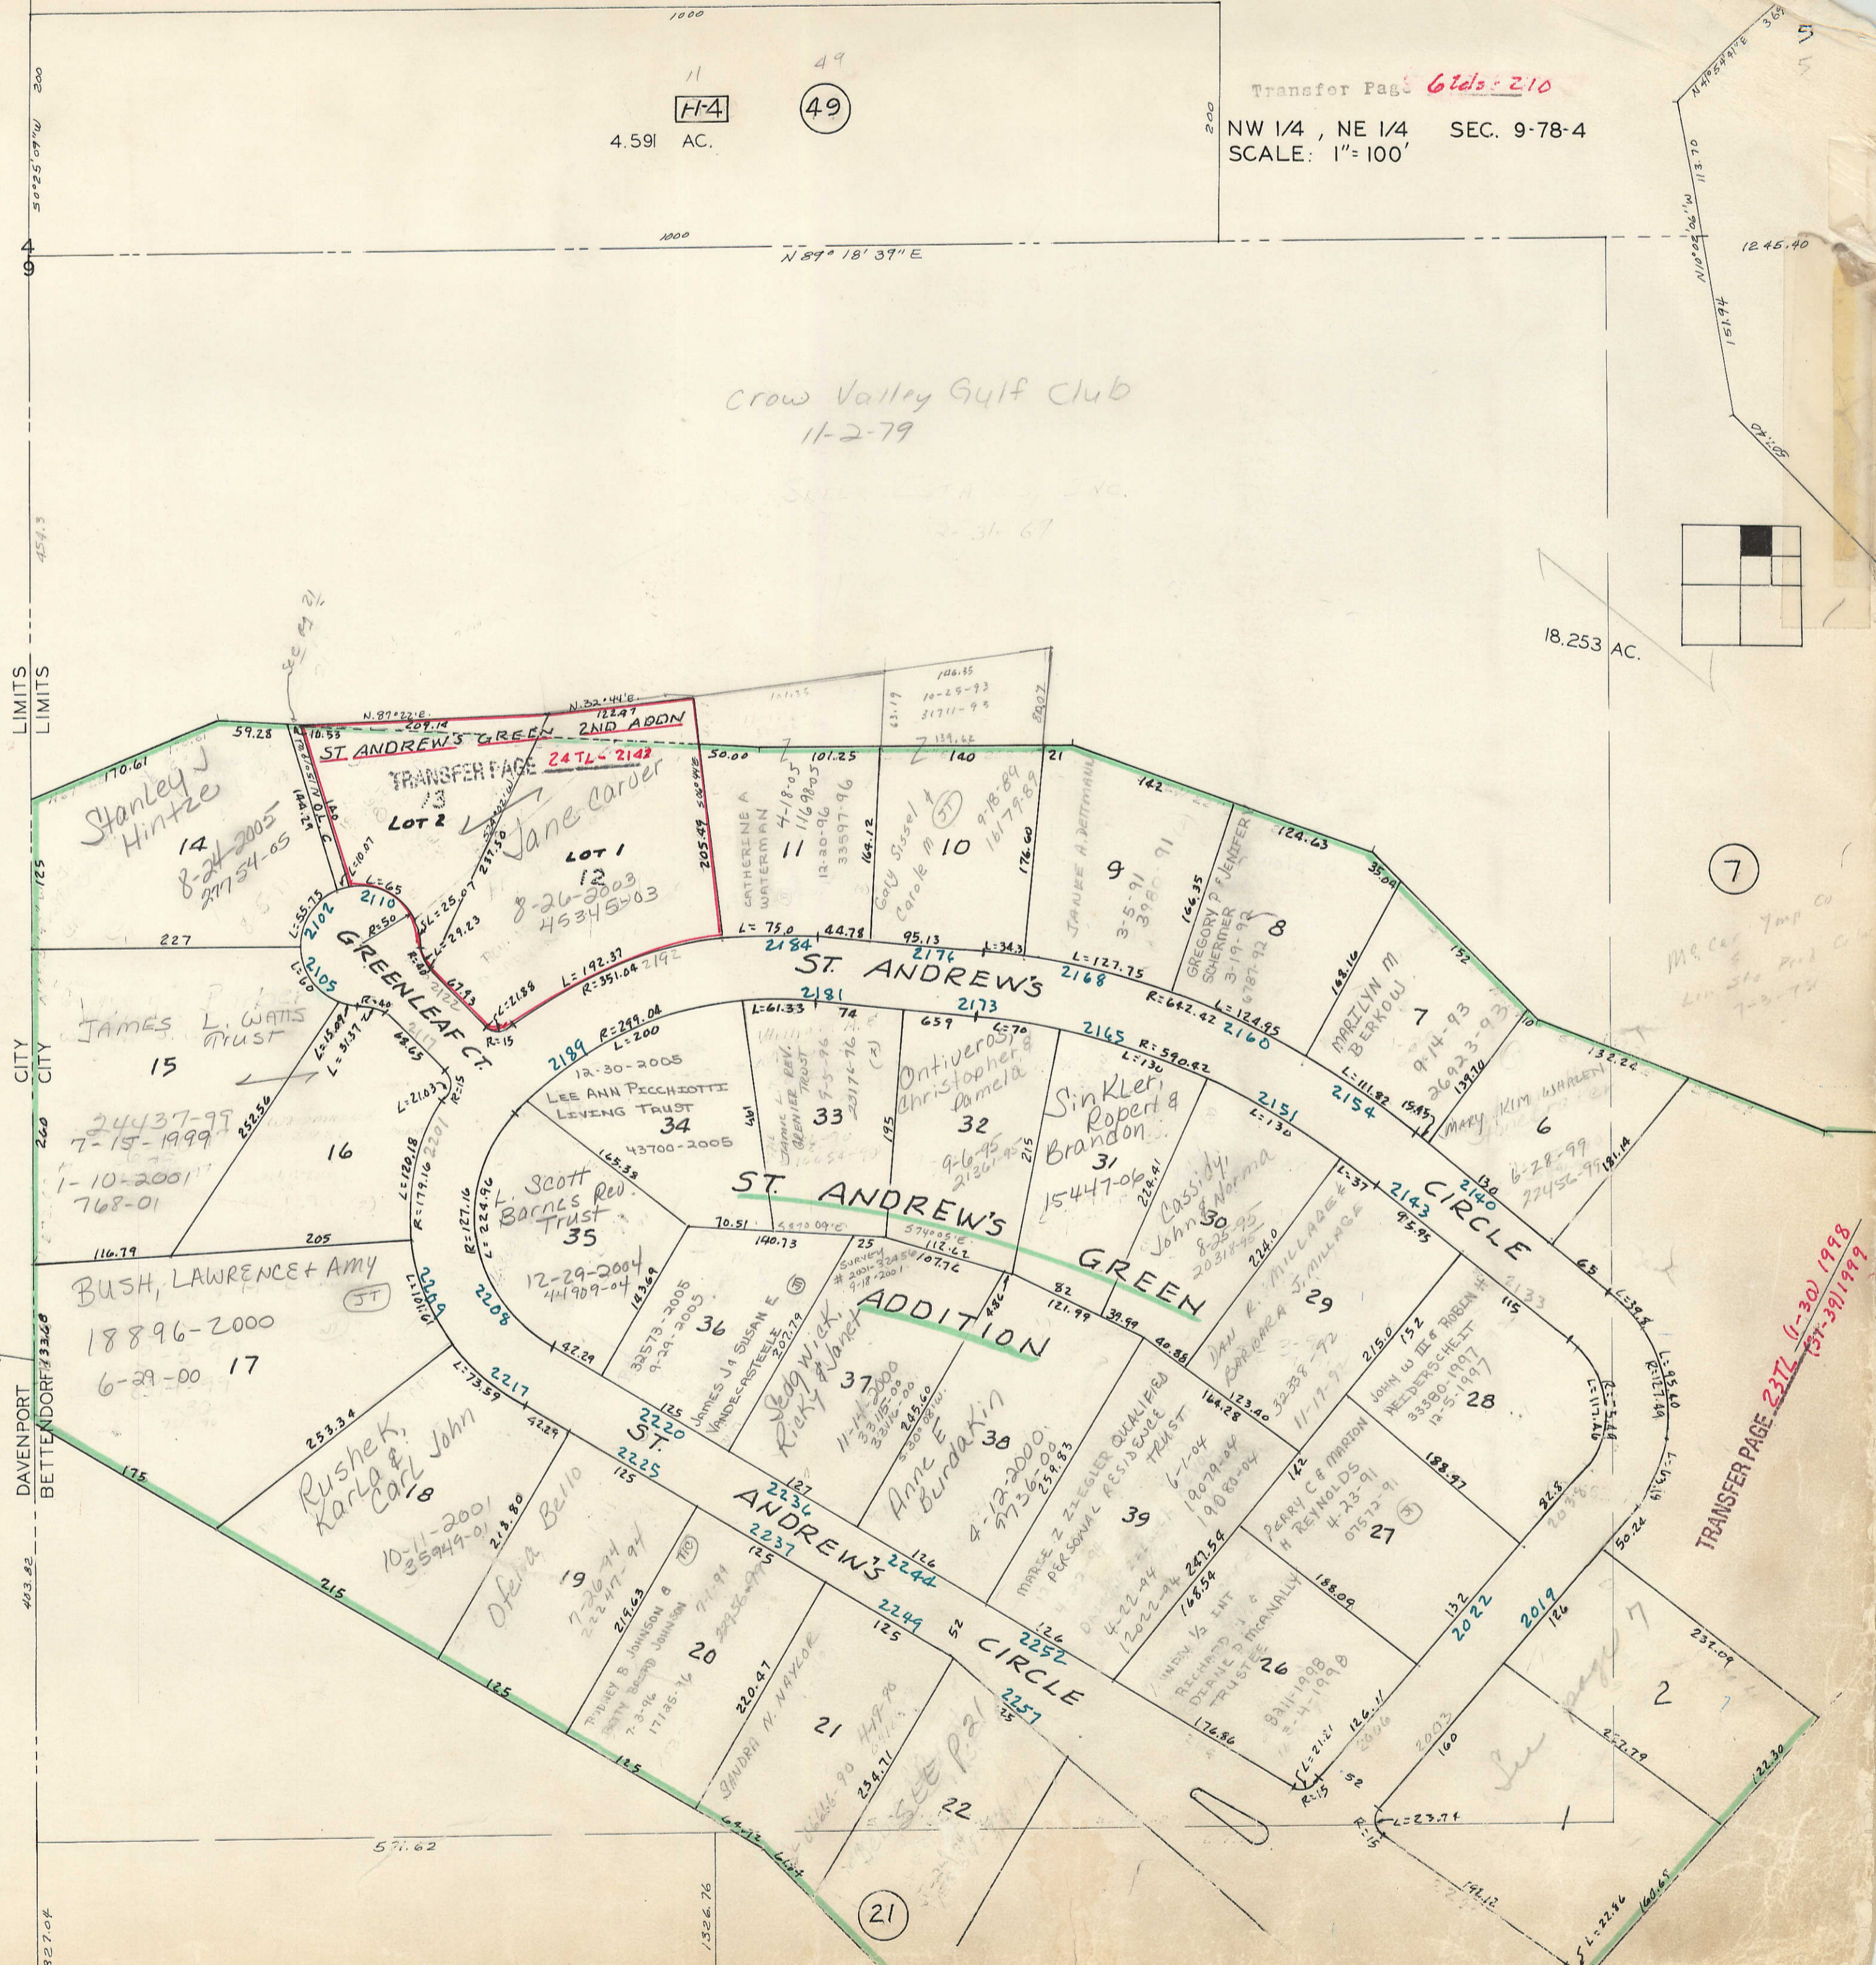

Y-9

3

7

TRANSFER PAGE 237L (1-30) 1998
(17-39) 1999

413.22

571.62

21

2