


EAST (42)

(41A)

Transfer Page 411

Transfer Page 437

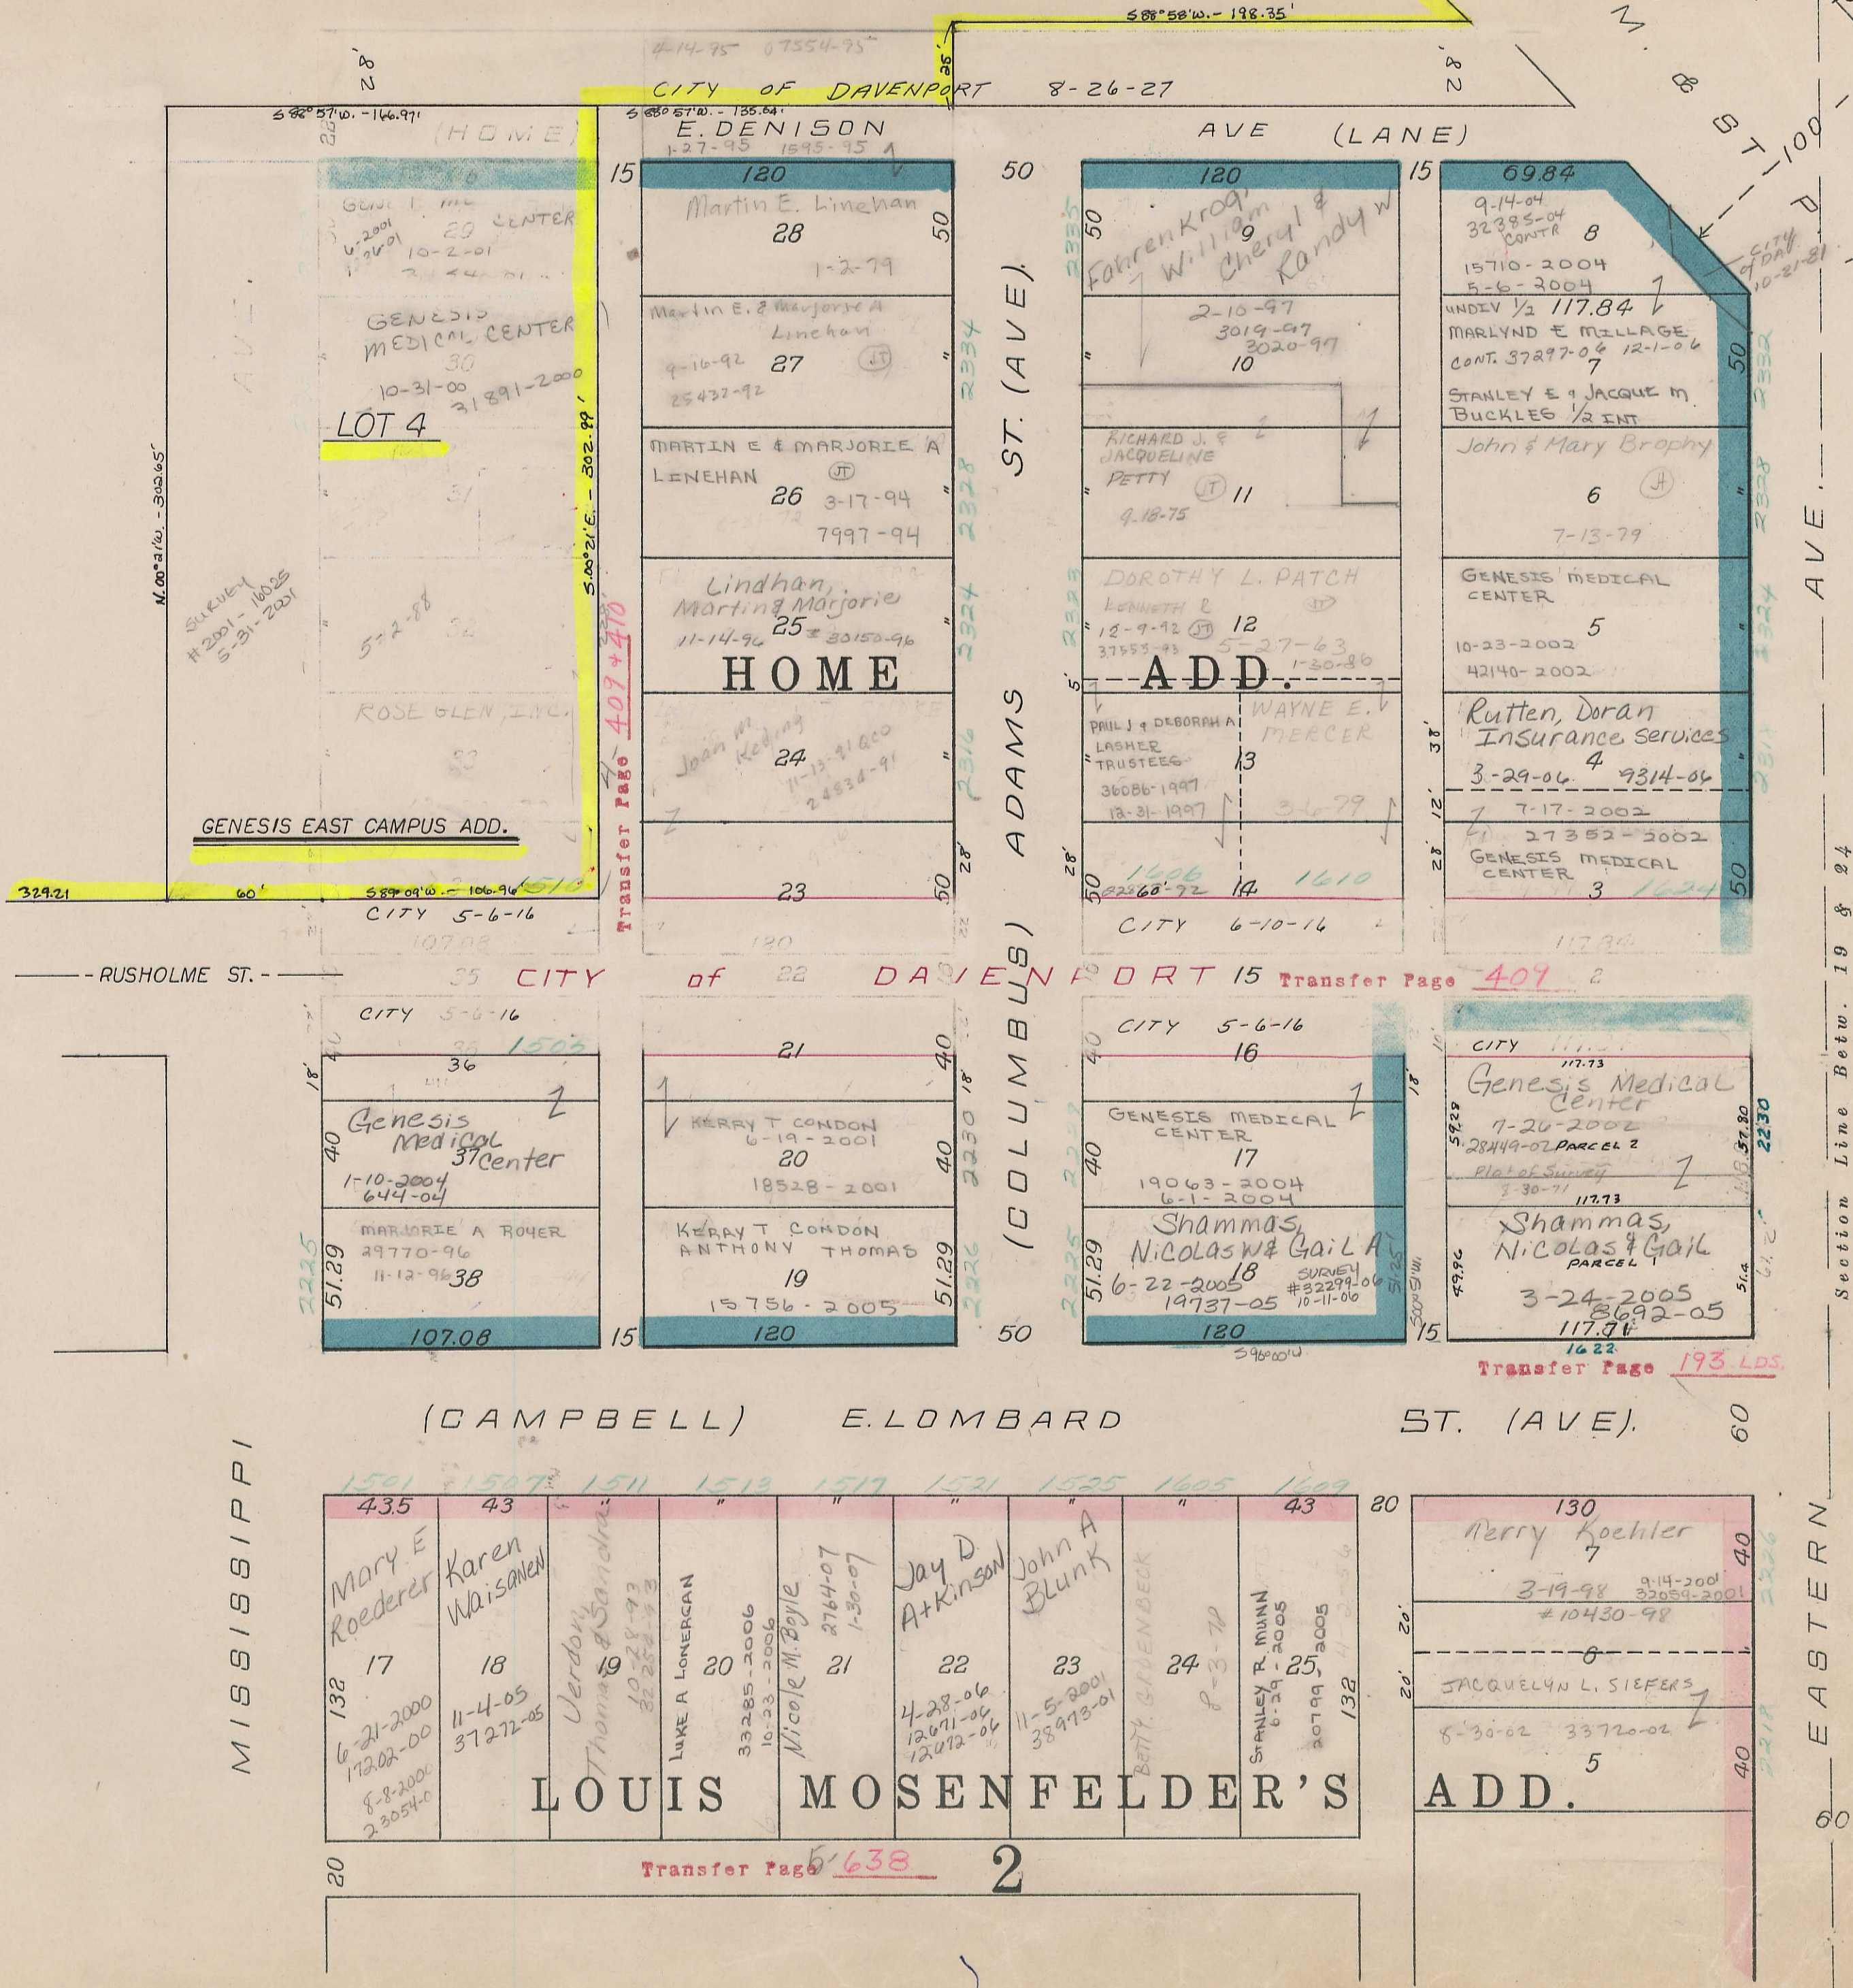

M. 0021/6 - 302.65

SURVEY #2001-1628 5-31-2001

GENESIS EAST CAMPUS ADD.

Transfer Page 407 + 410

Transfer Page 407

Transfer Page 193 L.D.S.

Transfer Page 638

VOL D 48

Section Line Betw. 19 & 24

41