
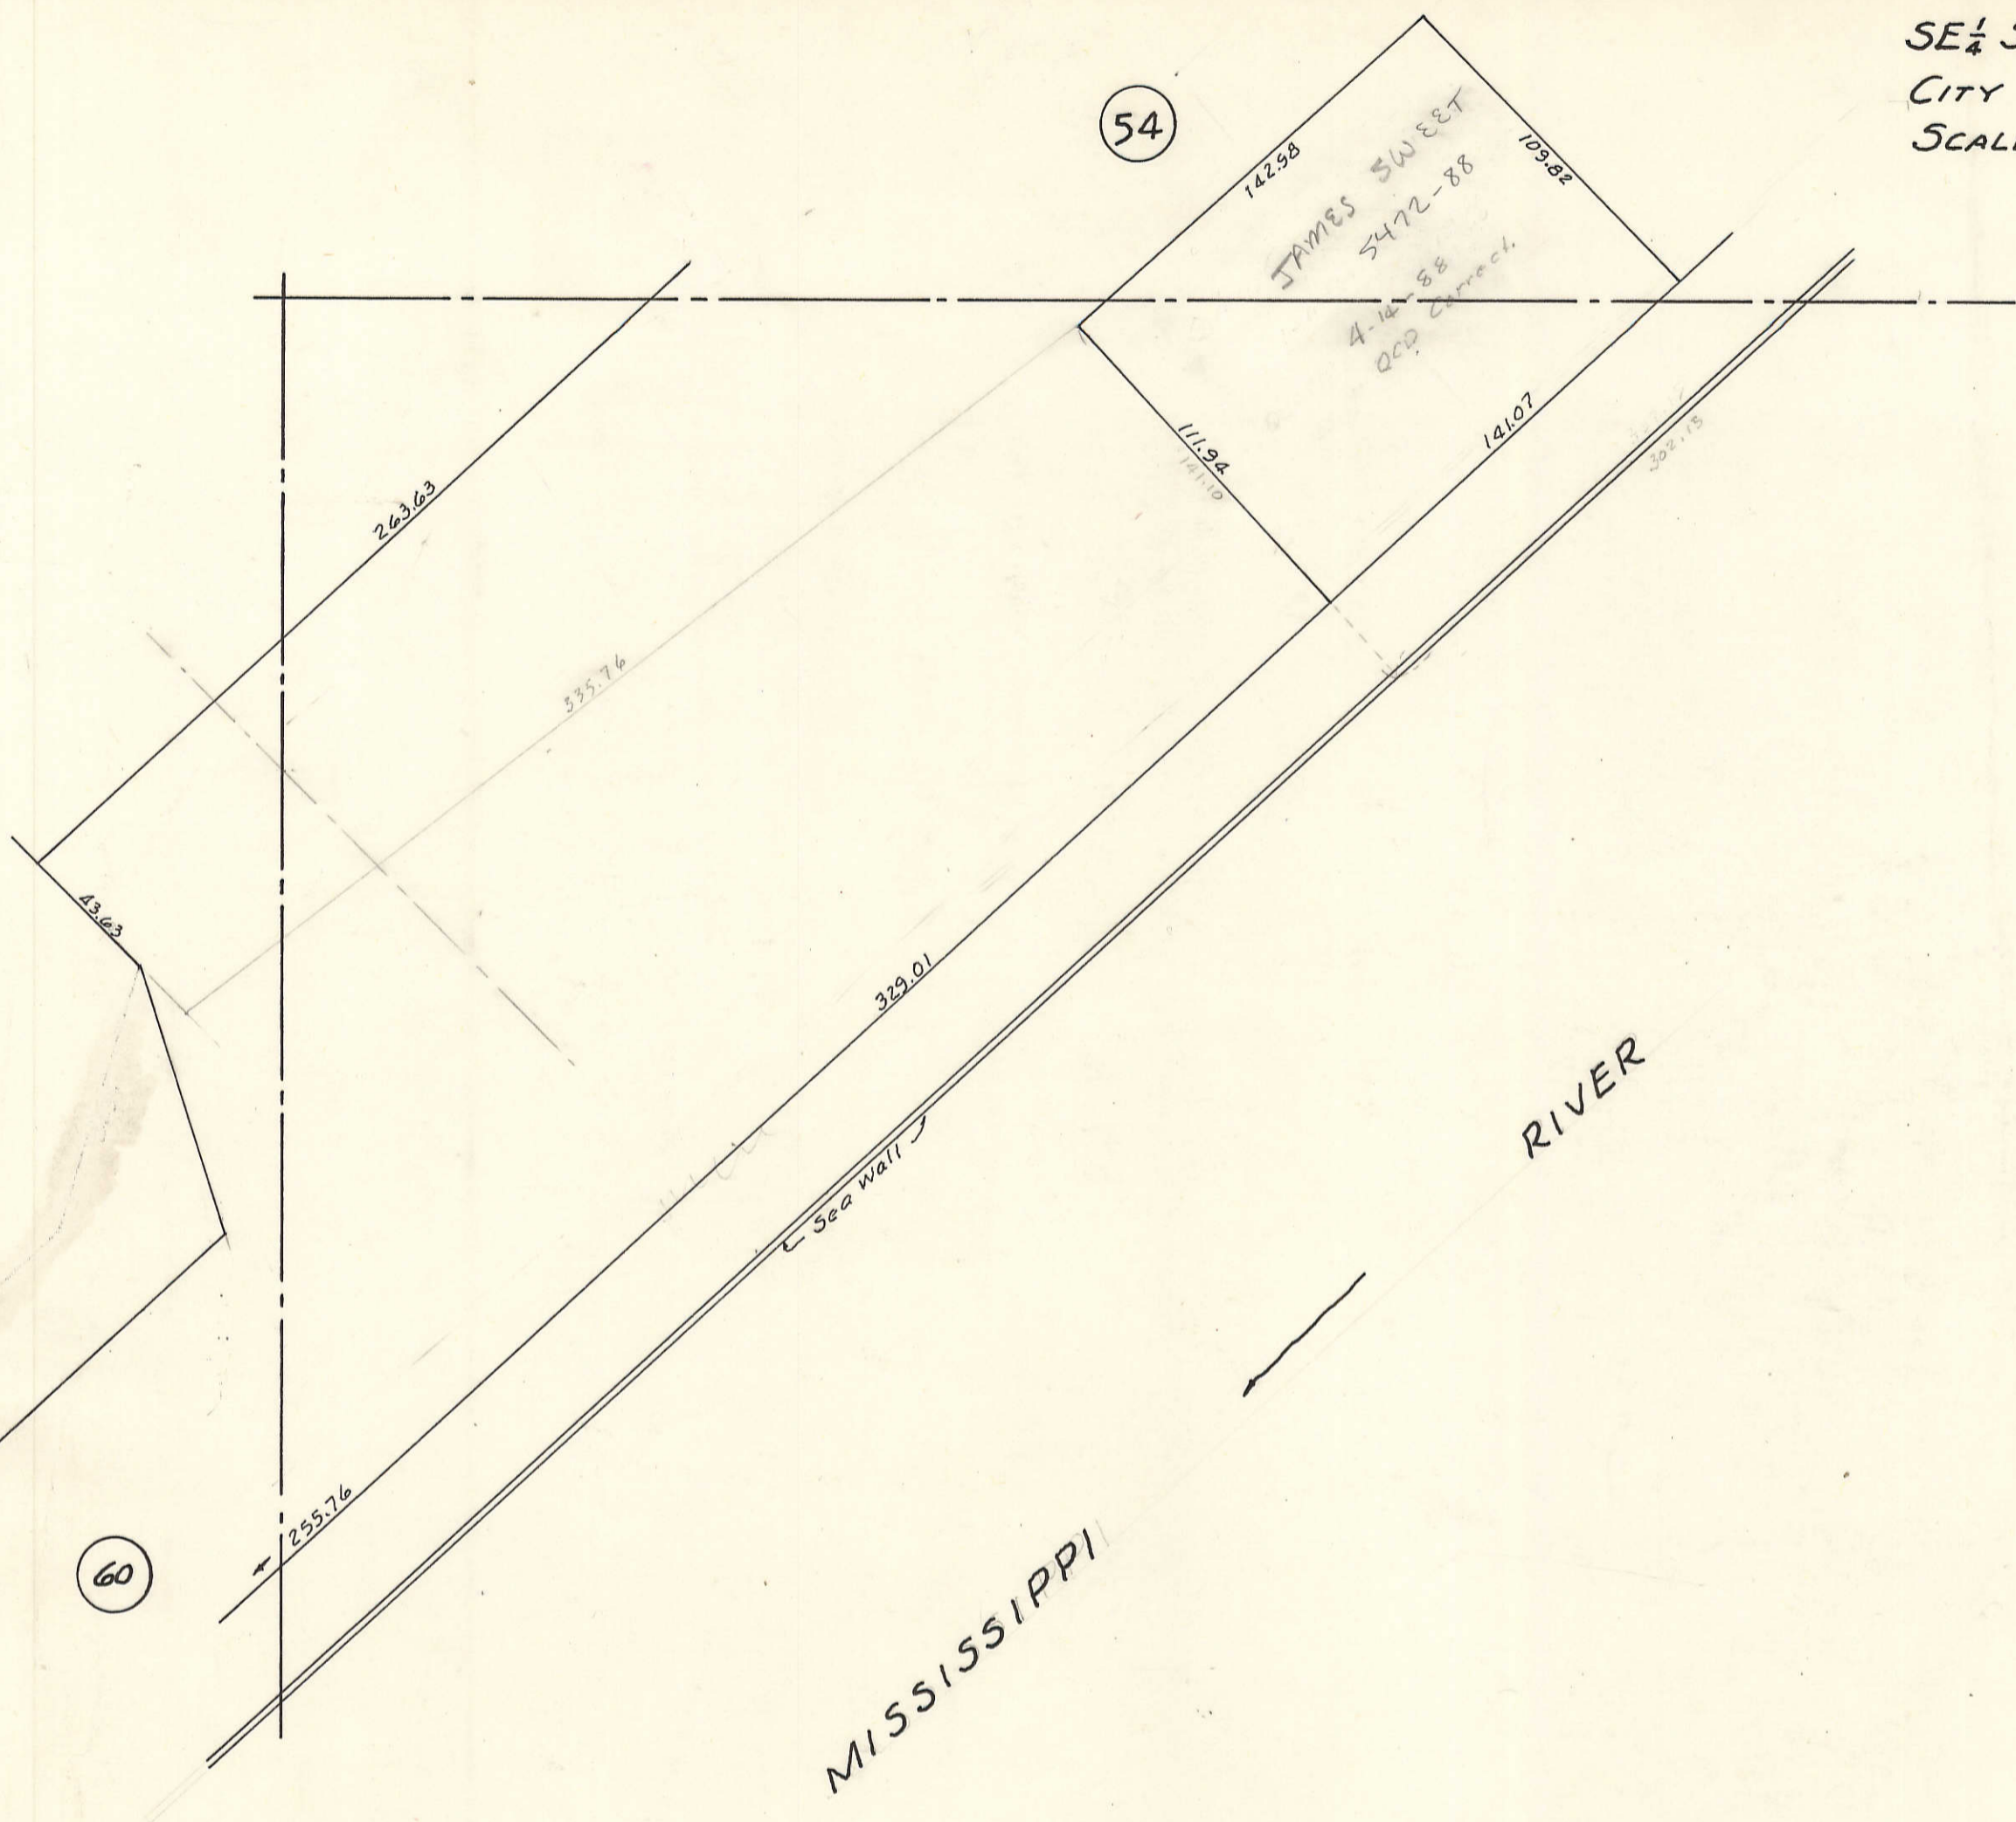


SE $\frac{1}{4}$ SW $\frac{1}{4}$ SE $\frac{1}{4}$ SEC 25-78-3
CITY OF DAVENPORT
SCALE: 1 in. = 50 ft.

54

JAMES SWEET
4-14-88
QCD Correct.

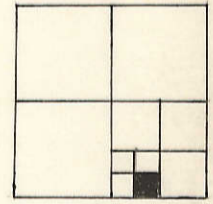

60