



Transfer Page 6lds-199

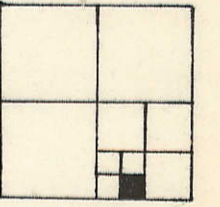


80 5TH STREET

80 STREET

SCOTT STREET
SCOTT ST is 80' wide
60

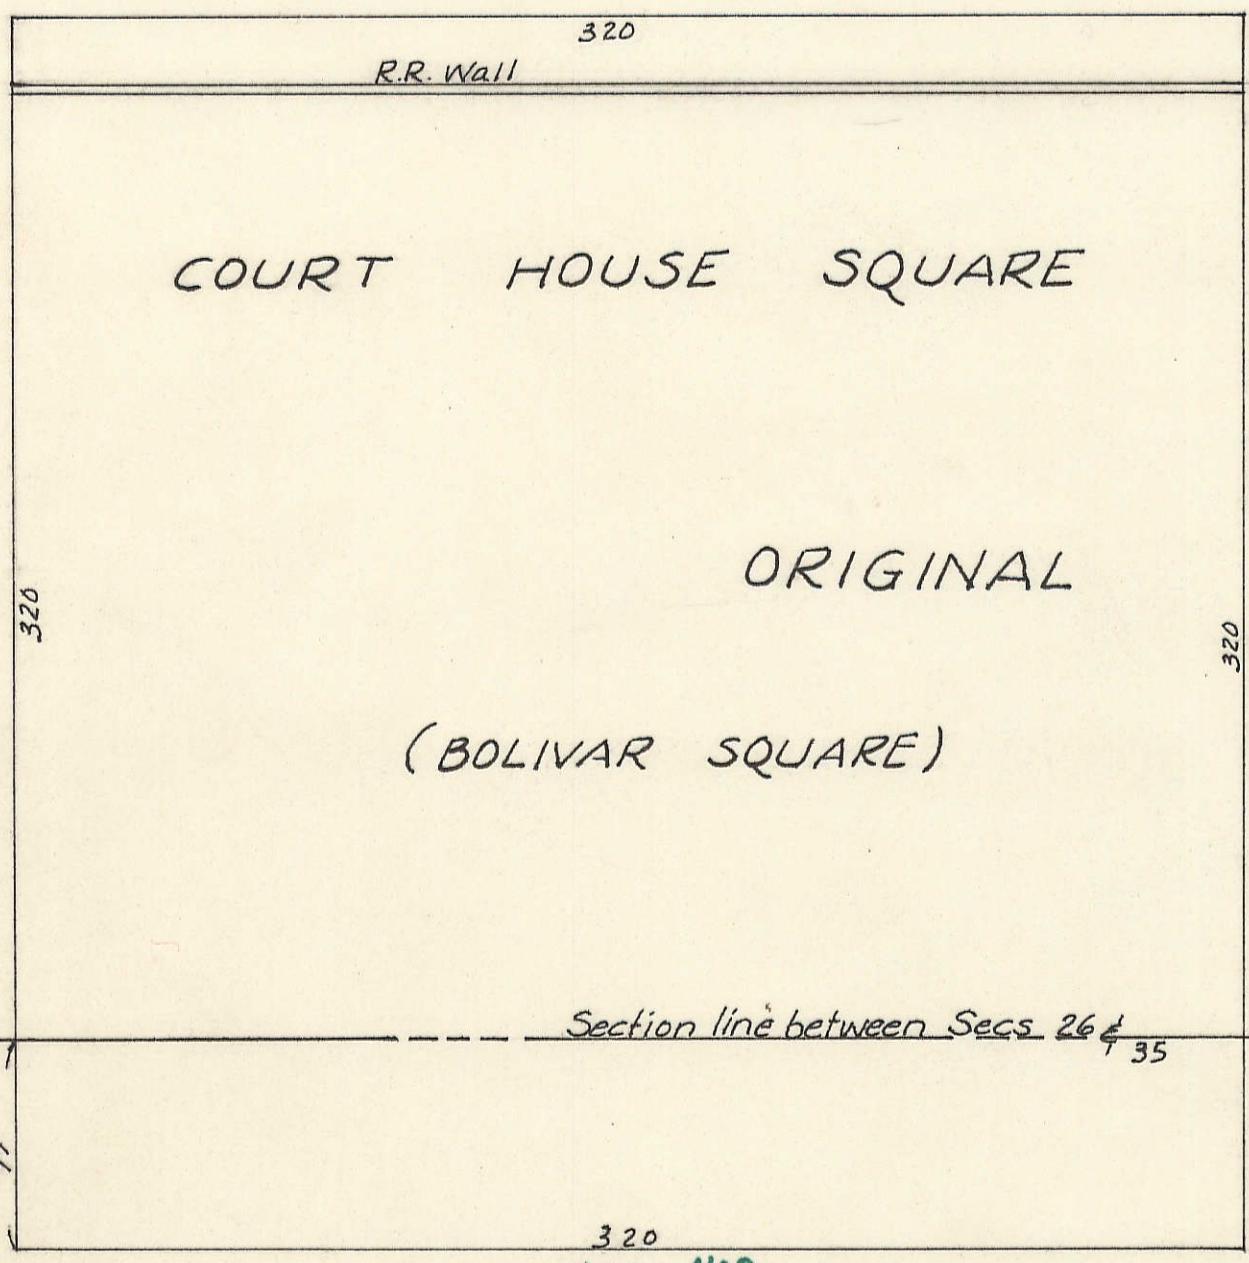

80 STREET
RIPLEY STREET

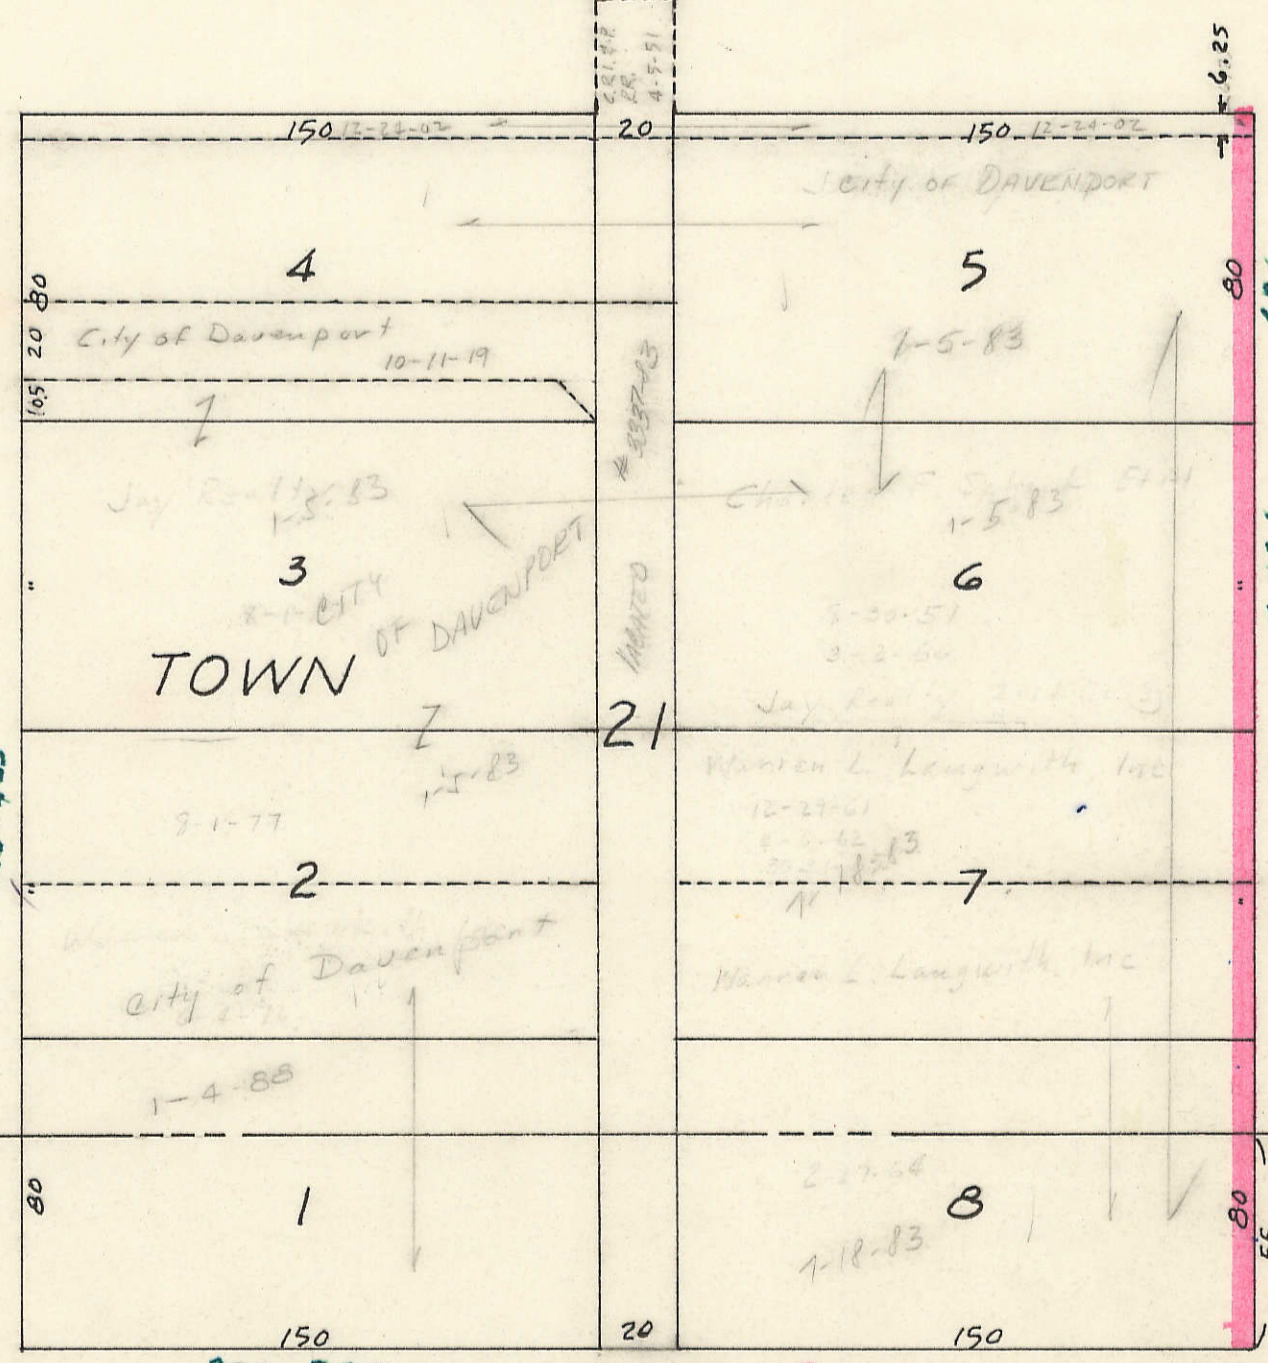

HARRISON STREET
HARRISON ST is 80' wide
58

80 4TH STREET

80 STREET

Transfer Page 2-137