


47

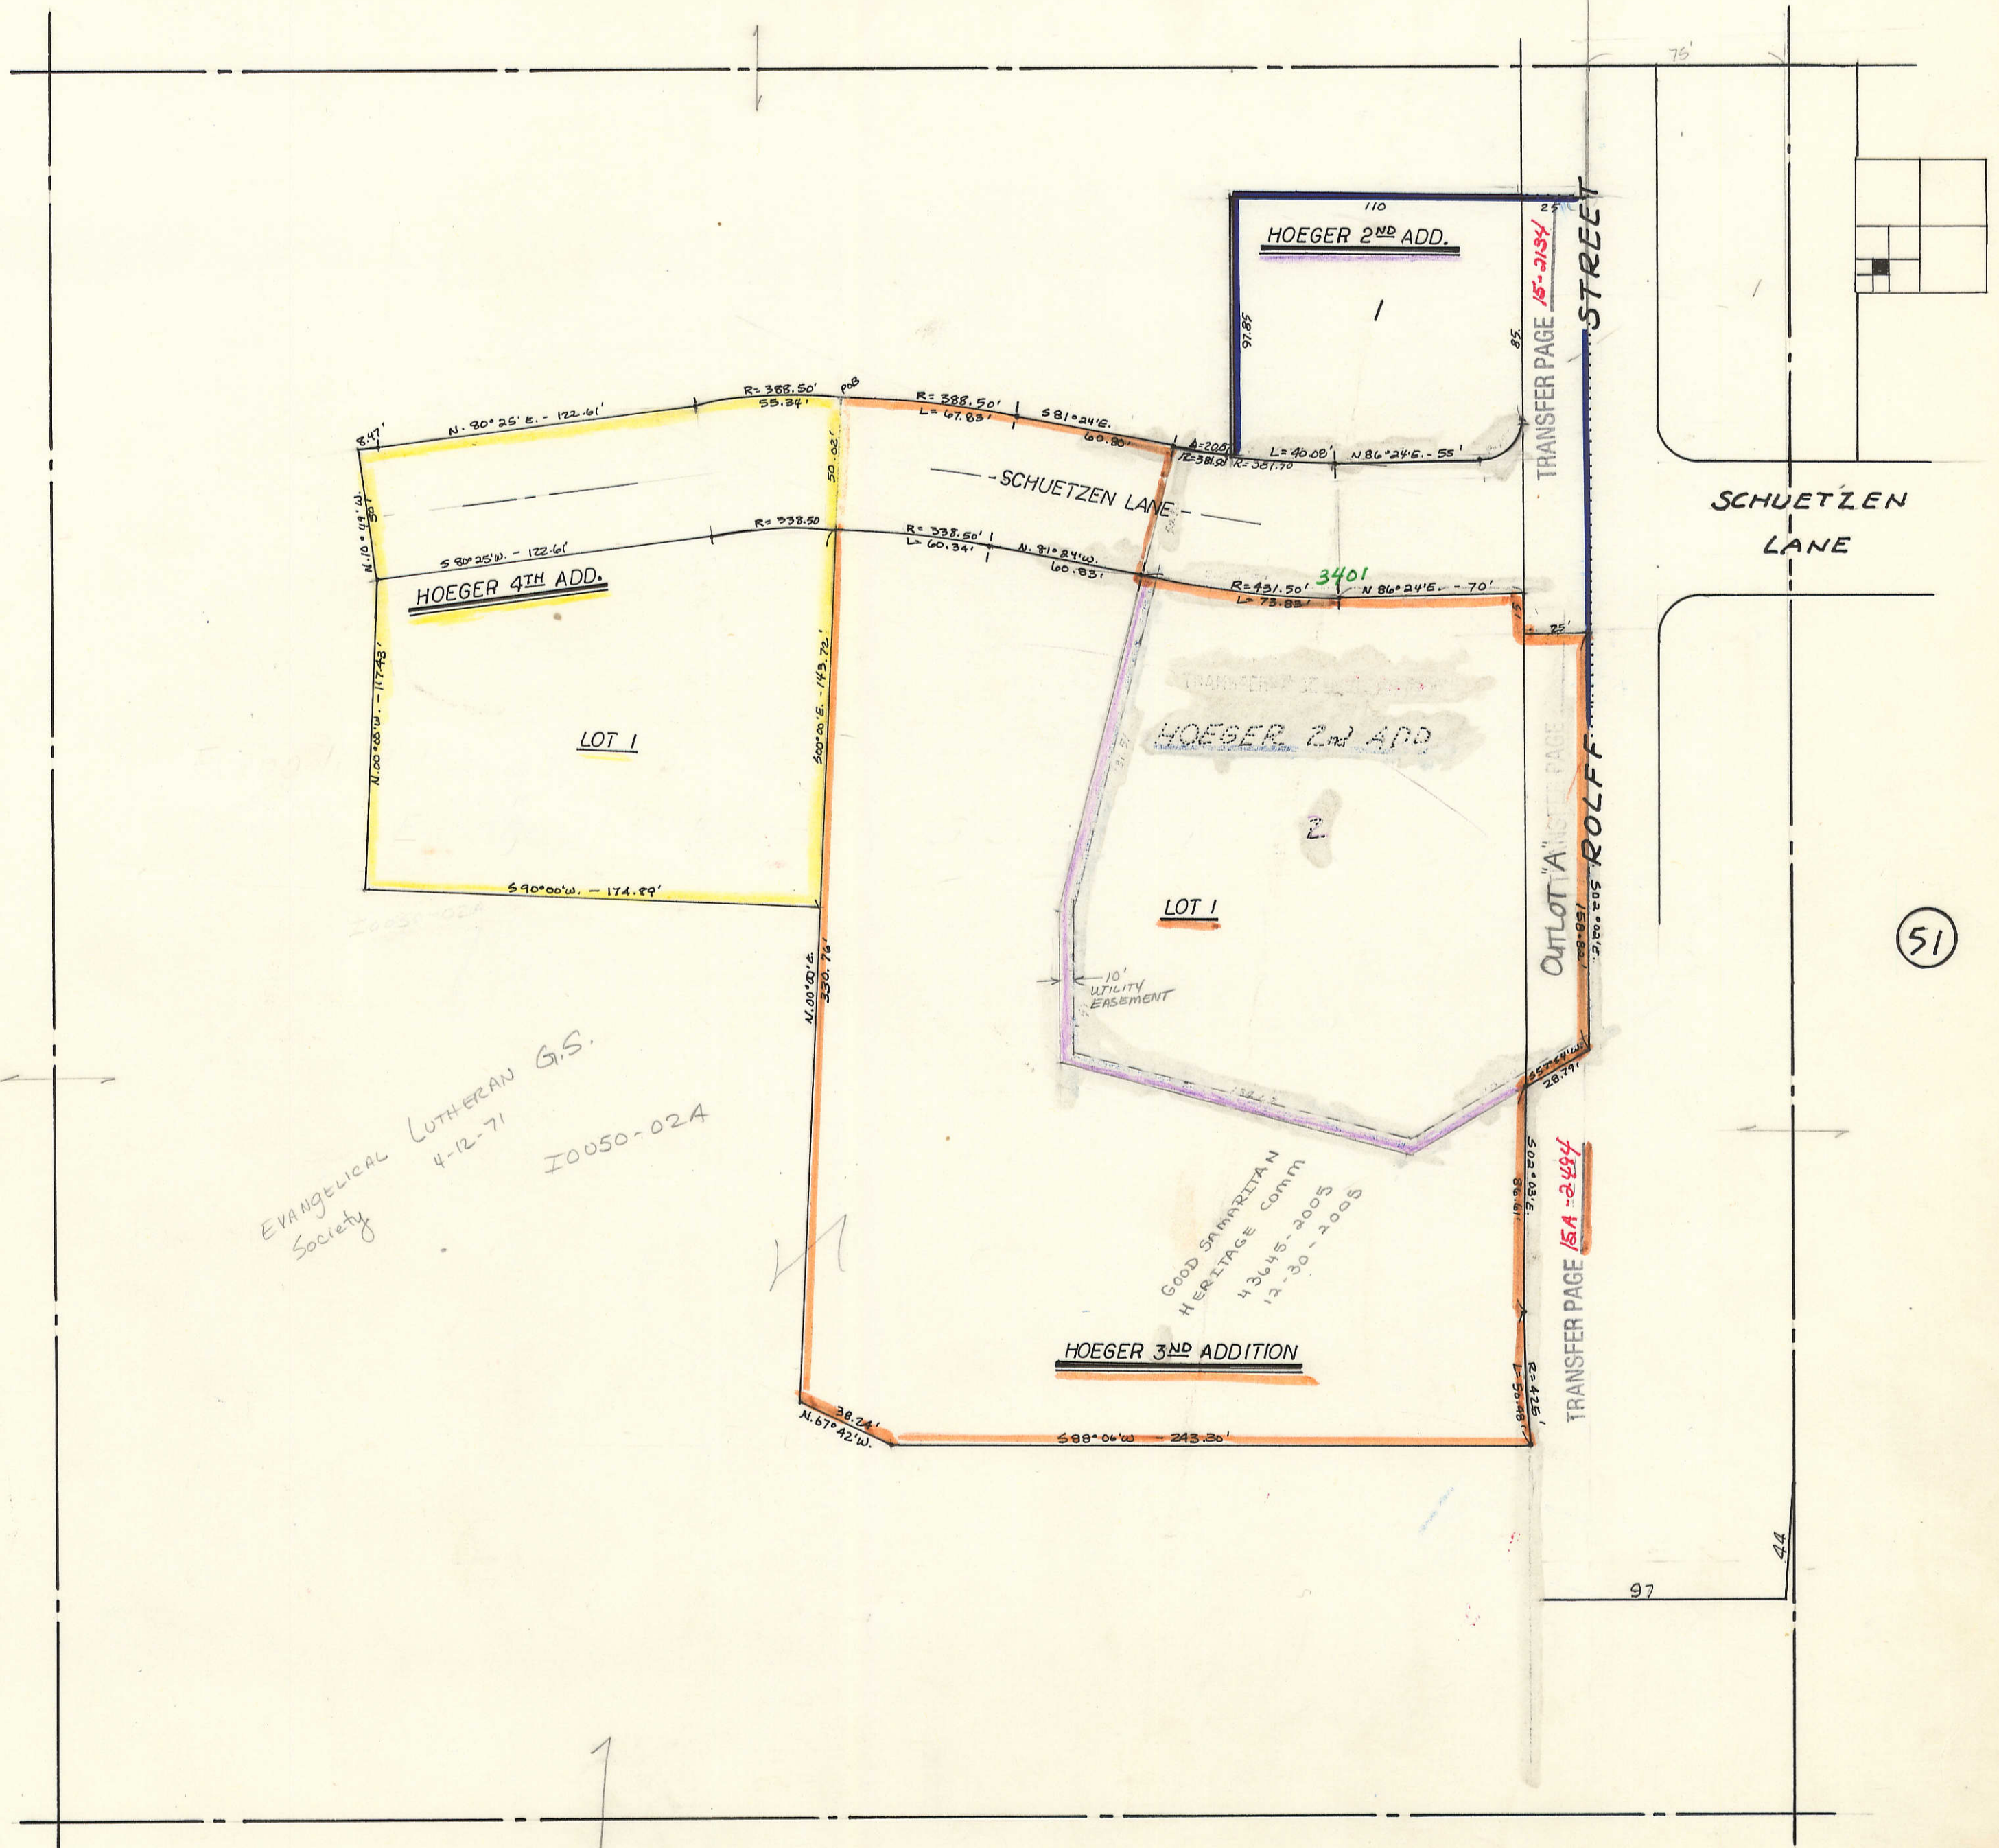

49

EVANGELICAL LUTHERAN G.S.
Society 4-12-71 IO050-024

GOOD SAMARITAN
HERITAGE COMM
43645-2005
12-30-2005

51

63