


35

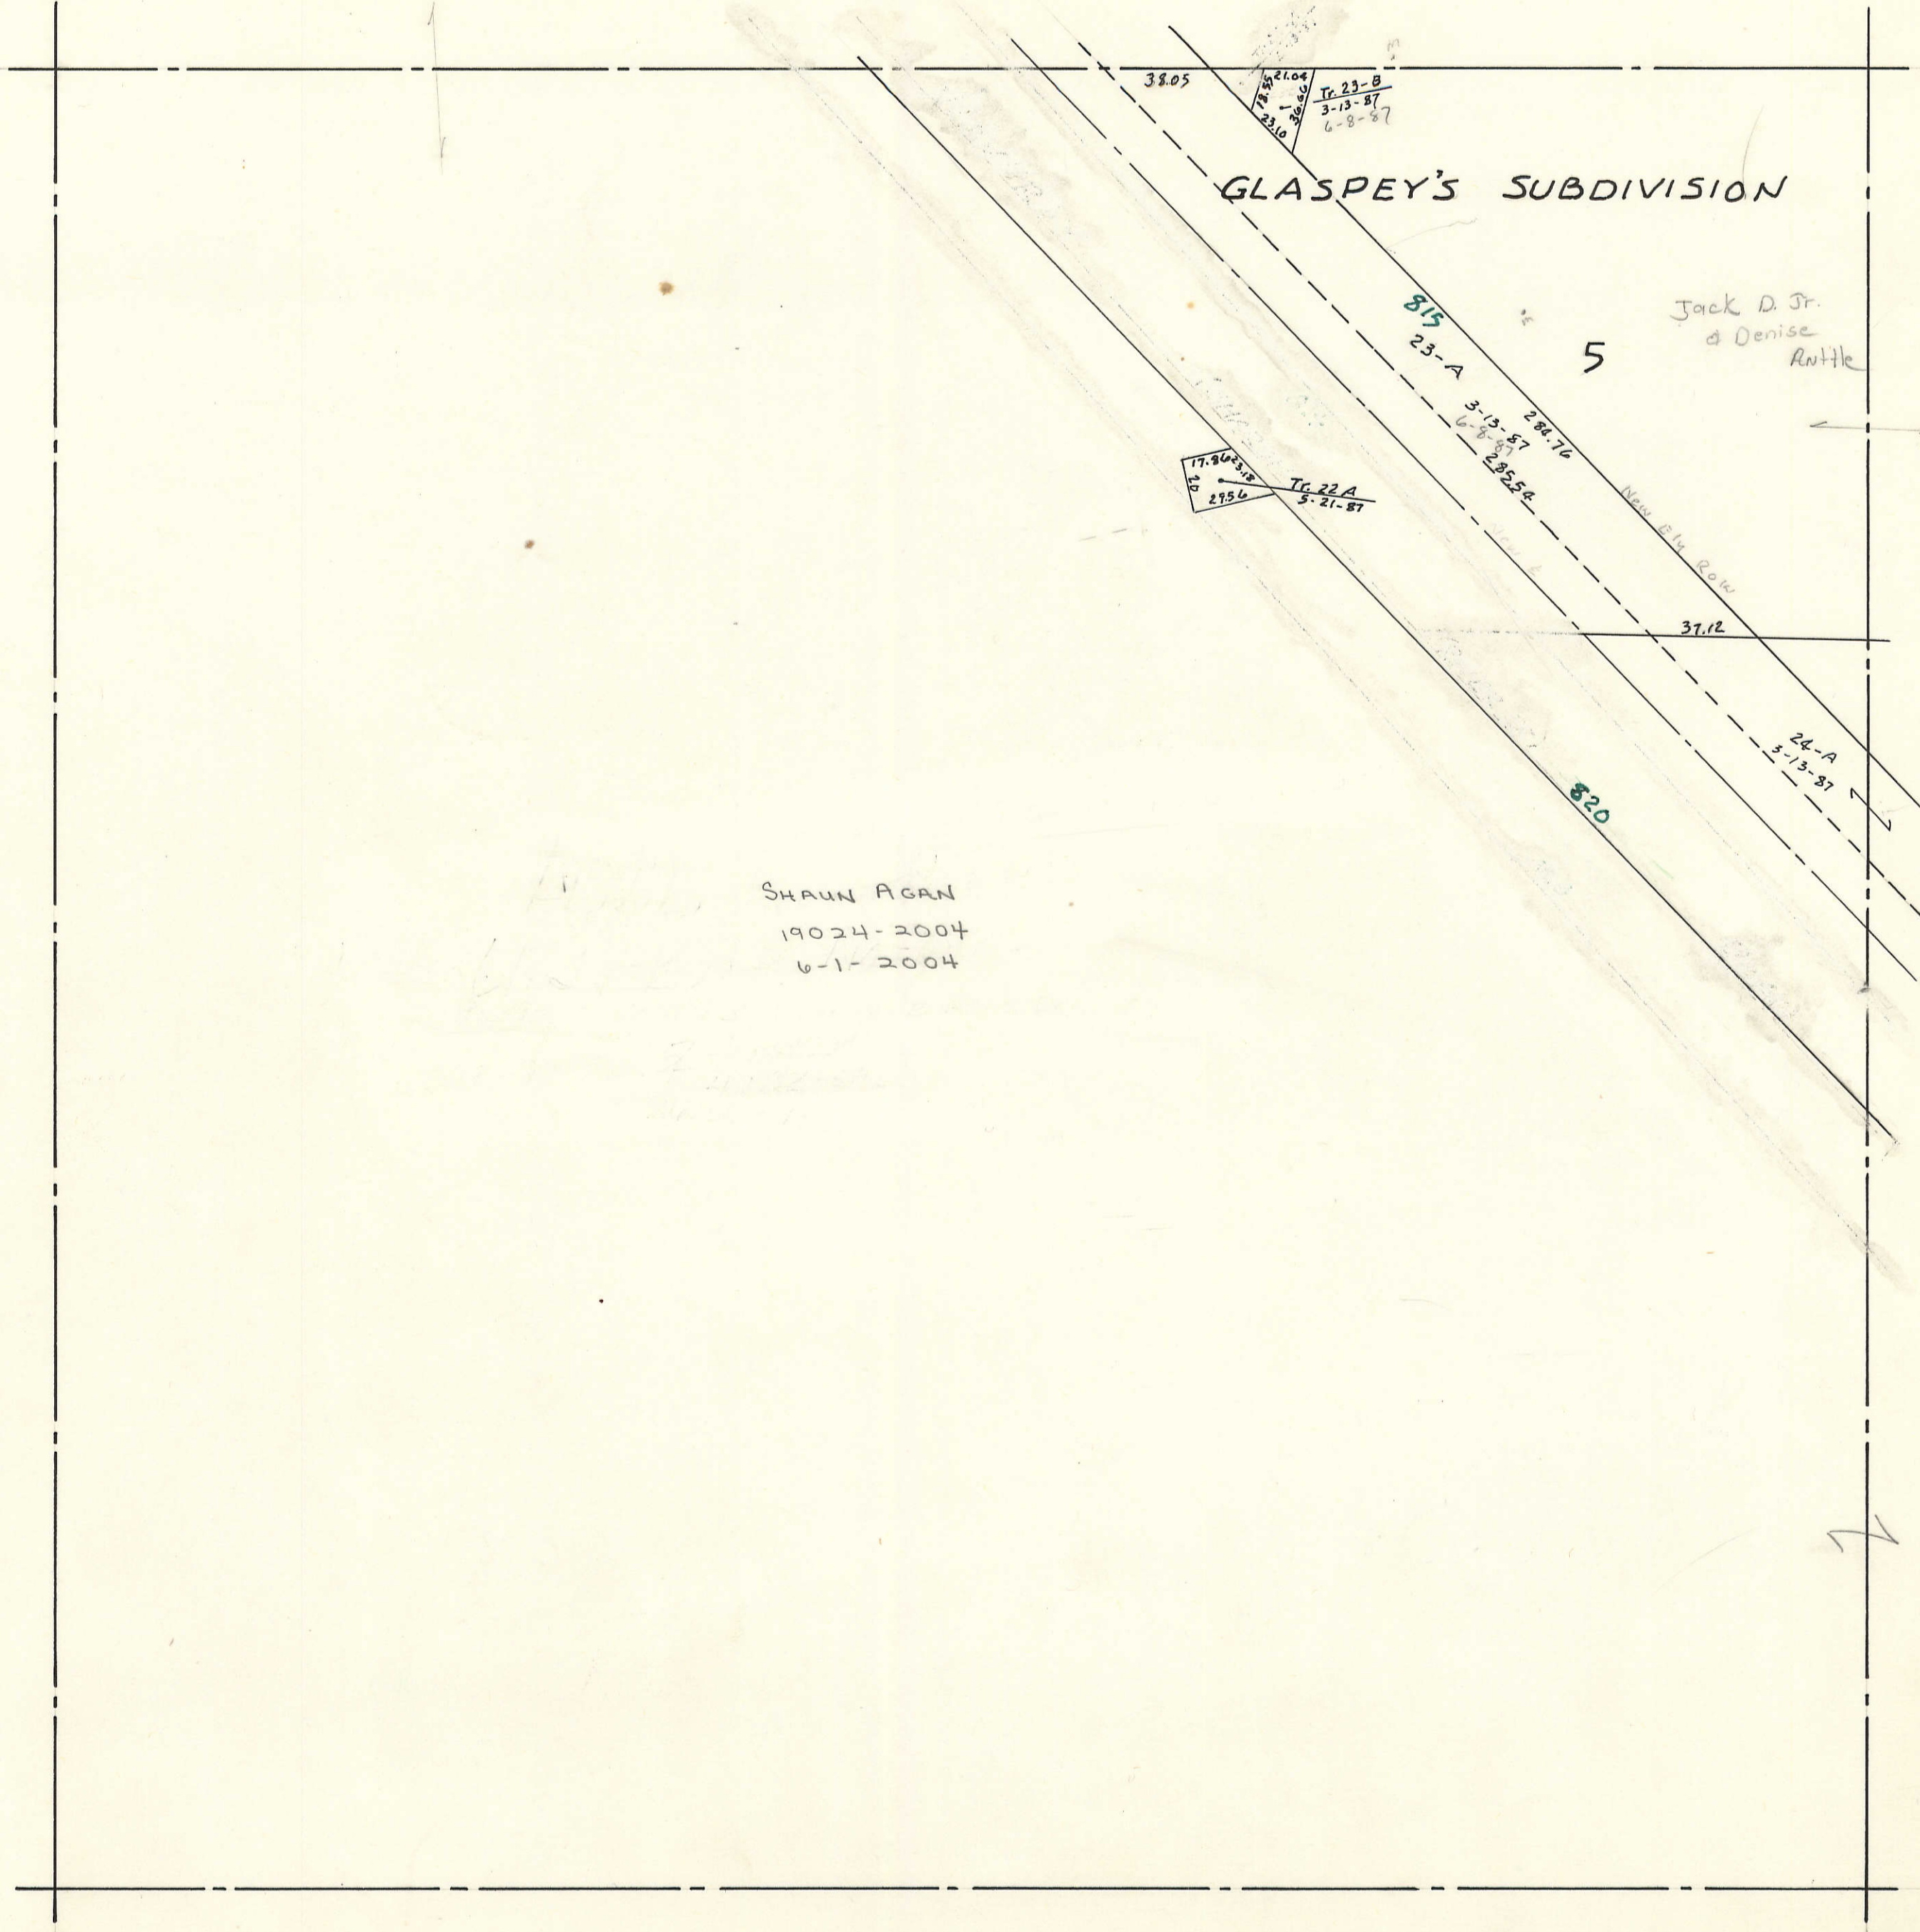

GLASPEY'S SUBDIVISION

815
23-A

5
Jack D. Jr.
& Denise
Ruttle

17.86
29.96
Tr. 22 A
5-21-87

3-13-87
6-8-87
284.76
2,955.4


New 5th Row

37.12

24-A
5-13-87

820

SHAUN AGAN
19024-2004
6-1-2004

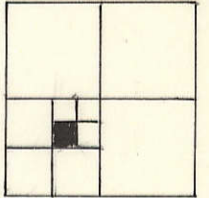

TRANSFER PAGE 2-349

47

45

51