



20' ALLEY

BLK 44 ANTOINE LECLAIRE'S ADD.

DAU: L^v SEC. 35-78-3

7A

HARRISON STREET
80' WIDE
ONE WAY

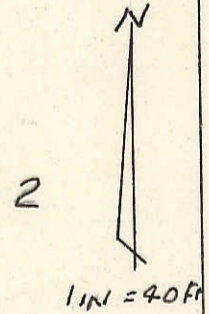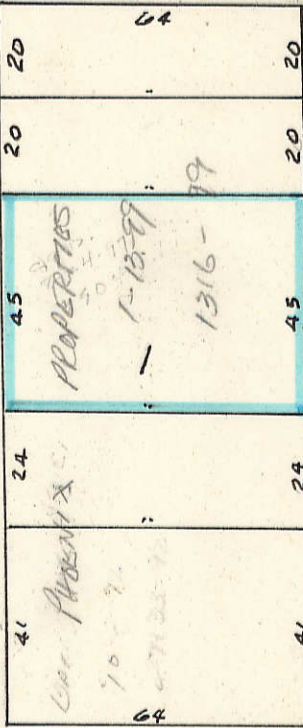

HARRISON ST. CONDOMINIUM

APT. NO.	OWNER
307 1/2	
307 1/2	PHOENIX PROPERTIES
307 1/4	1-13-99 1316-99
309 1/2	28741-73 7-18-94
309 1/3	
309 1/4	

TRANSFER PAGE 15A-2279



VICKIE ANNE PALMER CONDOS

2634-2005
1-27-2005


UNIT #1	75-2007	1-3-2007	73-07
UNIT #2	PALMER COLLEGE FOUNDATION		1-3-07
UNIT #3			

THIRD STREET ONE WAY
80' WIDE

TRANSFER PAGE 6 Lds-204

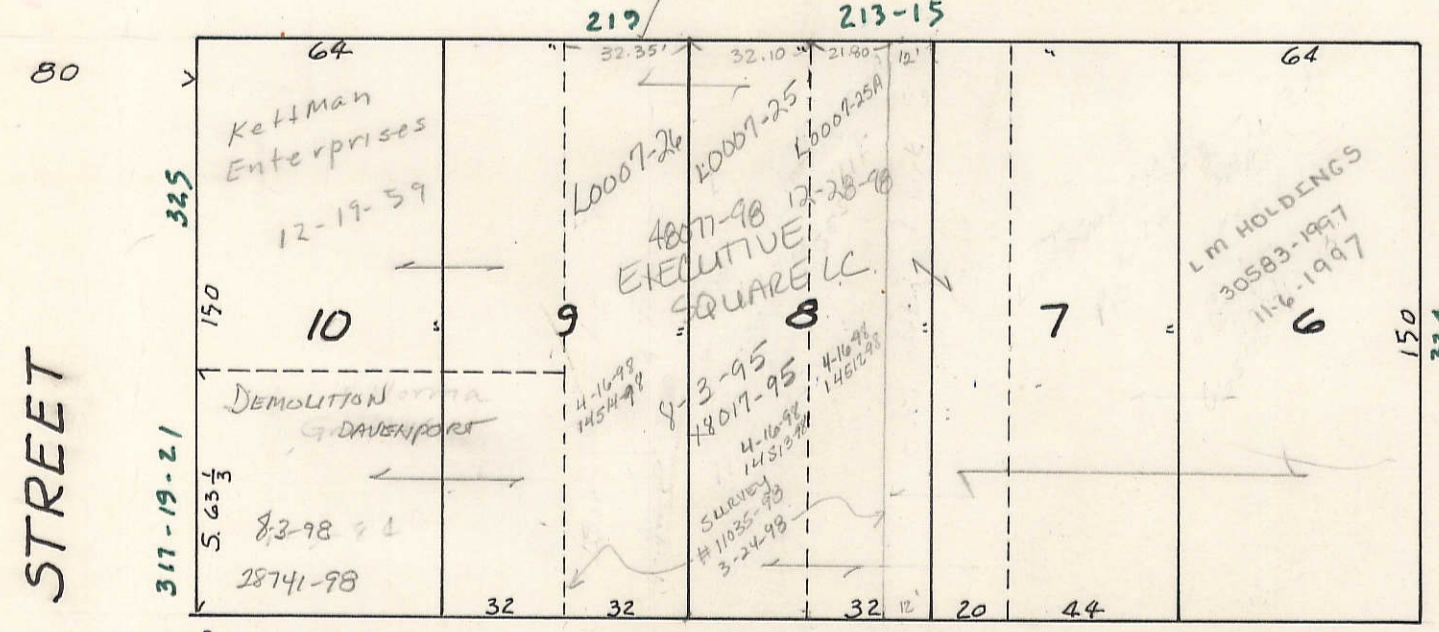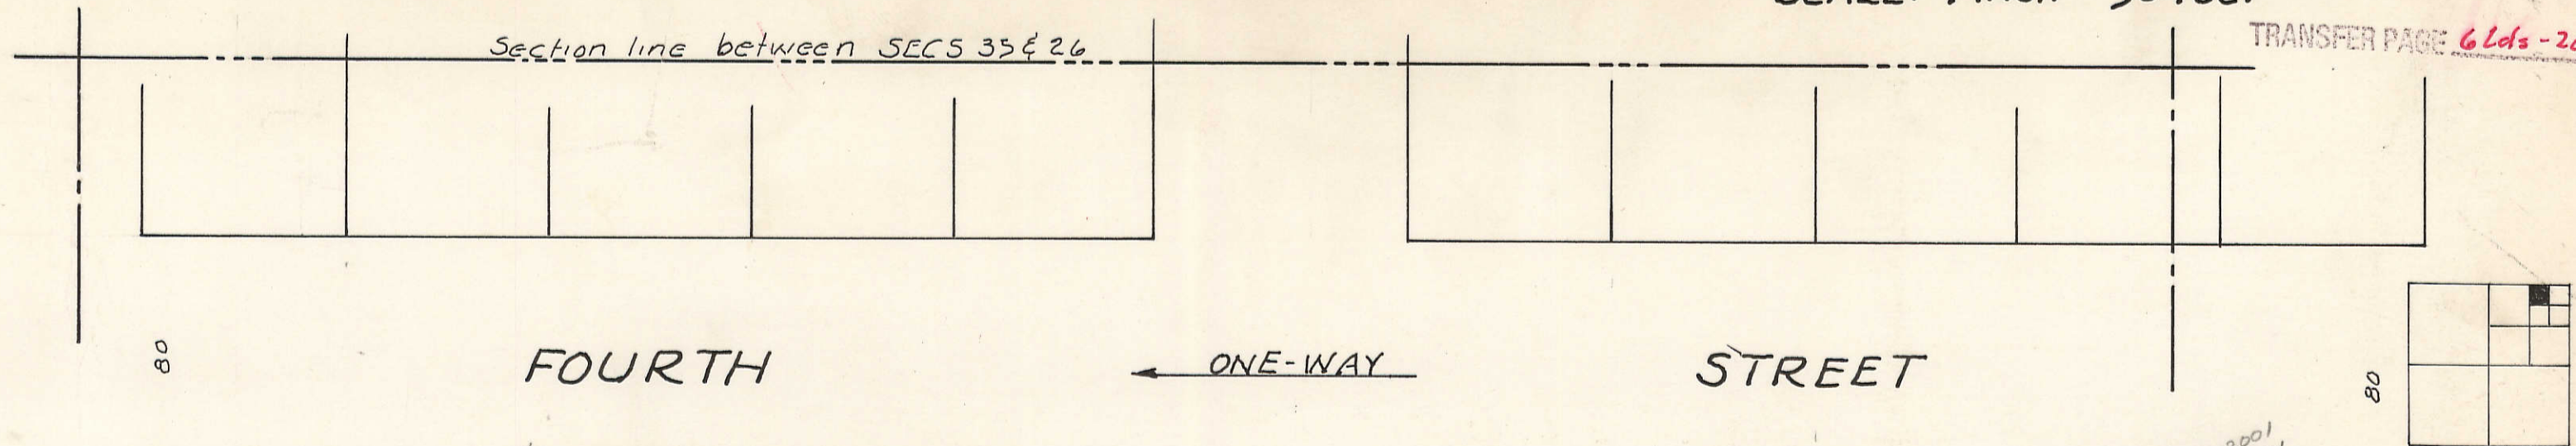


BLK 44 TRANSFER PAGE 4-460

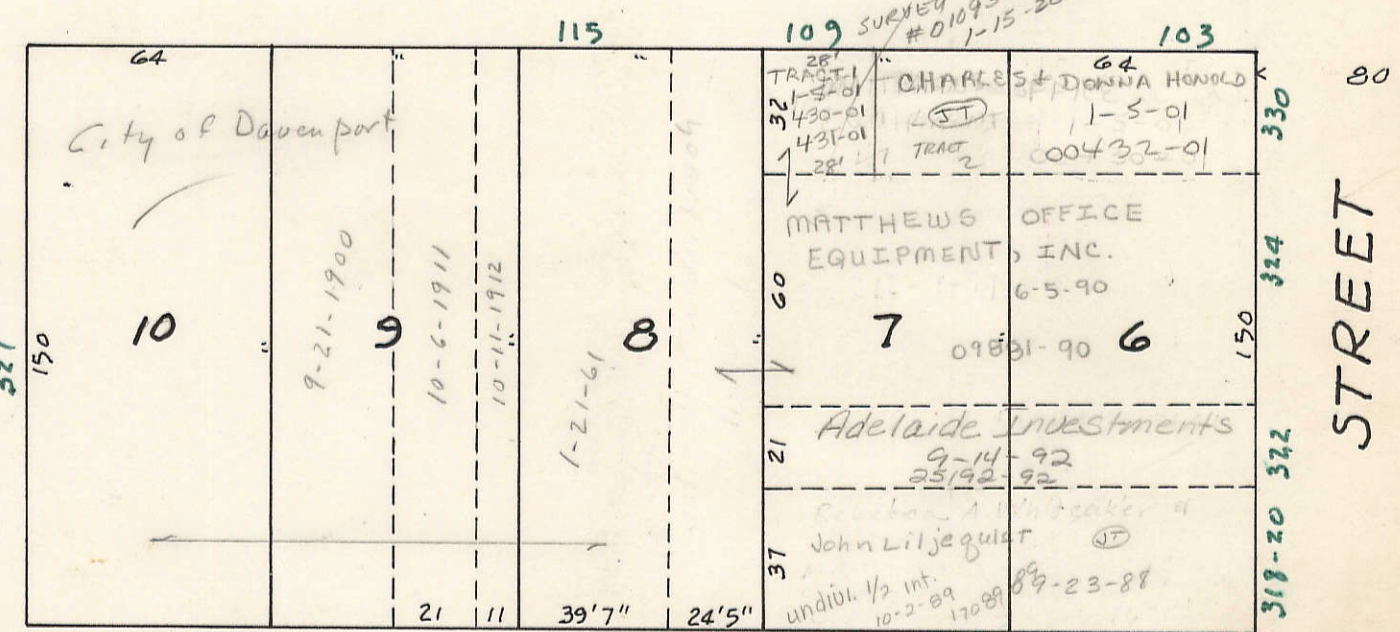


TRANSFER PAGE 4-461 BLK 45

6

ONE-WAY

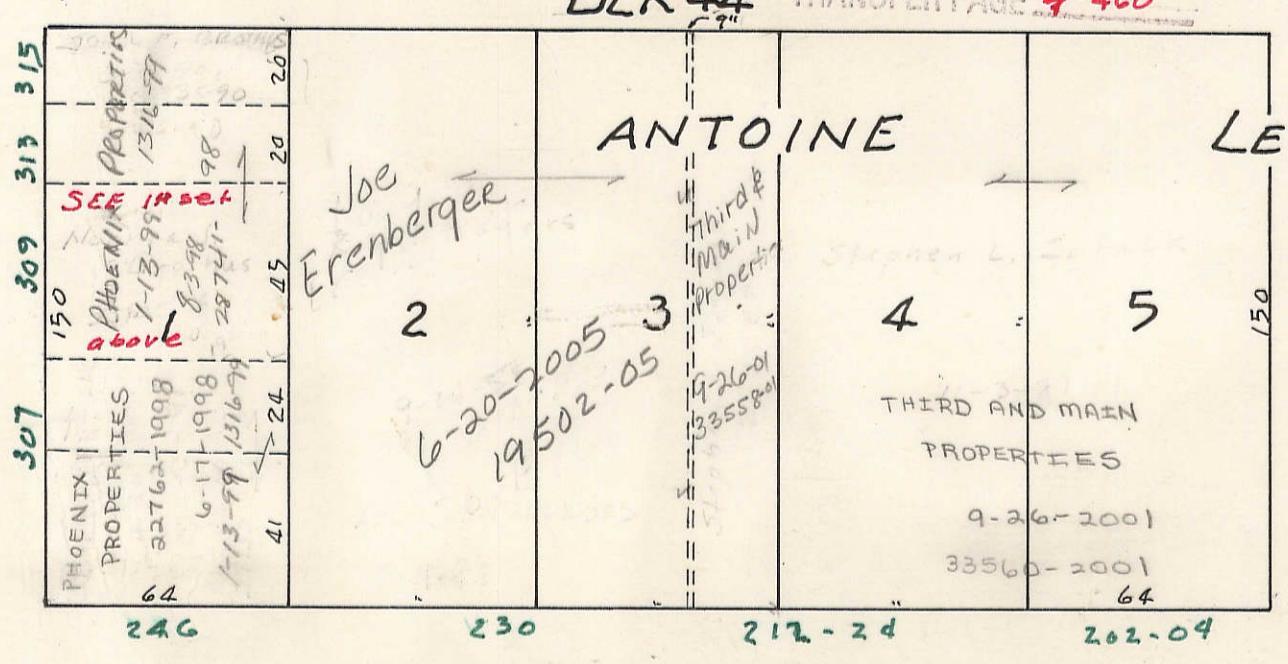

BLK 42 TRANSFER PAGE 4-458

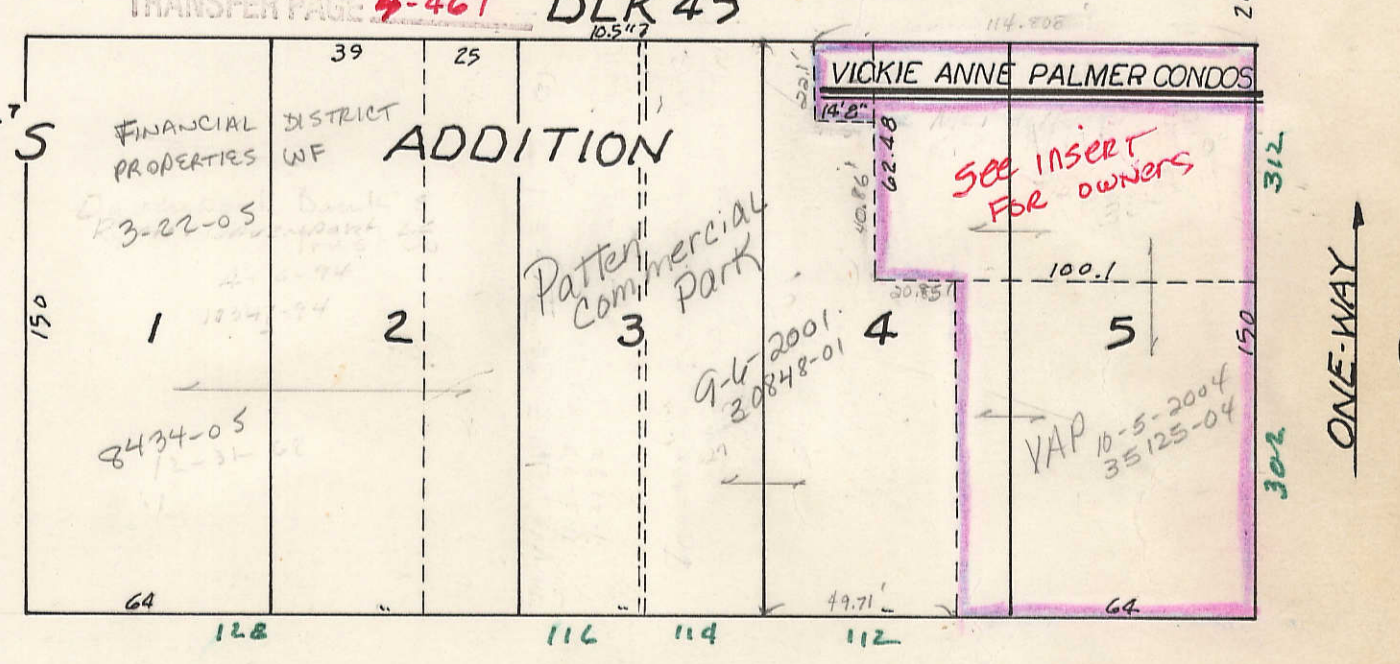


TRANSFER PAGE 4-459 BLK 43

8

ONE-WAY

HARRISON

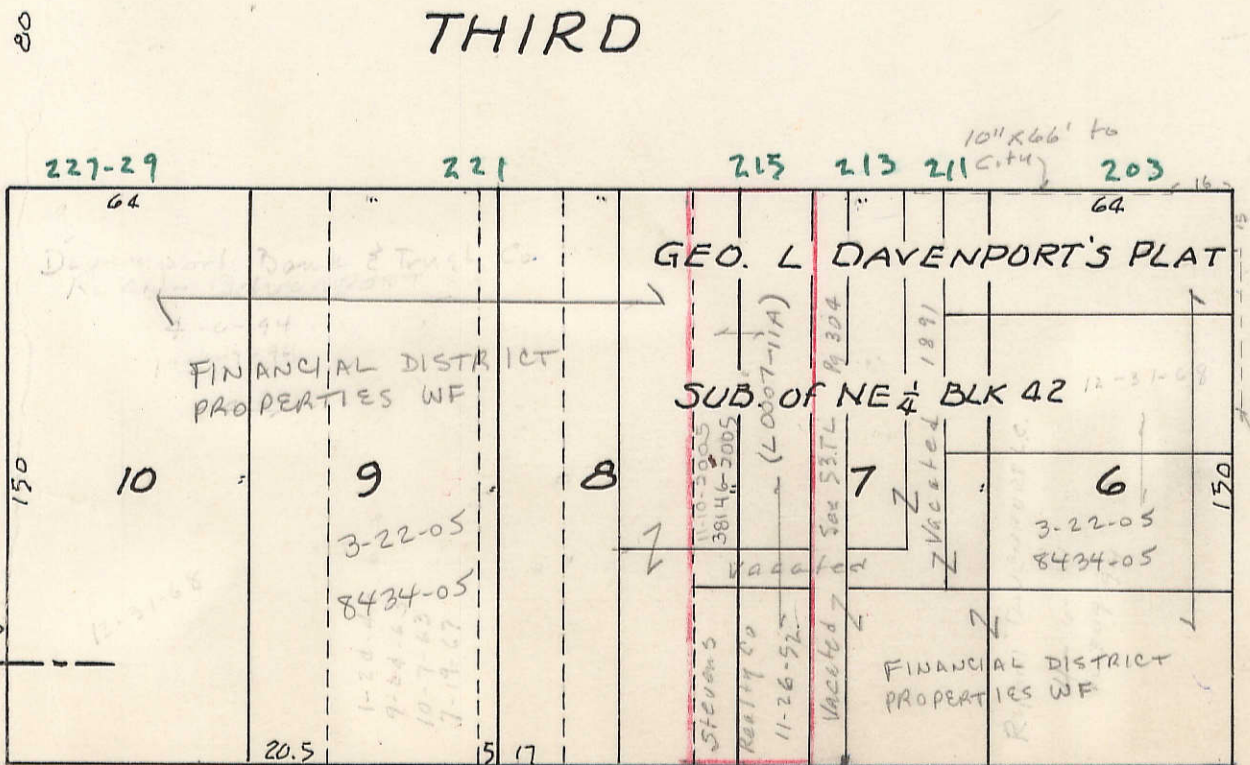

BLK 42 TRANSFER PAGE 4-458

MAIN



TRANSFER PAGE 4-459 BLK 43

BRADY

NOTE: Davenport Bank & Trust Co OWNS N 1/2 BLK 42 except area outlined in red

10