


SE 1/4, NW 1/4 SEC. 17-78-4
SCALE: 1" = 100'

2

8

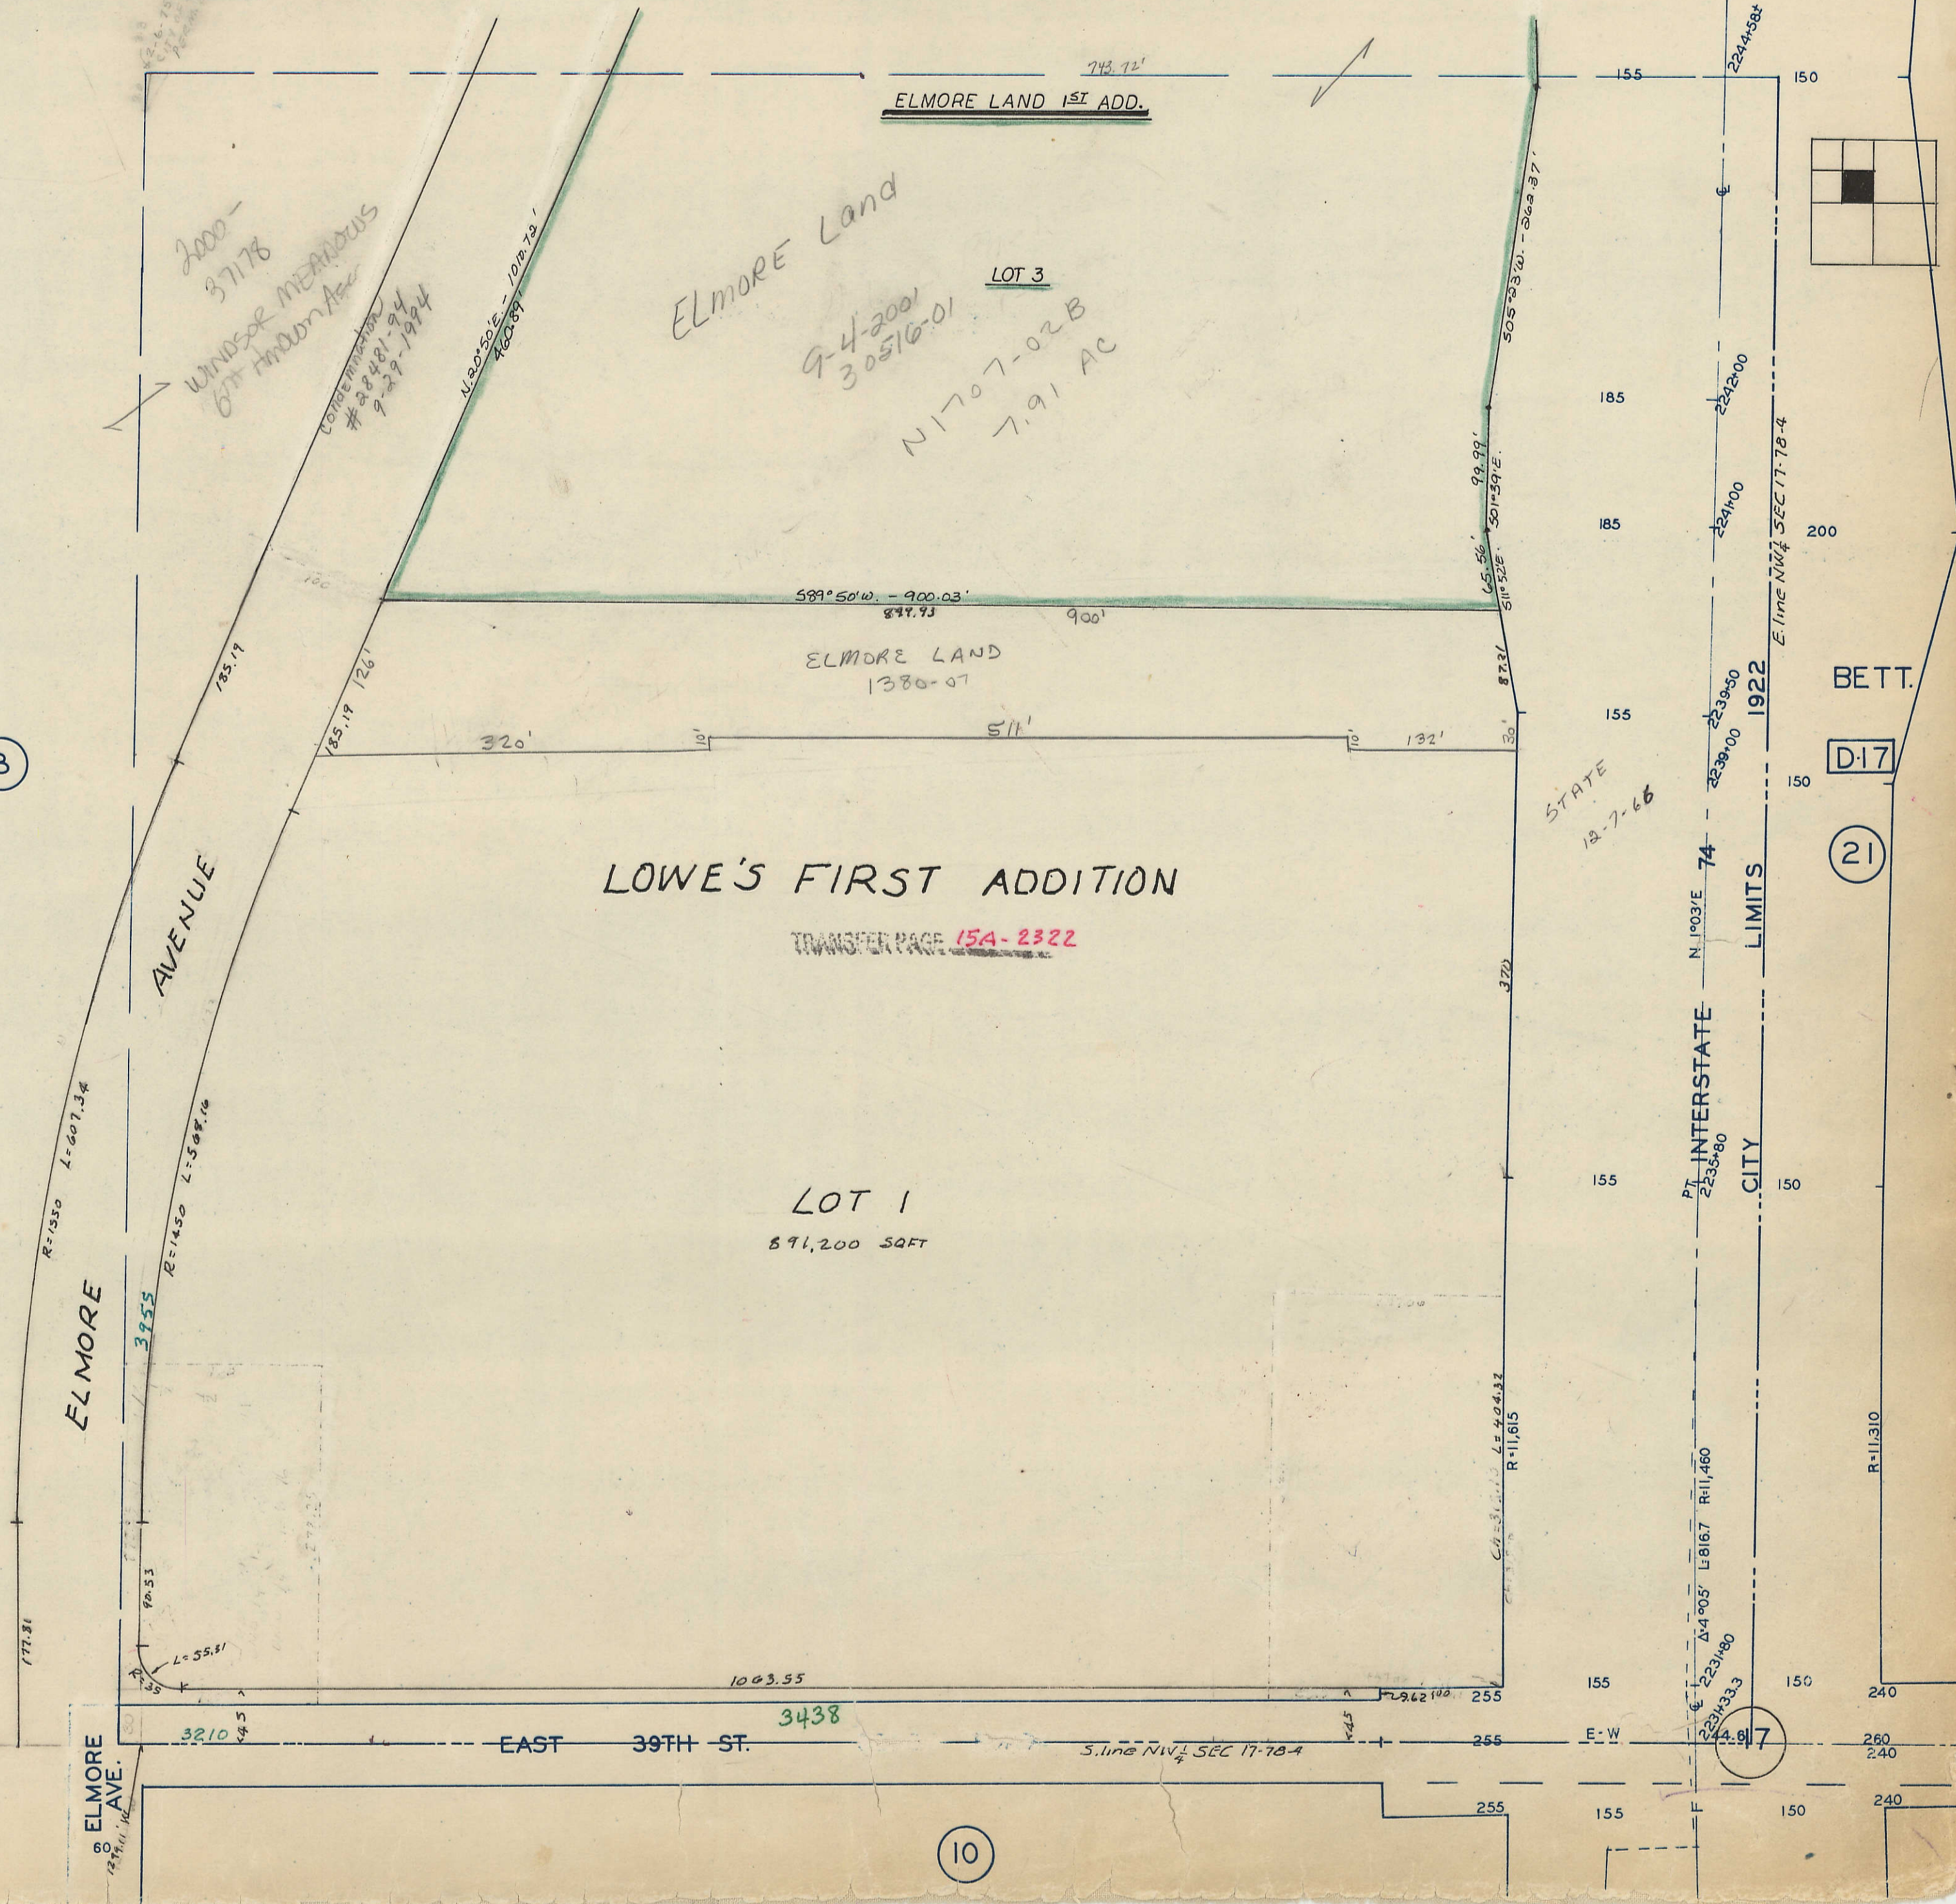

ELMORE Land

2000-37178
WINDSOR MEADOWS
6TH ADDITION

LOT 3
9-4-2001
30516-01
N1707-02B
7.91 AC

ELMORE LAND
1380-07

LOWE'S FIRST ADDITION

LOT 1
891,200 SQFT

ELMORE AVENUE

ELMORE AVENUE

PT. INTERSTATE 74
CITY LIMITS
N. 1° 03' E 74 - 2230-50
2230-80

BETT.

D:17

21

10

17