

NOTE: THE NORTH 1/2 OF THIS PAGE IS LOT 24 & THE SOUTH 1/2 IS THE WEST 1/2 OF LOT 26 OF SCHOOL FUND PLAT

SW 1/4 SW 1/4 SEC 16-78-3  
DAVENPORT  
SCALE: 1" = 100'


33

(Dugout Comm. PK.)

TRANSFER PAGE 15-2107  
Hickory Grove Indust. PK.

T-17  
55

51

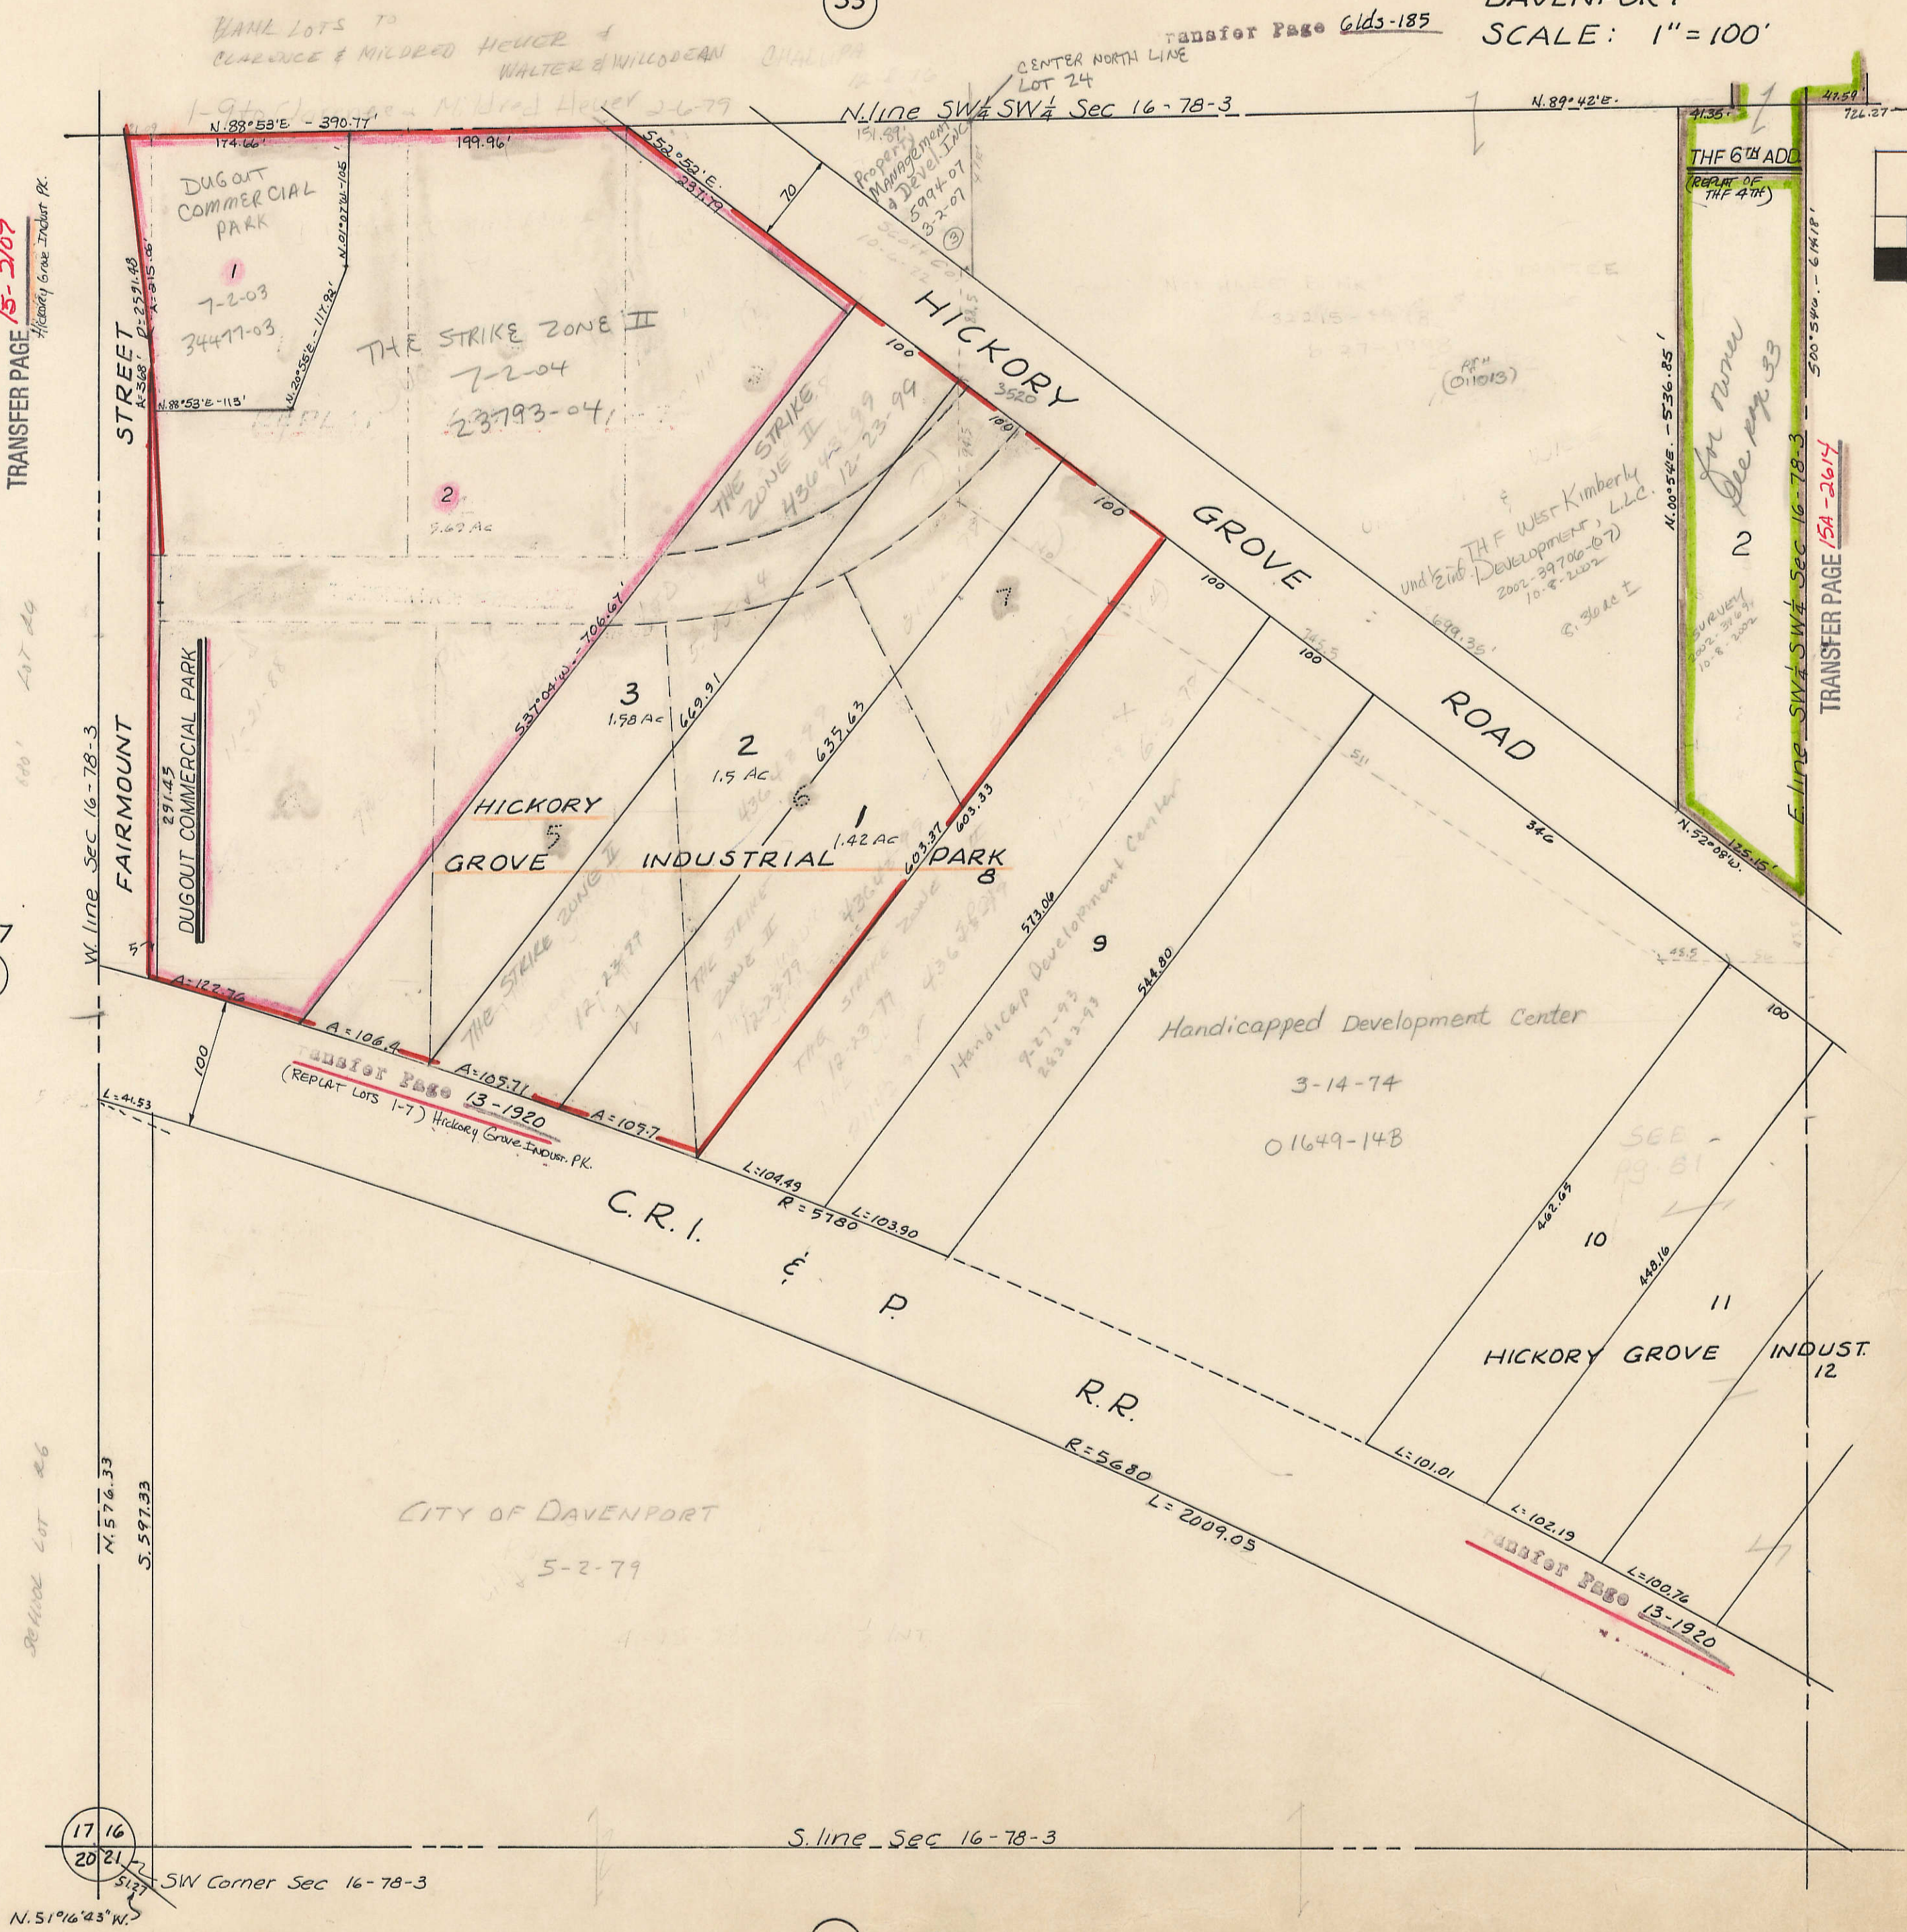

17 16  
20 21  
SW Corner Sec 16-78-3  
N. 51° 16' 43" W.

S. line Sec 16-78-3

1 0-21

