

# 55070-2003  
10-15-2003

COTTAGES AT SHADY GLEN ADD.

- 7750-2005  
3-16-2005  
1 JANICE F DI IULIO  
3-22-05  
8356-05
- 2 JOHN + MARY JANE KILGANNON
- 3-25-2005  
8869-05  
3 Mary A Ross  
5964-2005  
3-1-2005
- 4 ROBERT S SR + SYLVIA BYTNER
- 12-10-04  
43172-04  
5 SEAN + ANNE MARIE FORTIN  
11-19-2004  
40494-2004
- 6 JANICE M GIBBS  
7623-2006
- 7 JOHN HEATING 3-13-2006

- 10-7-04  
35722-04  
8 CARLOS THORNE + ENDIRKA WILLIAMS  
12-6-2004  
42381-2004
- 9 KATE DUFFY LIVING TRUST
- 3-3-06  
6571-06  
10 Barrett Trust  
5-13-2004  
16674-04
- 11 Simpson, Joseph + Vicki
- 9-22-04  
33508-04  
12 COLLEEN B. RUETH  
4-19-2004
- 12-7-2004  
42597-2004  
13 Sylvia Heaton 12985-04
- 14 IRINA MAKHUR


- 55-04  
15562-04  
15 JASON + CATHERINE PASKVAN  
5-3-05
- 16 KRISTINE BARKDOLL 13670-05
- 8-17-2005  
26652-05  
17 Ryan W. Koster
- 18 ROBERT LAKE 9661-07
- 4-17-06  
11378-06  
19 Joyce Hannon
- 25190-2006  
20 SARA J RETH 8-11-2006
- 21



12

14

3

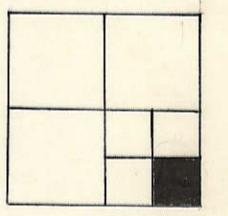

Section line between SECS 12-78-3 & 7-78-4

EASTERN AVENUE

SECTION 7-78-4 VOL N

49


LINKS TO:  
HARMONY  
ENTERPRISES, INC.  
3-7-2008  
11279-02

PUBLIC WORKS FACILITY 1ST ADDITION  
TRANSFER PAGE 151-2362

City of Davenport  
2-21-01

JOHN F. JENKINS & NISLEY  
9150-2005  
4-1-2005

O' BROS. LLC  
2-17-2006  
5157-2006  
(7 DEEDS)

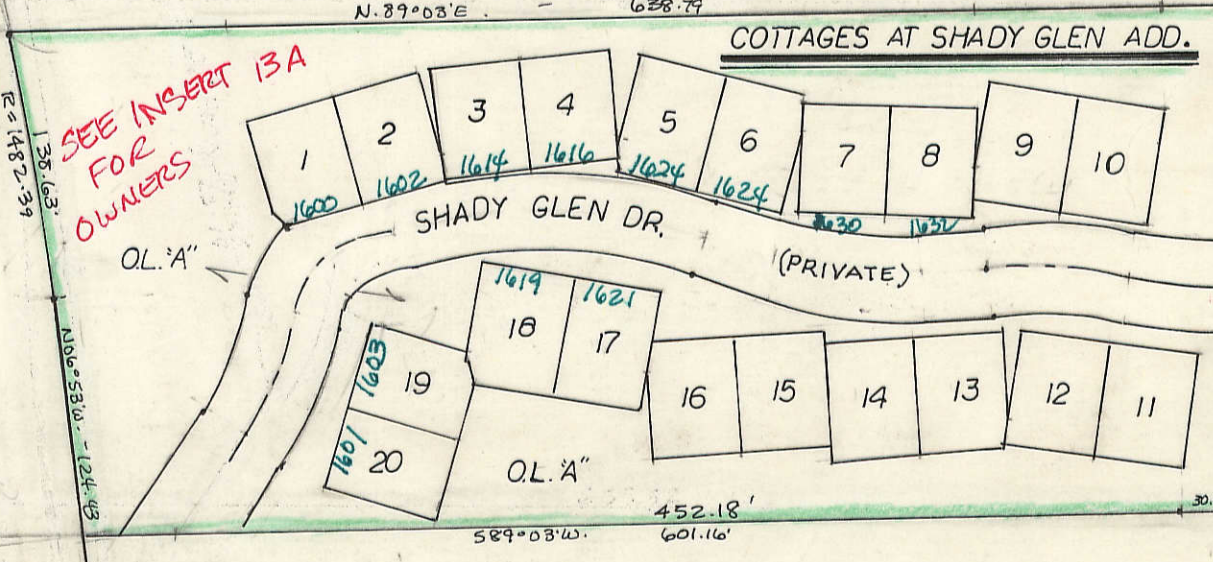

A=542  
R=1391

1574

402'  
S 89°03'E - 402'

5160 MC  
12-21-00

A=540  
R=1391

6 M E S T P RR. 10

12 7  
13 18

R3E  
R4E

4

Blank  
to:  
City of Davenport  
4-03-07-06  
2-30-06

46th St.