


TRANSFER PAGE 645-181

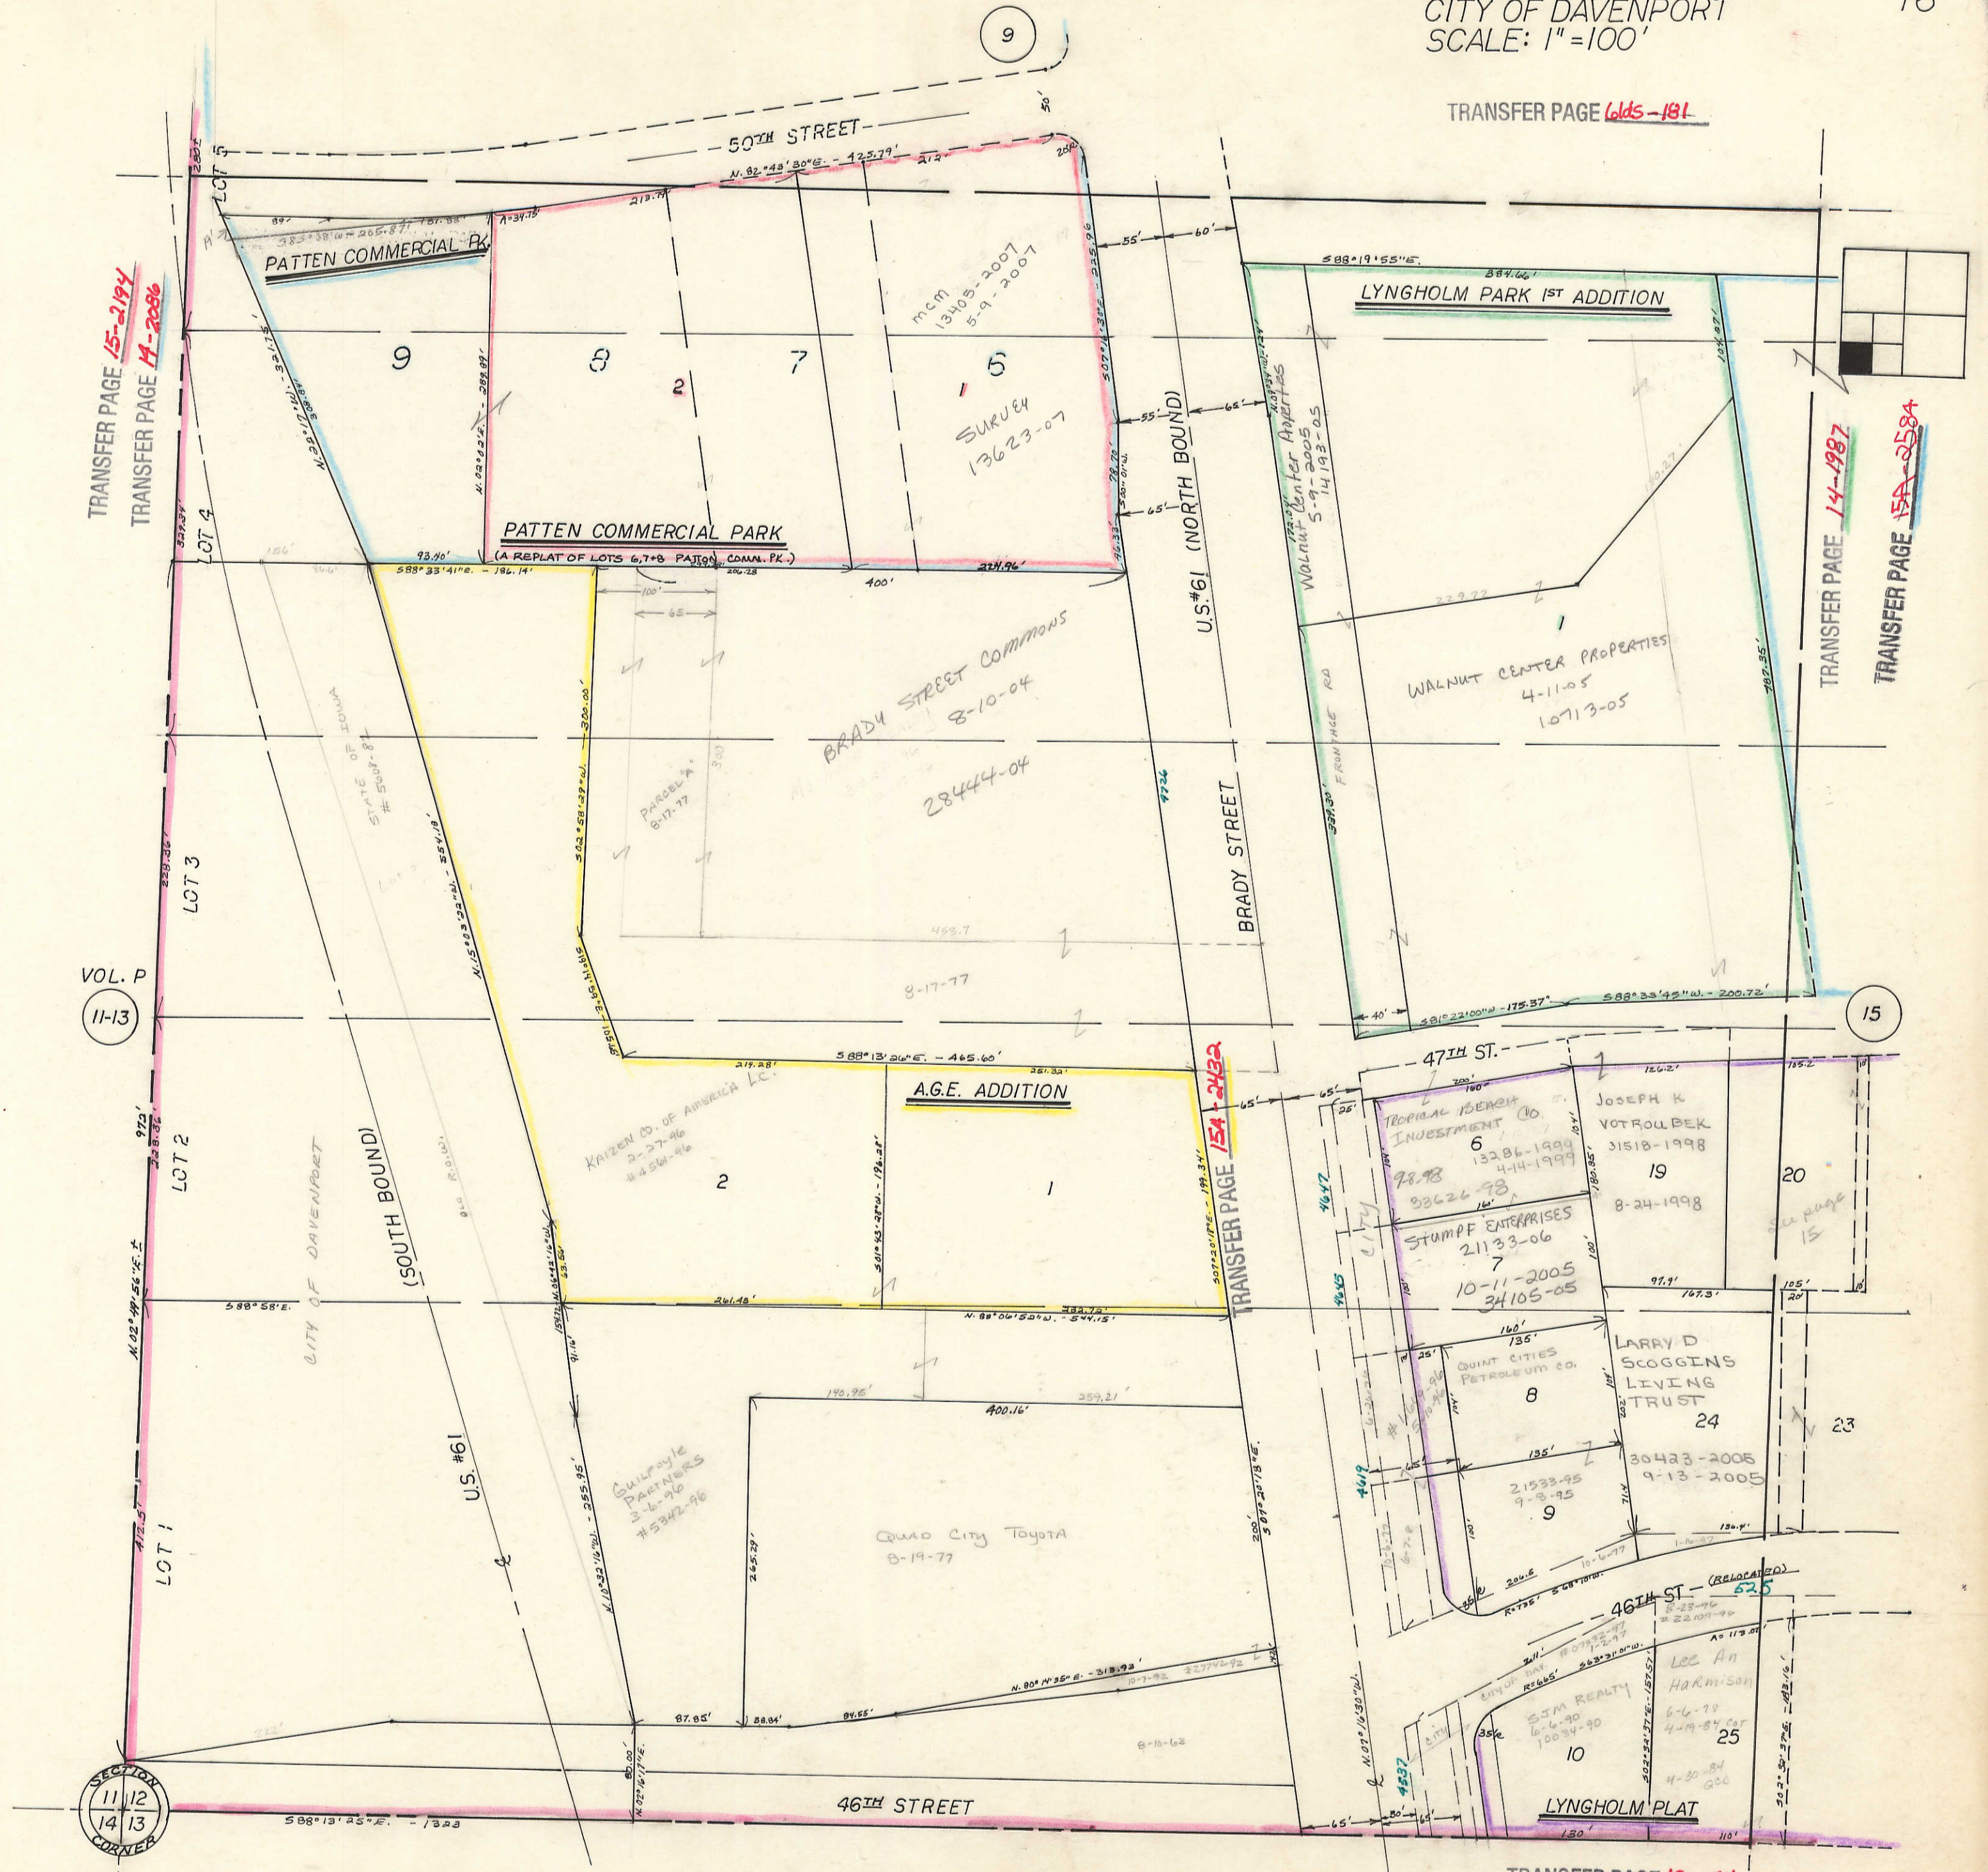

TRANSFER PAGE 15-2194
TRANSFER PAGE H-2086

TRANSFER PAGE 14-1987
TRANSFER PAGE SA-2584

TRANSFER PAGE 154-2432

TRANSFER PAGE 12-154

VOL. P
11-13

VOL. P
13-1

DR. I. LANGER'S OUTLOTS
TRANSFER PAGE 6-181 L45

SECTION CORNER
11 12
14 13