



Transfer Page 8lds-414

SW-SW-NE 4-77-3
Scale 50ft=1in

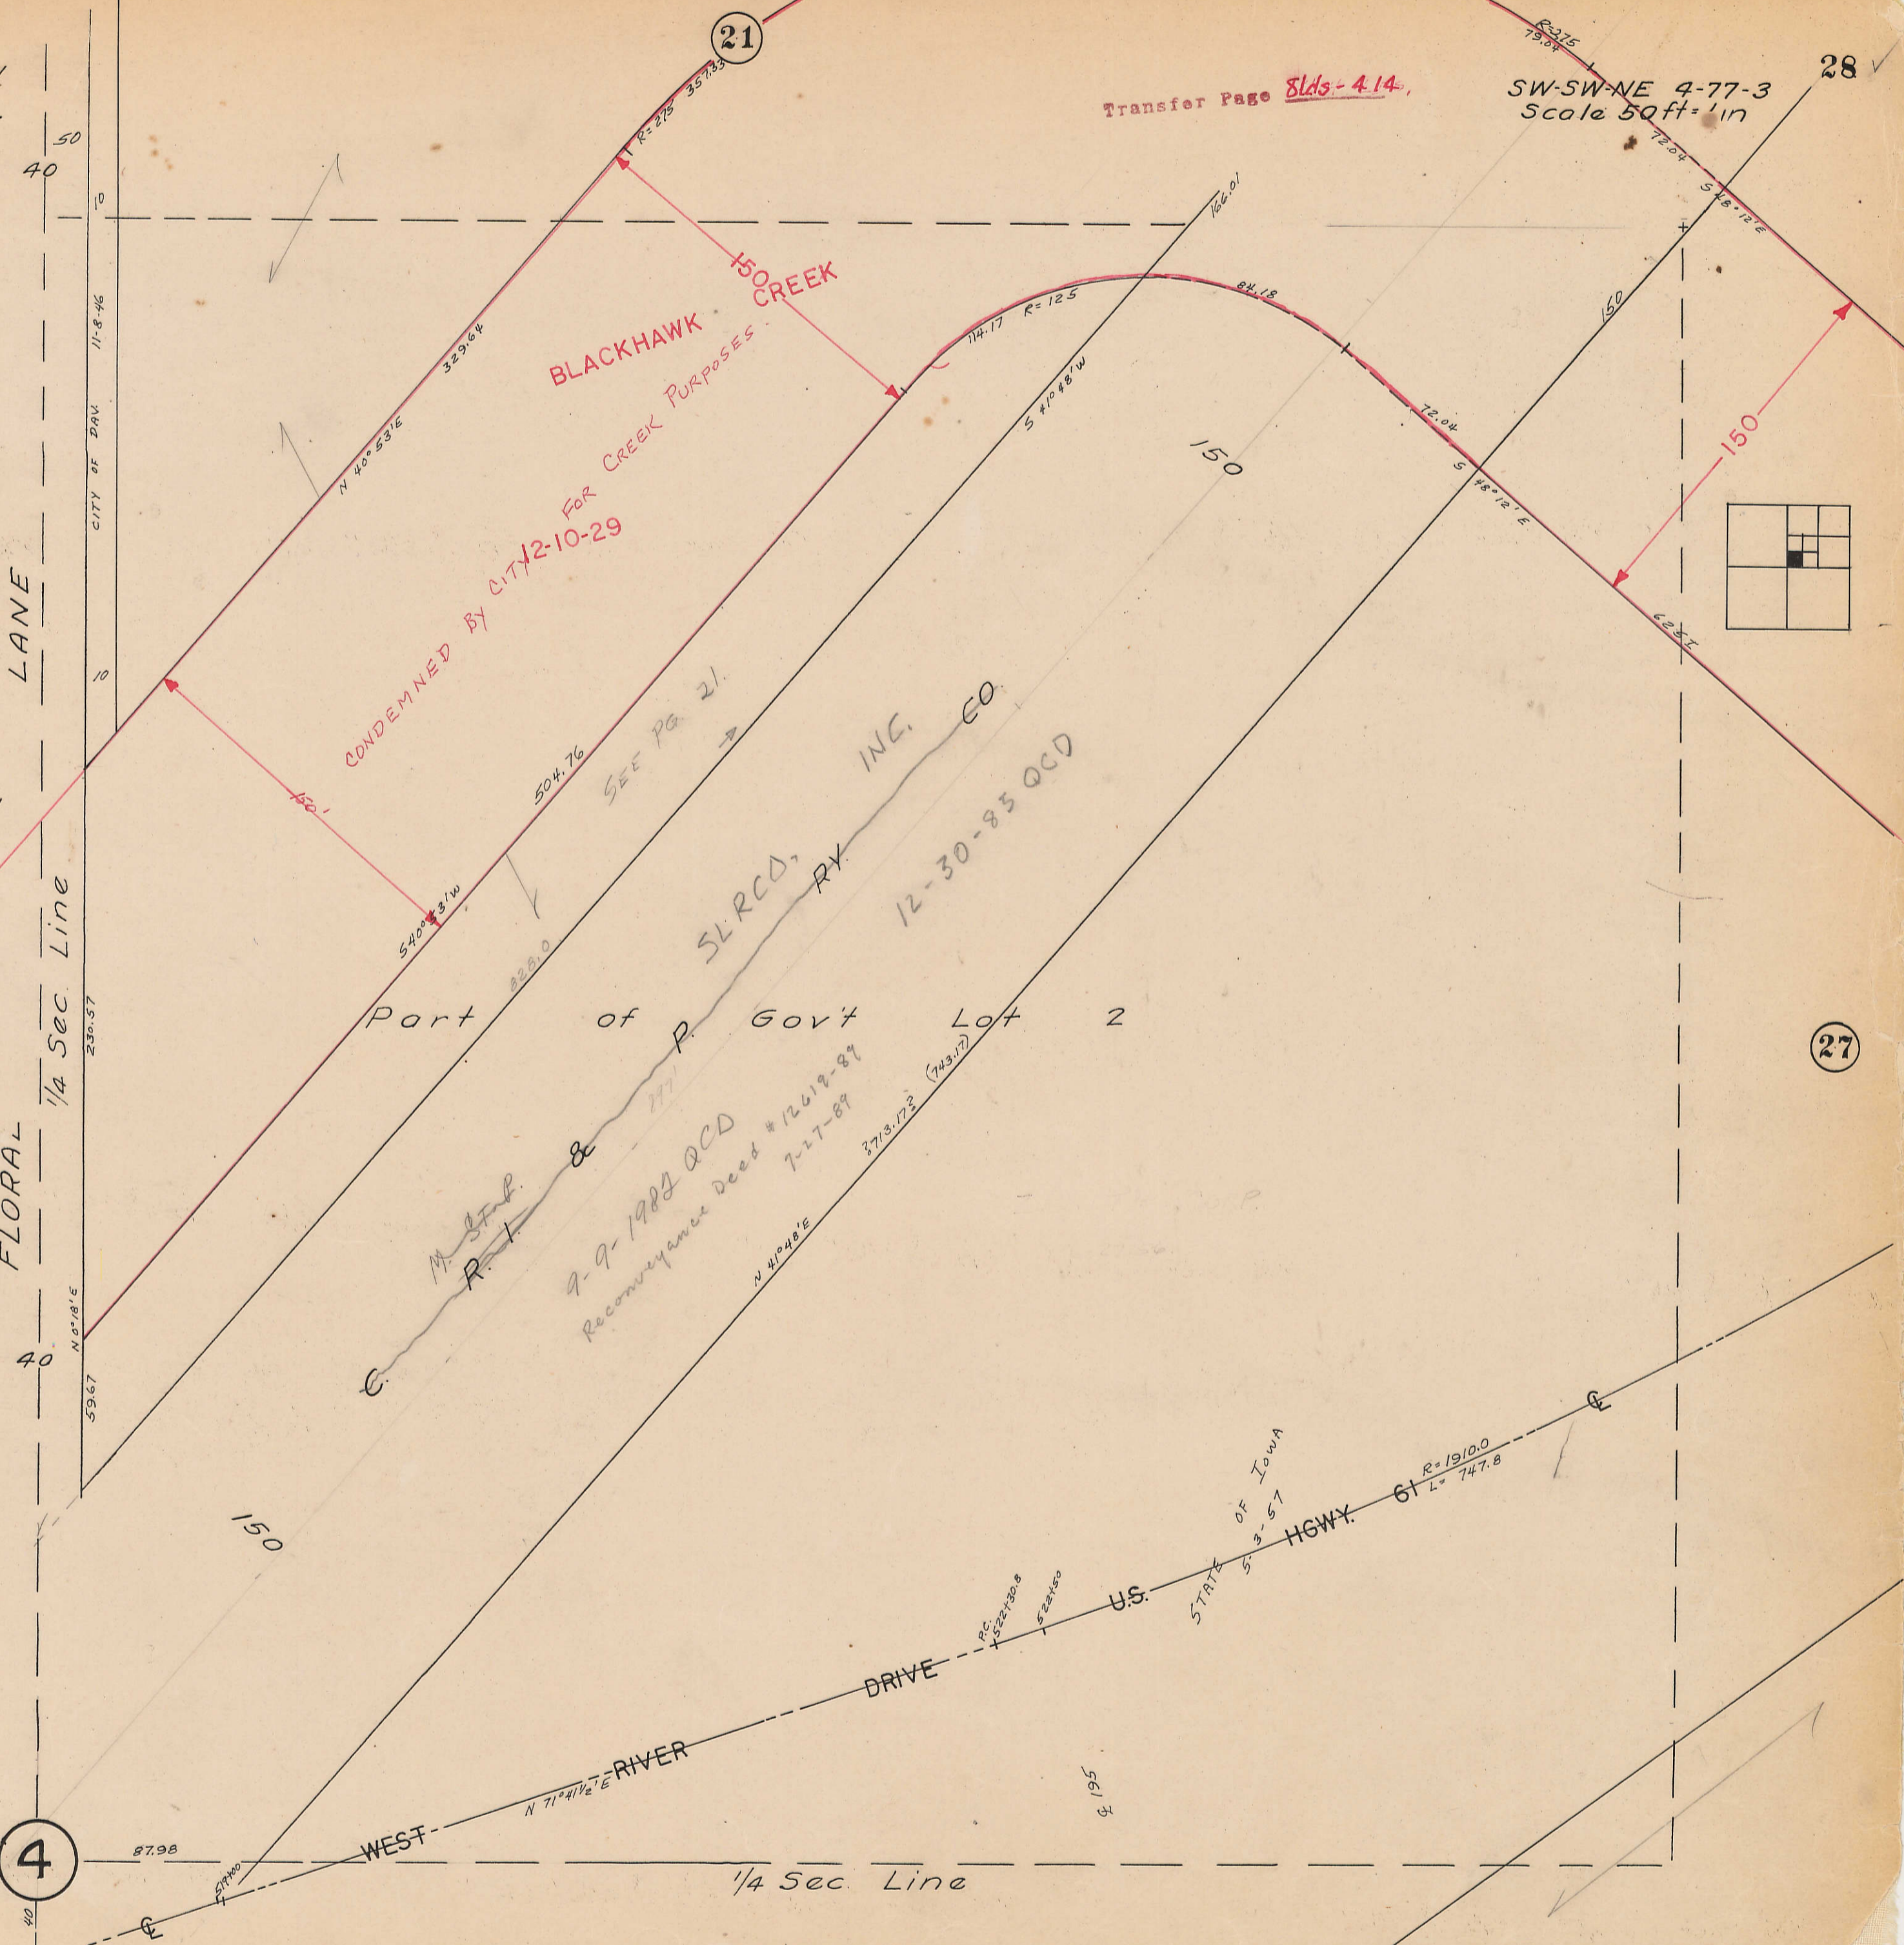

CONDEMNED BY CITY 12-10-29
FOR CREEK PURPOSES

Part of P. Govt Lot 2
M. Stab. R. I. & P. Govt
9-9-1983 QCD
Reconveyance Deed #12619-89
7-27-89
3713.173 (743.17)
N 41° 48' E