



(44)

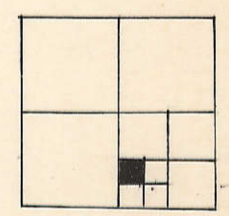

VOL R-2
SEC 5
(51)

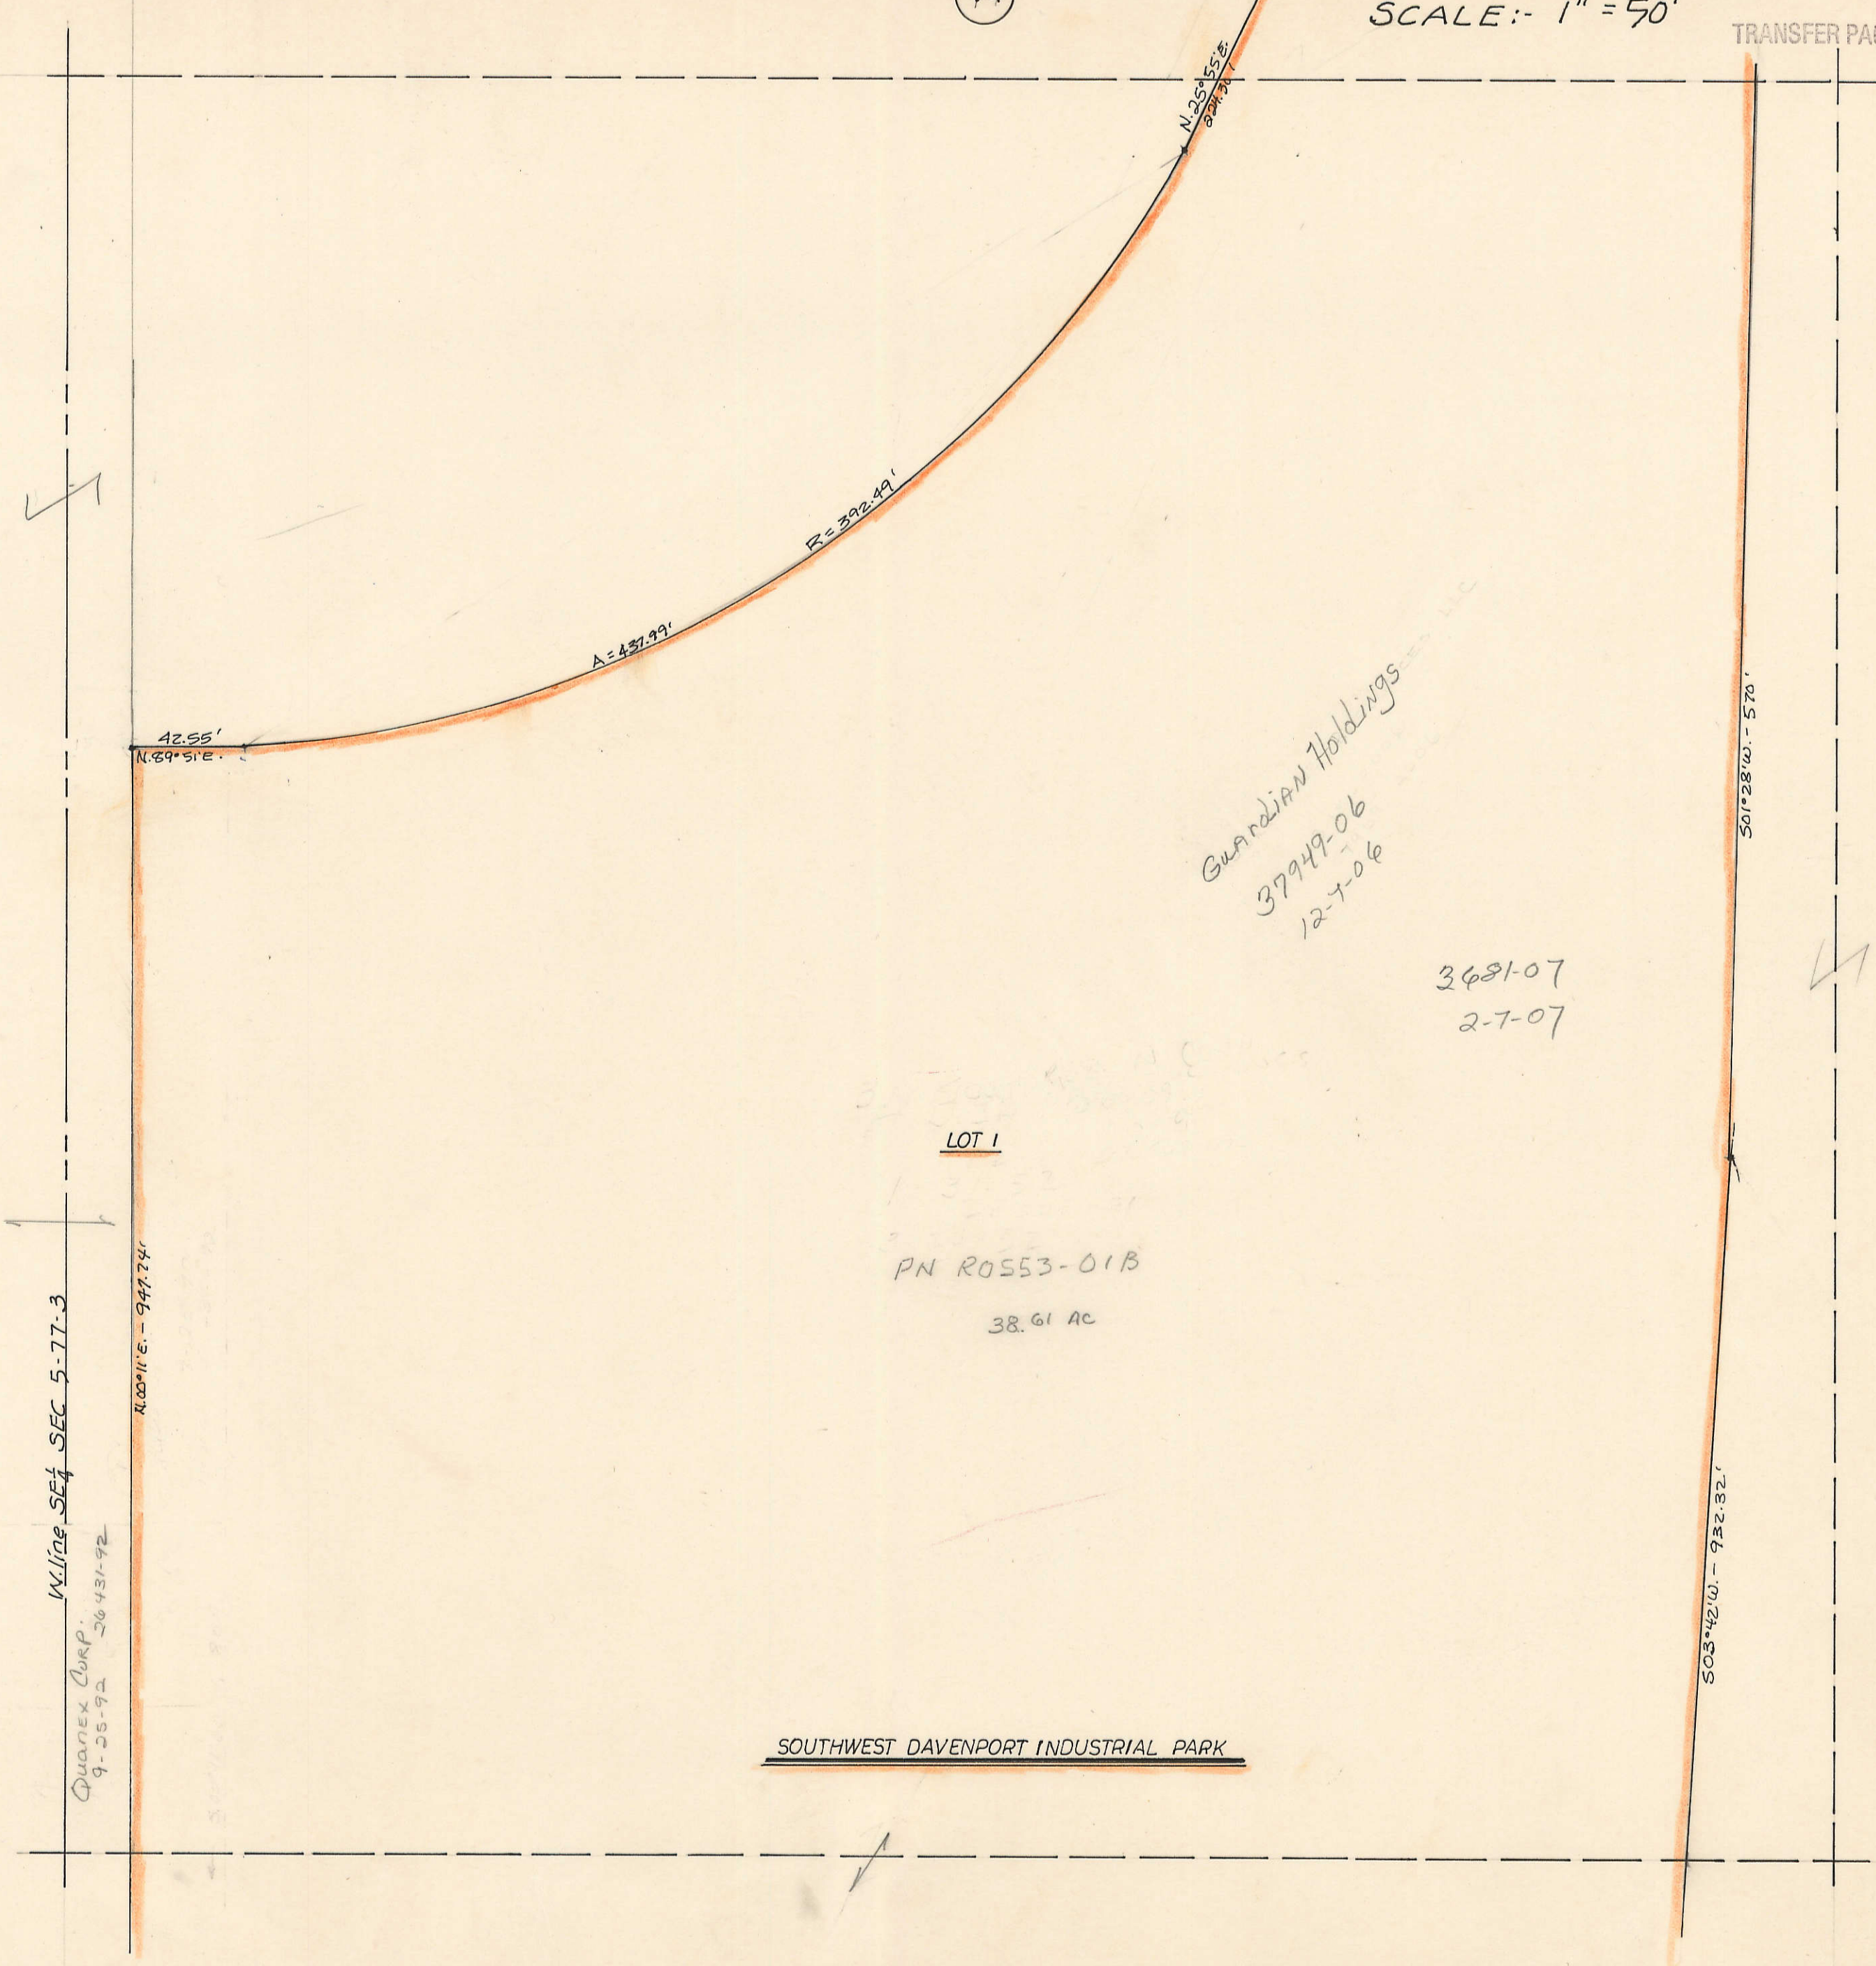

W. line SE 1/4 SEC 5-77-3
Quarx Corp.
9-25-92 26431-92

SOUTHWEST DAVENPORT INDUSTRIAL PARK


(60)

(54)