

SE-NE-NE 5-77-3  
Scale 50ft=1in



FOSTER'S REPLAT

MCCLEAN'S REPLAT  
HARVEST ACRES

10

BLESSING GARDENS FIRST ADD.

CITY OF DAVENPORT  
ROCKINGHAM Sec 5

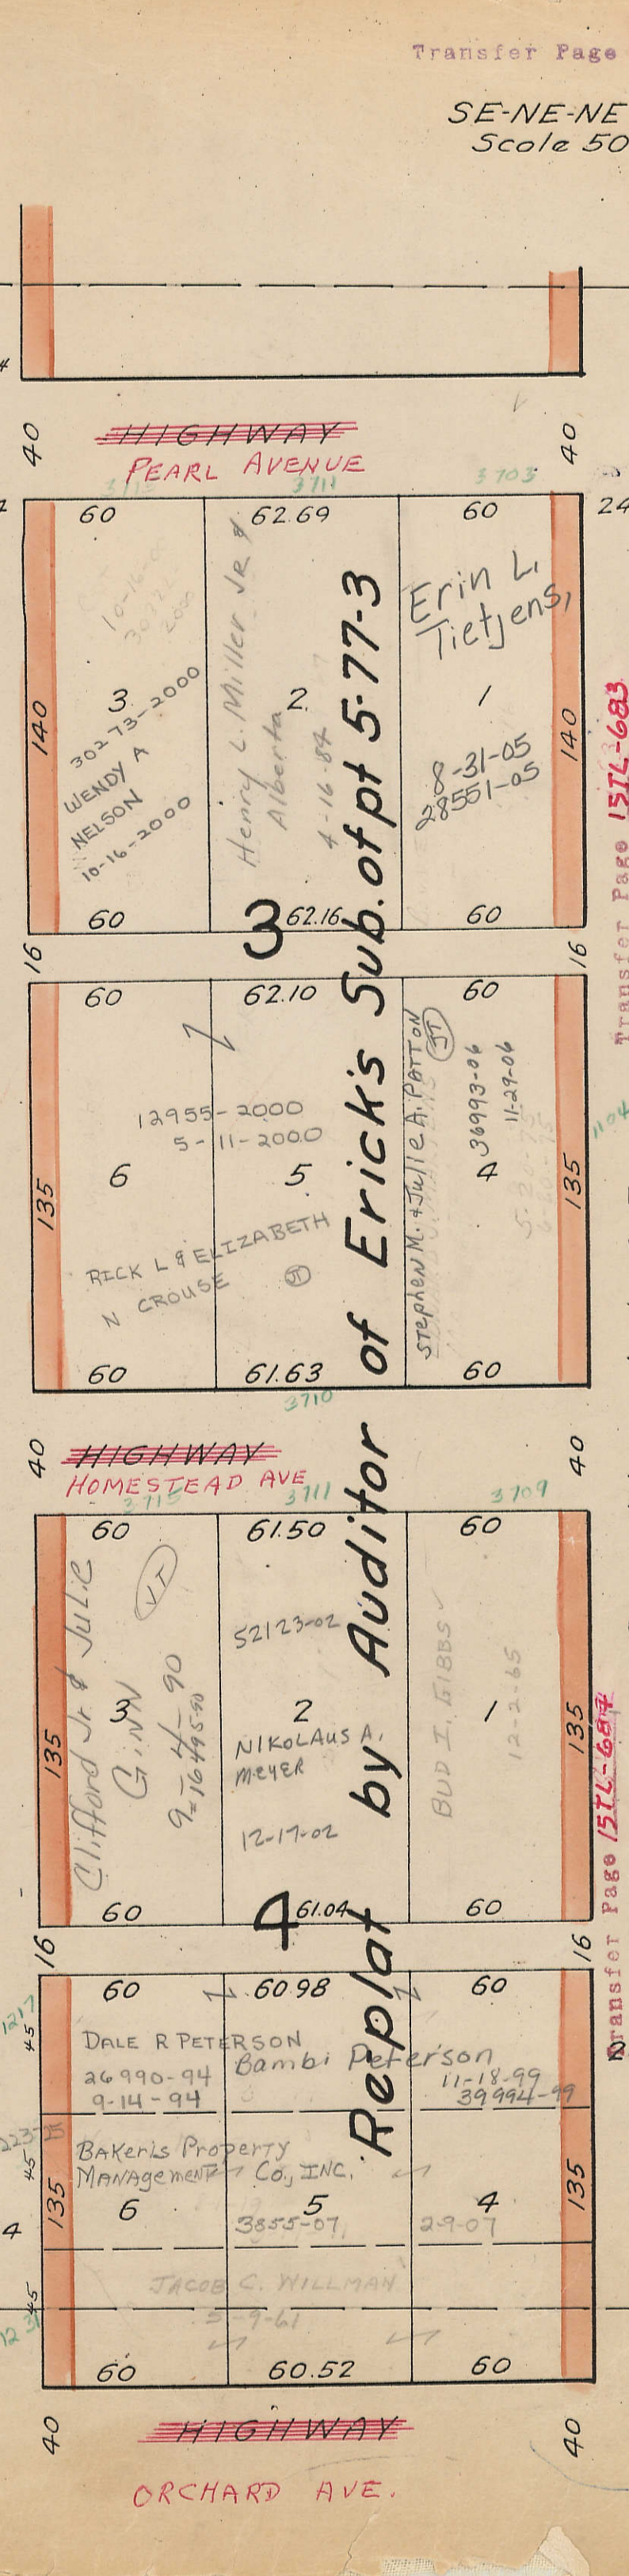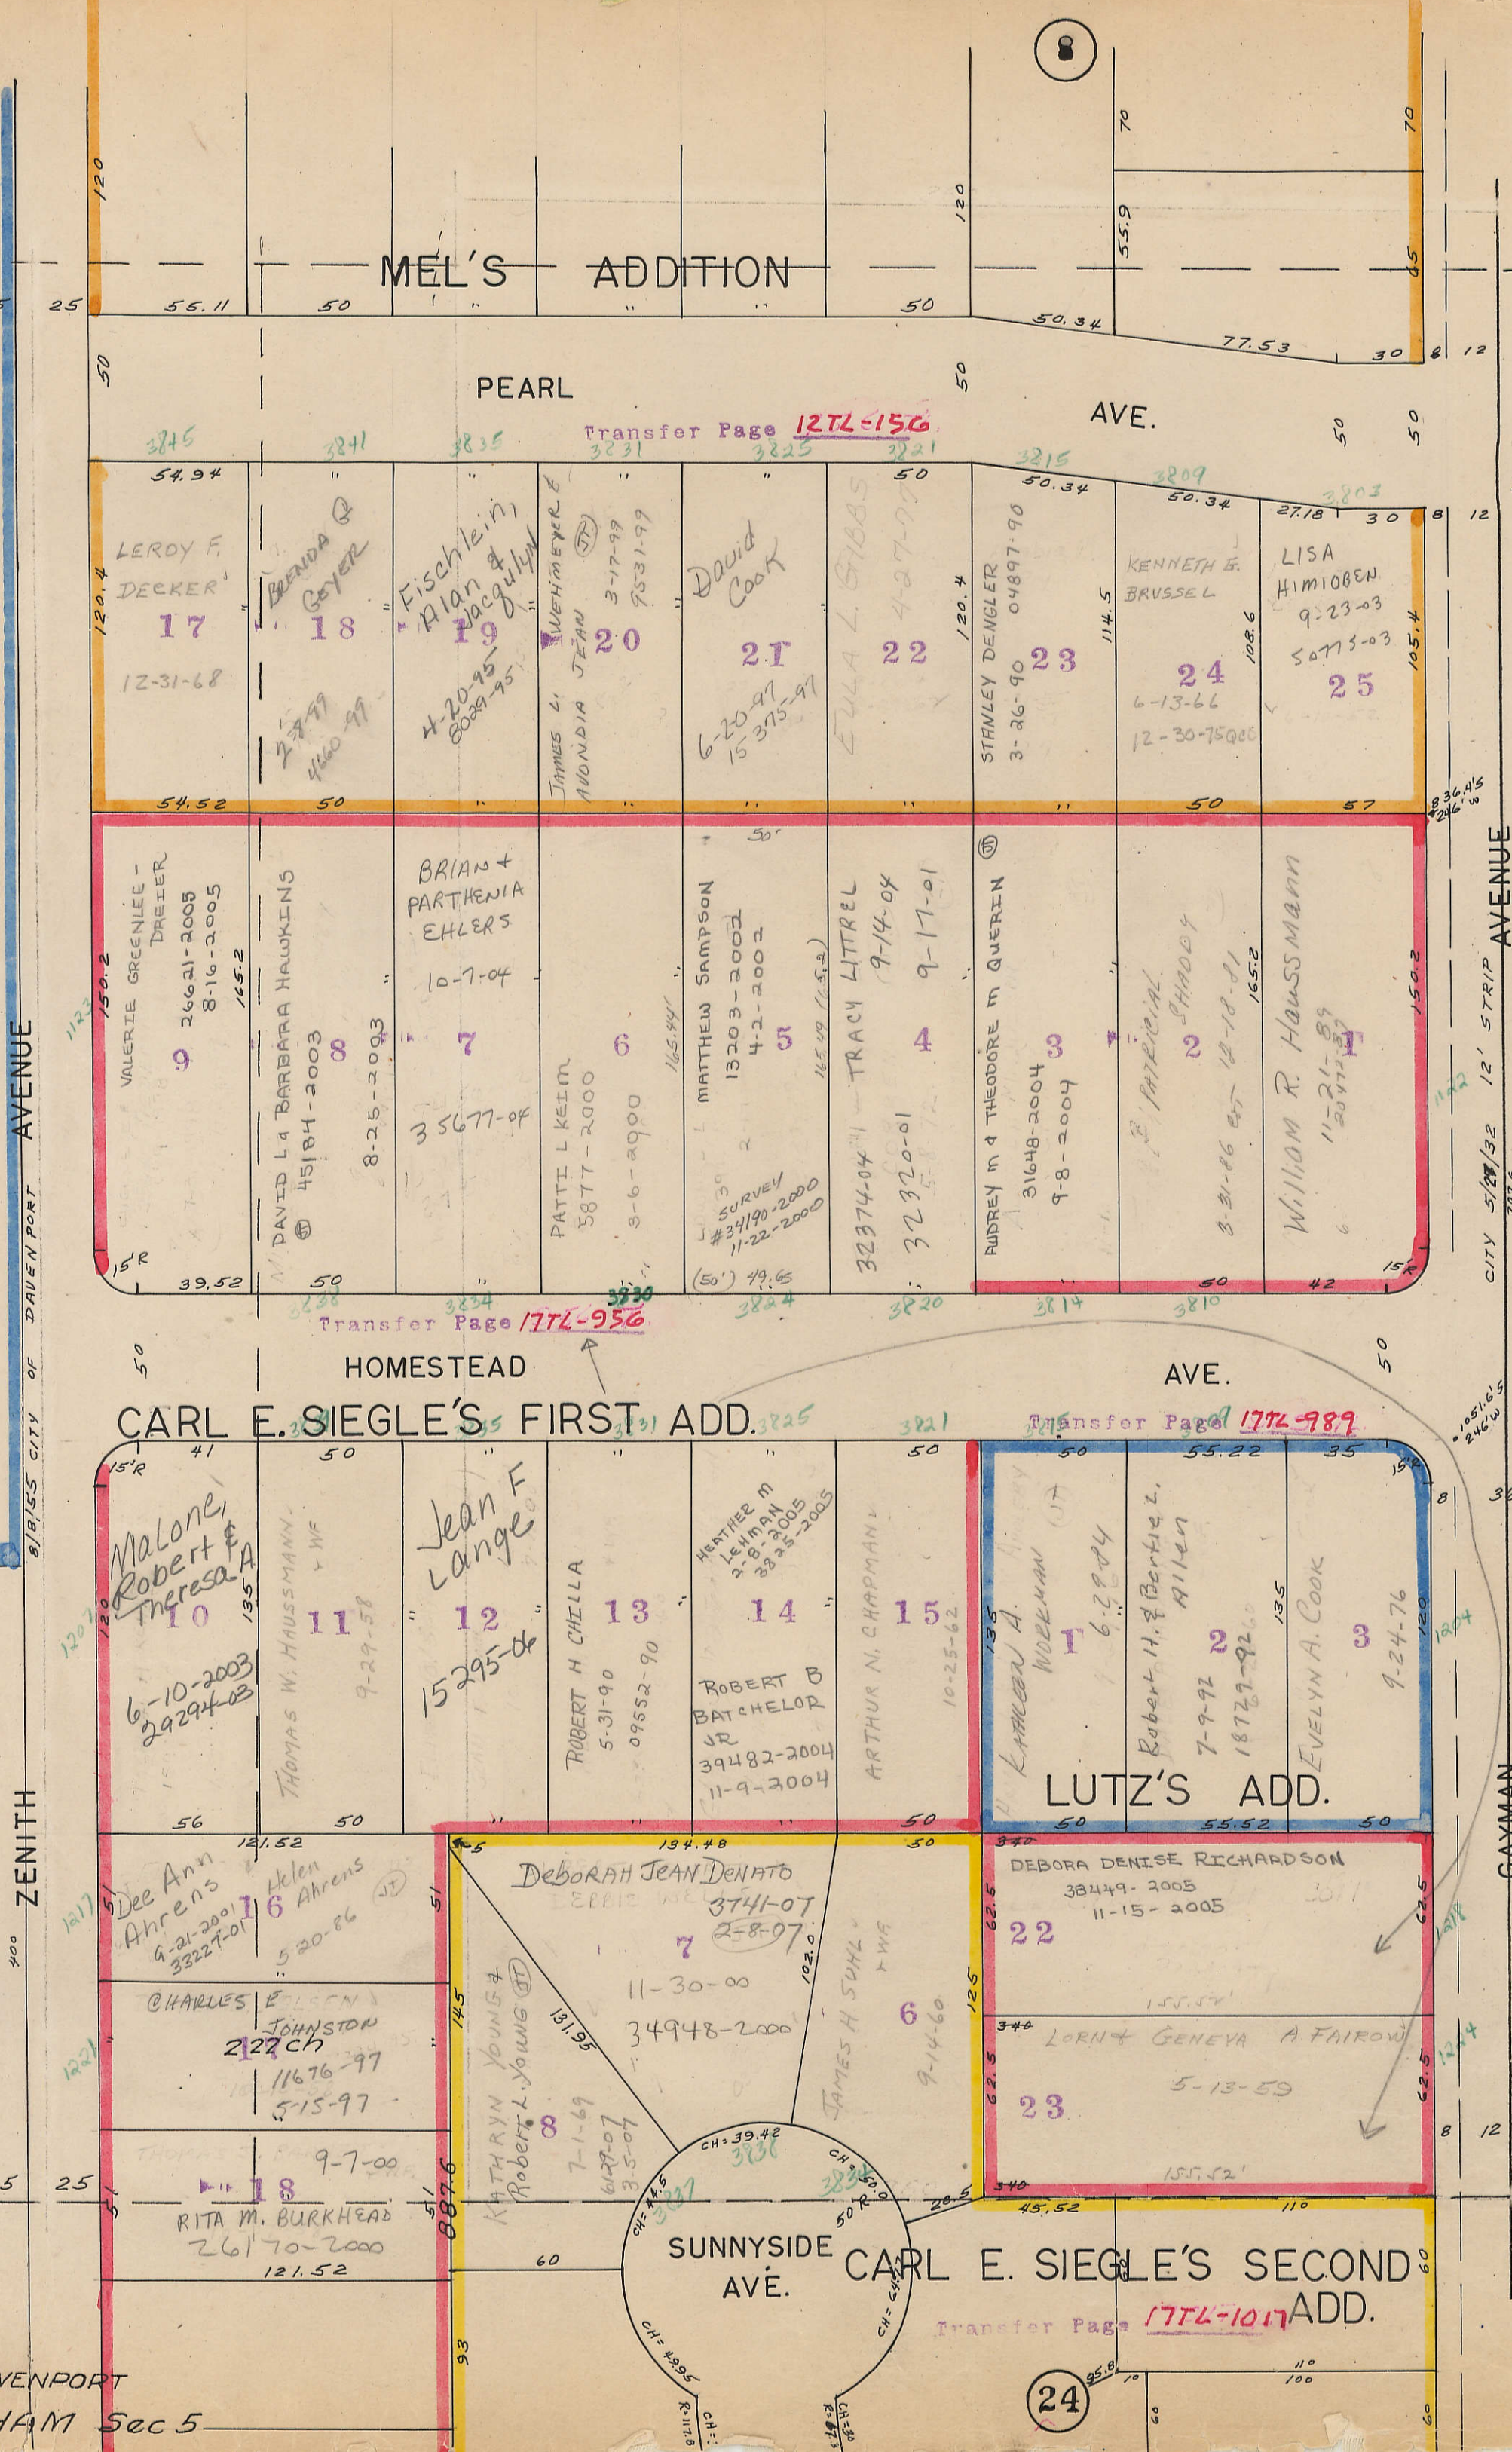

Replat by Auditor of Ericks Sub. of pt 5-77-3

16  
SEC 4