


TRANSFER PAGE 81ds-424

(40)

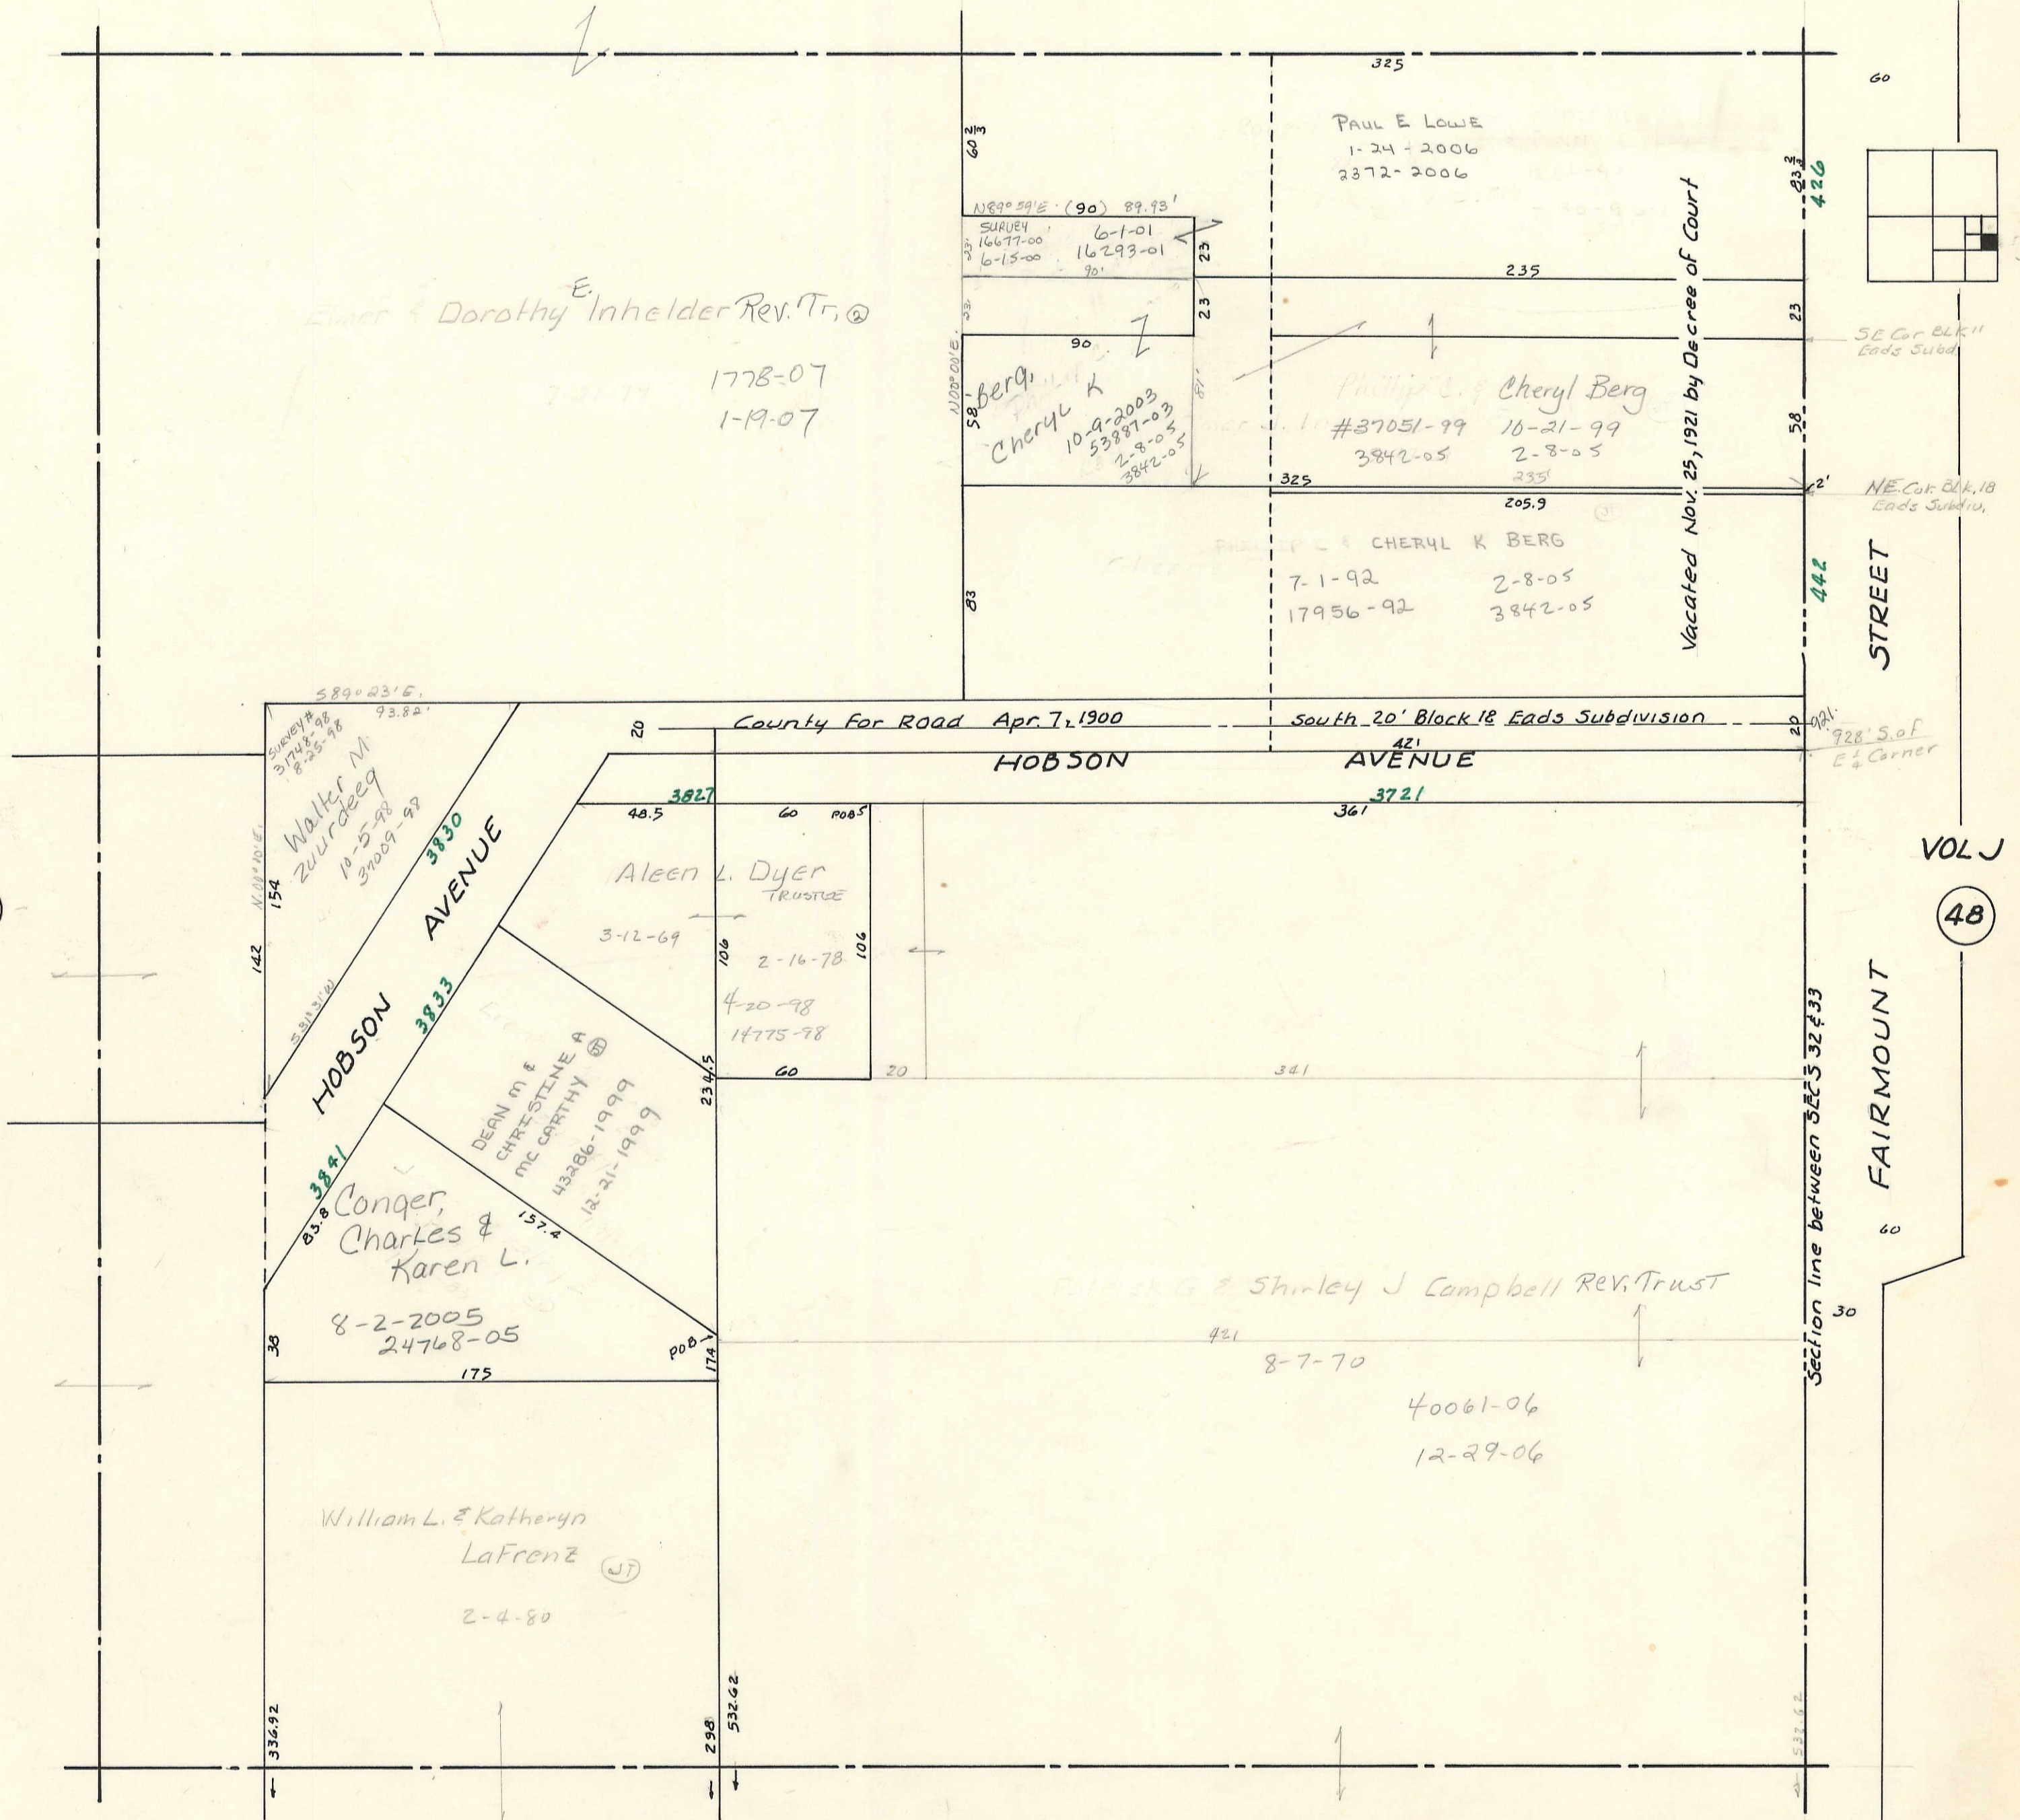

(42)

VOL J  
(48)

(56)