
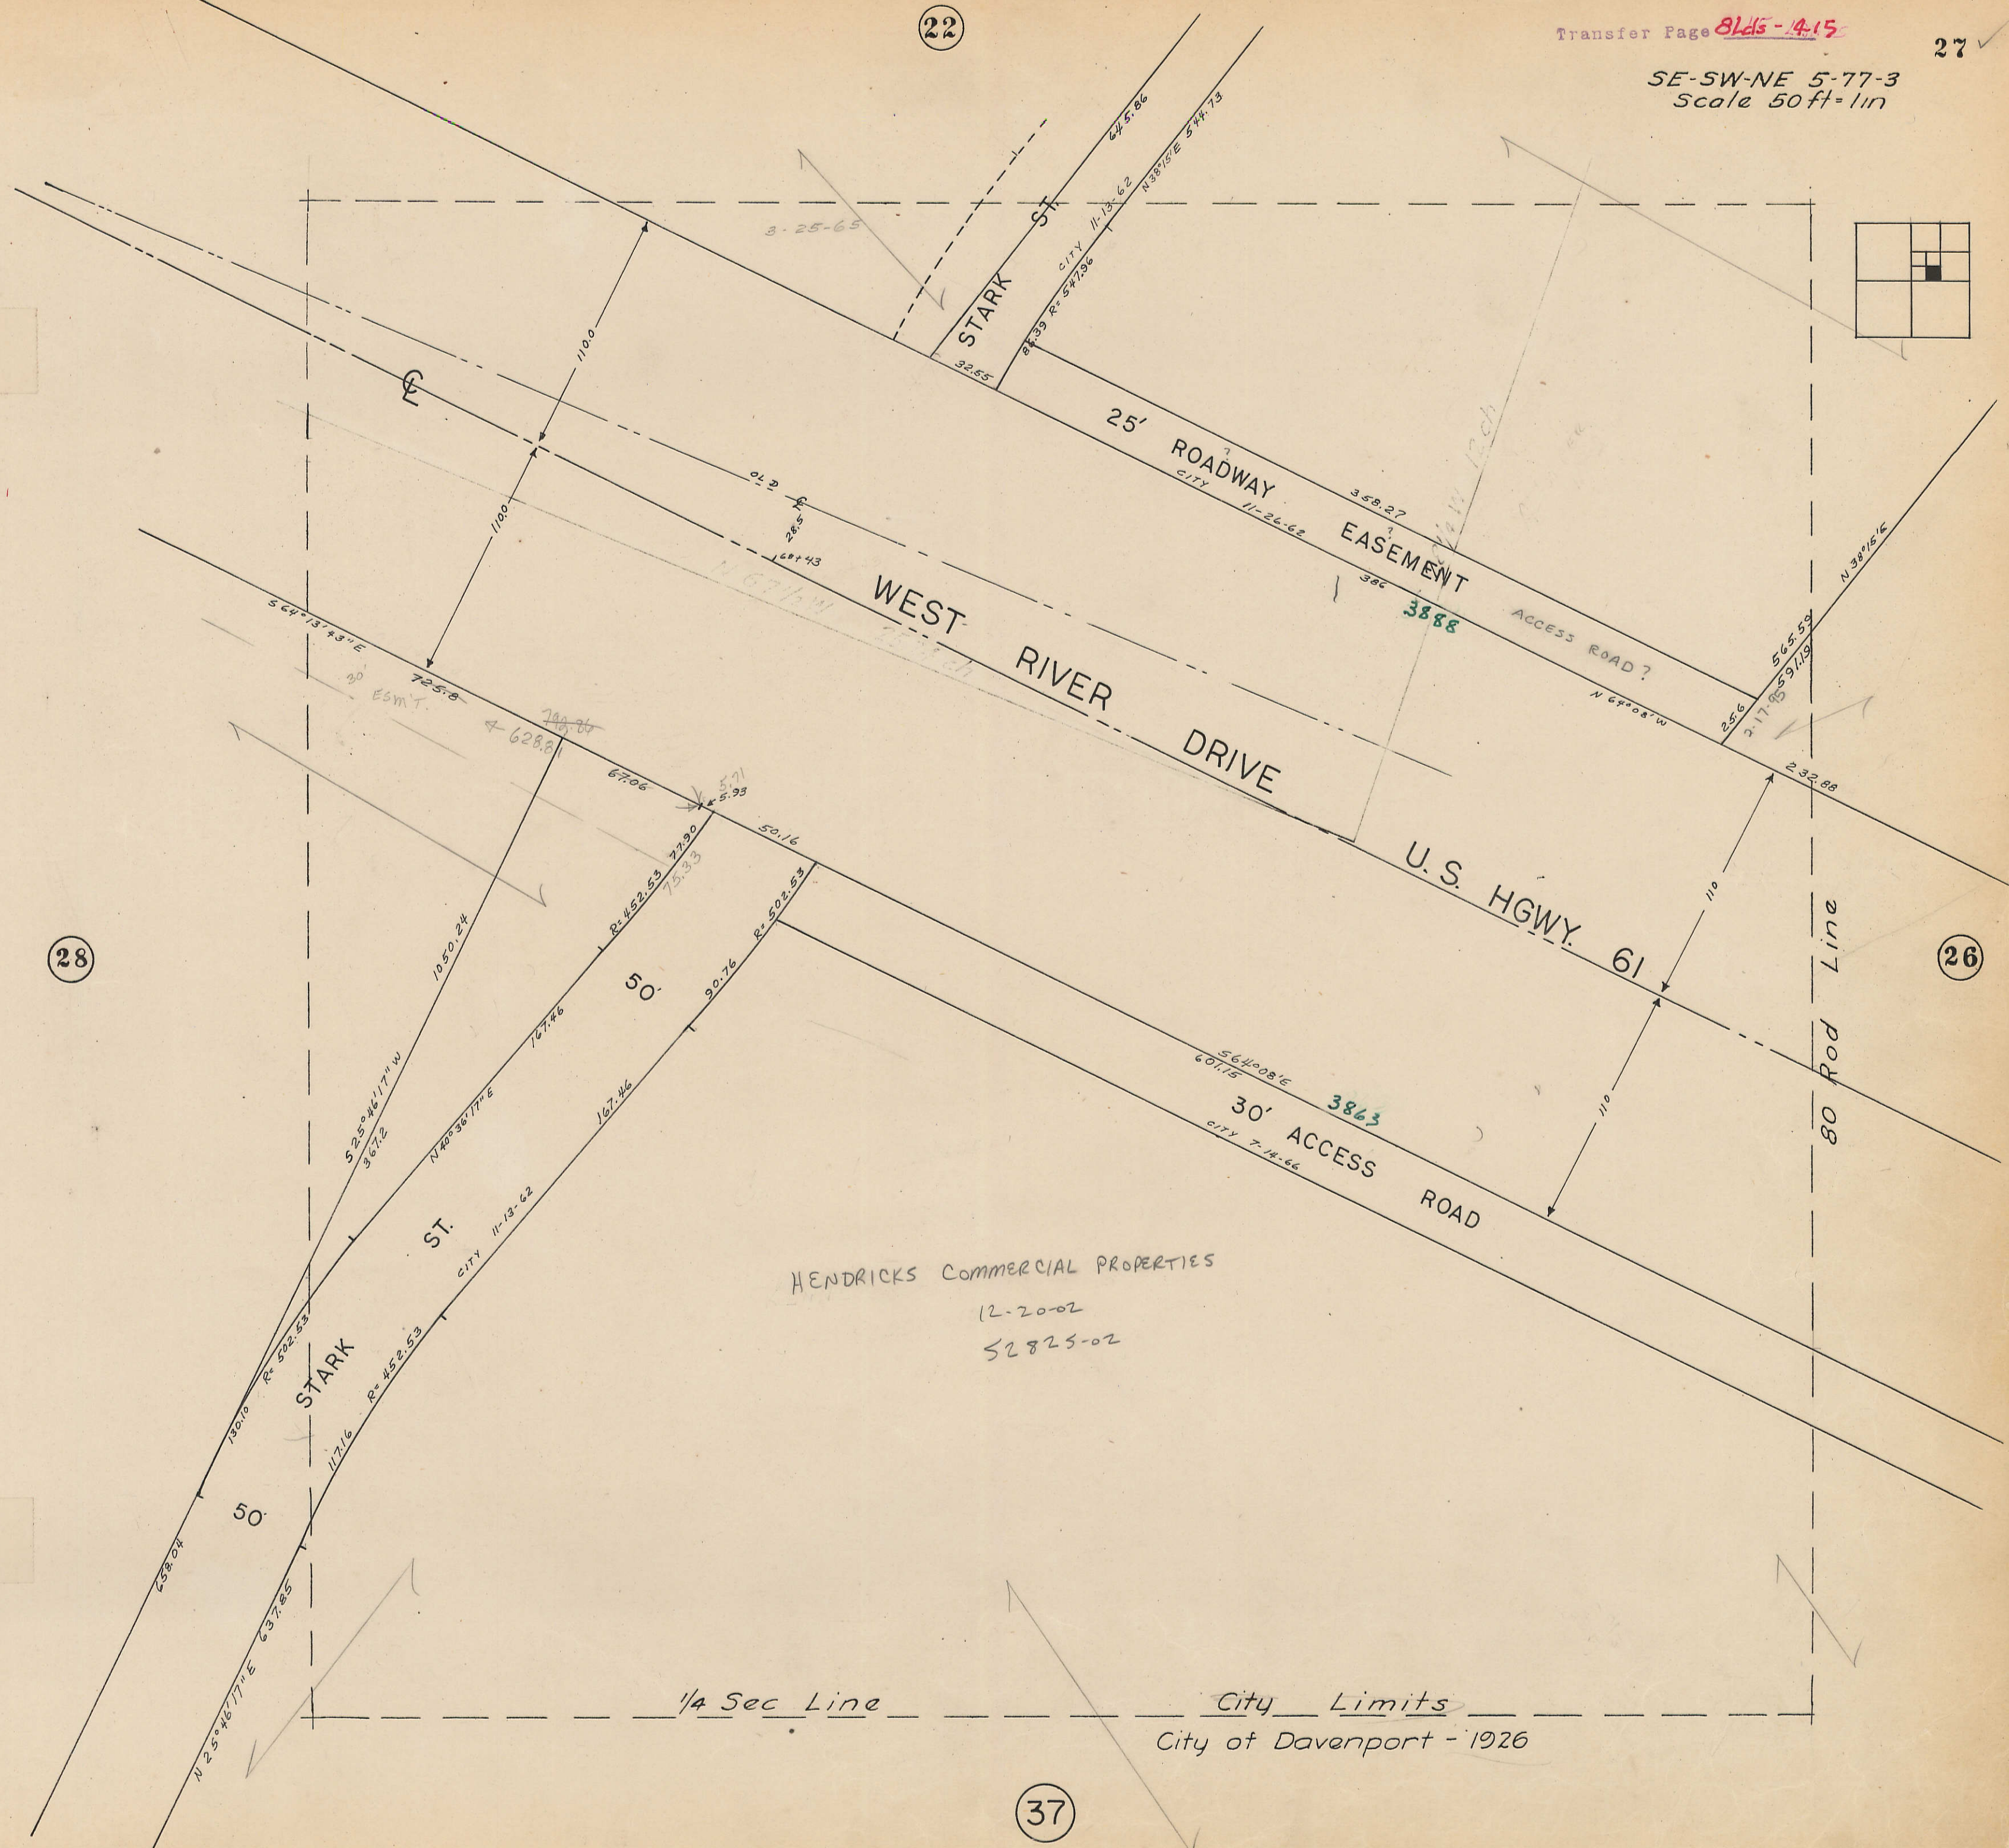


SE-SW-NE 5-77-3
Scale 50ft=1in

22

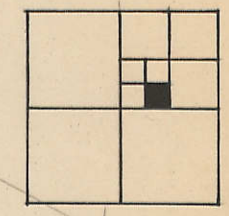

28

26

HENDRICKS COMMERCIAL PROPERTIES
12-20-02
52825-02

1/4 Sec Line

City Limits
City of Davenport - 1926

37