
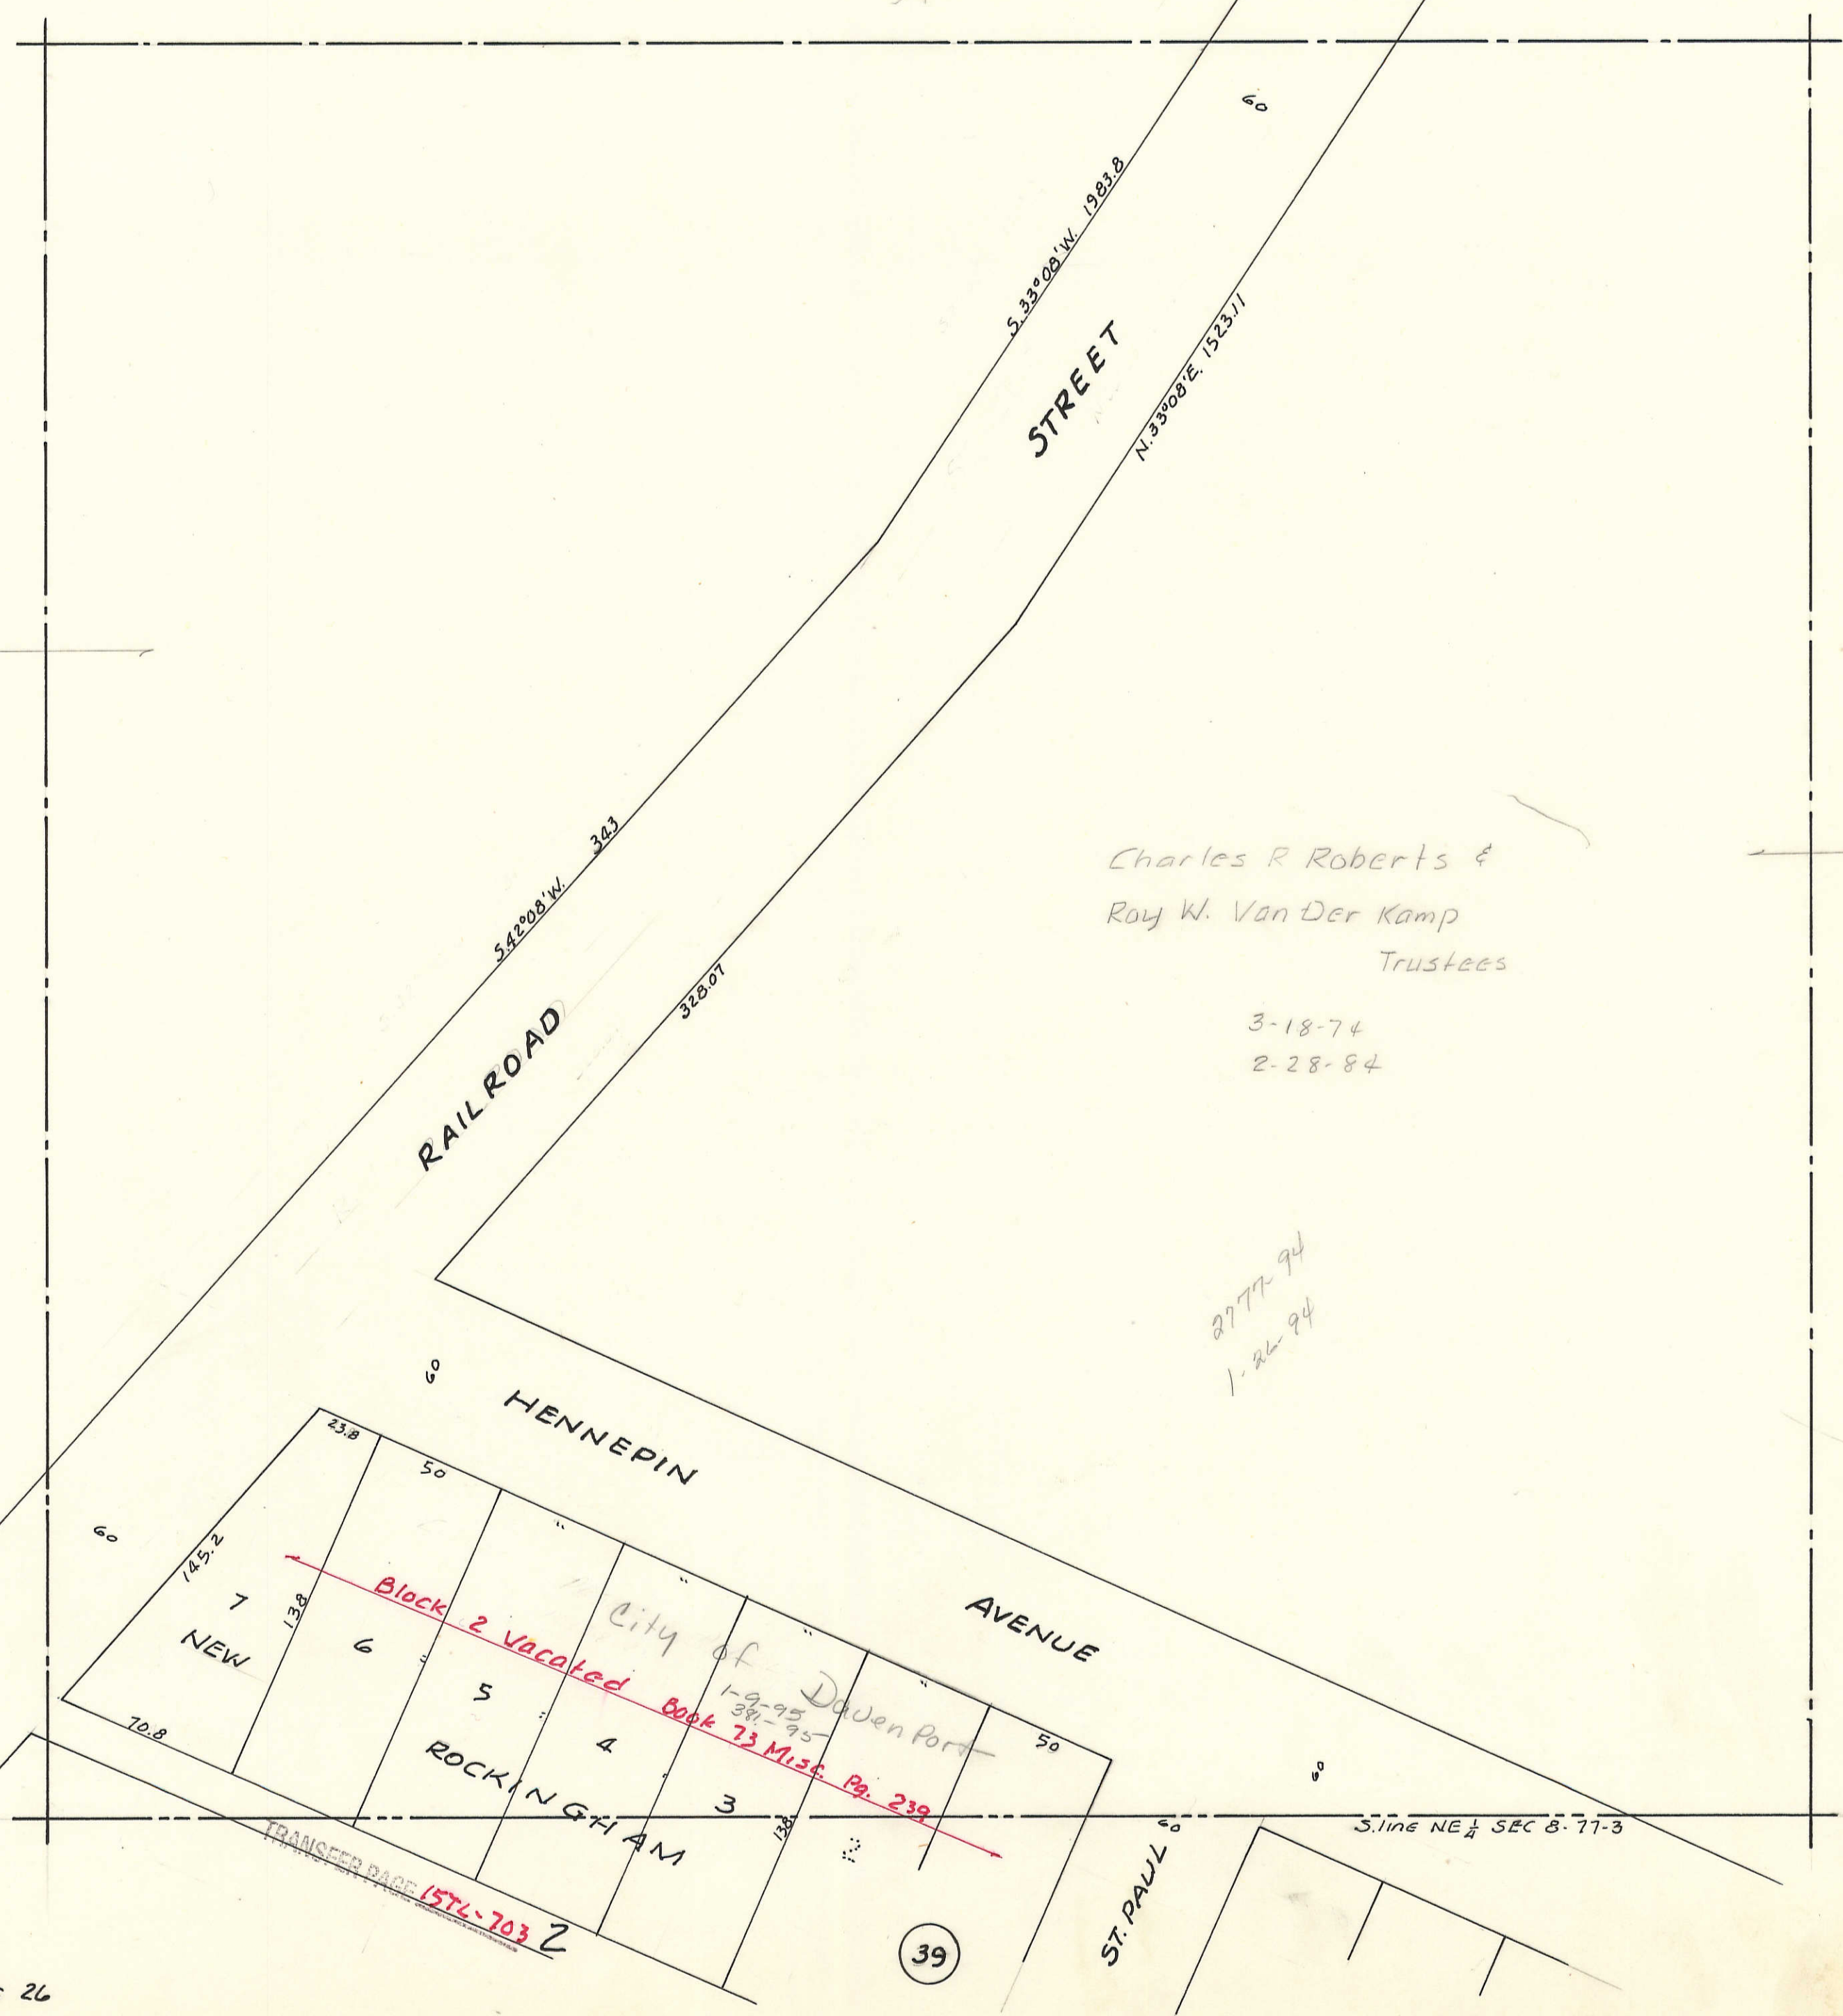


23

27

25

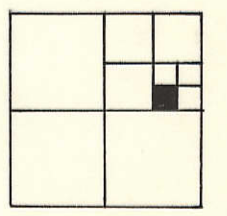

Charles R Roberts &
Roy W. Van Der Kamp
Trustees

3-18-74
2-28-84

2777-94
1-26-94

39