


Transfer Page 8lds-416

(37)

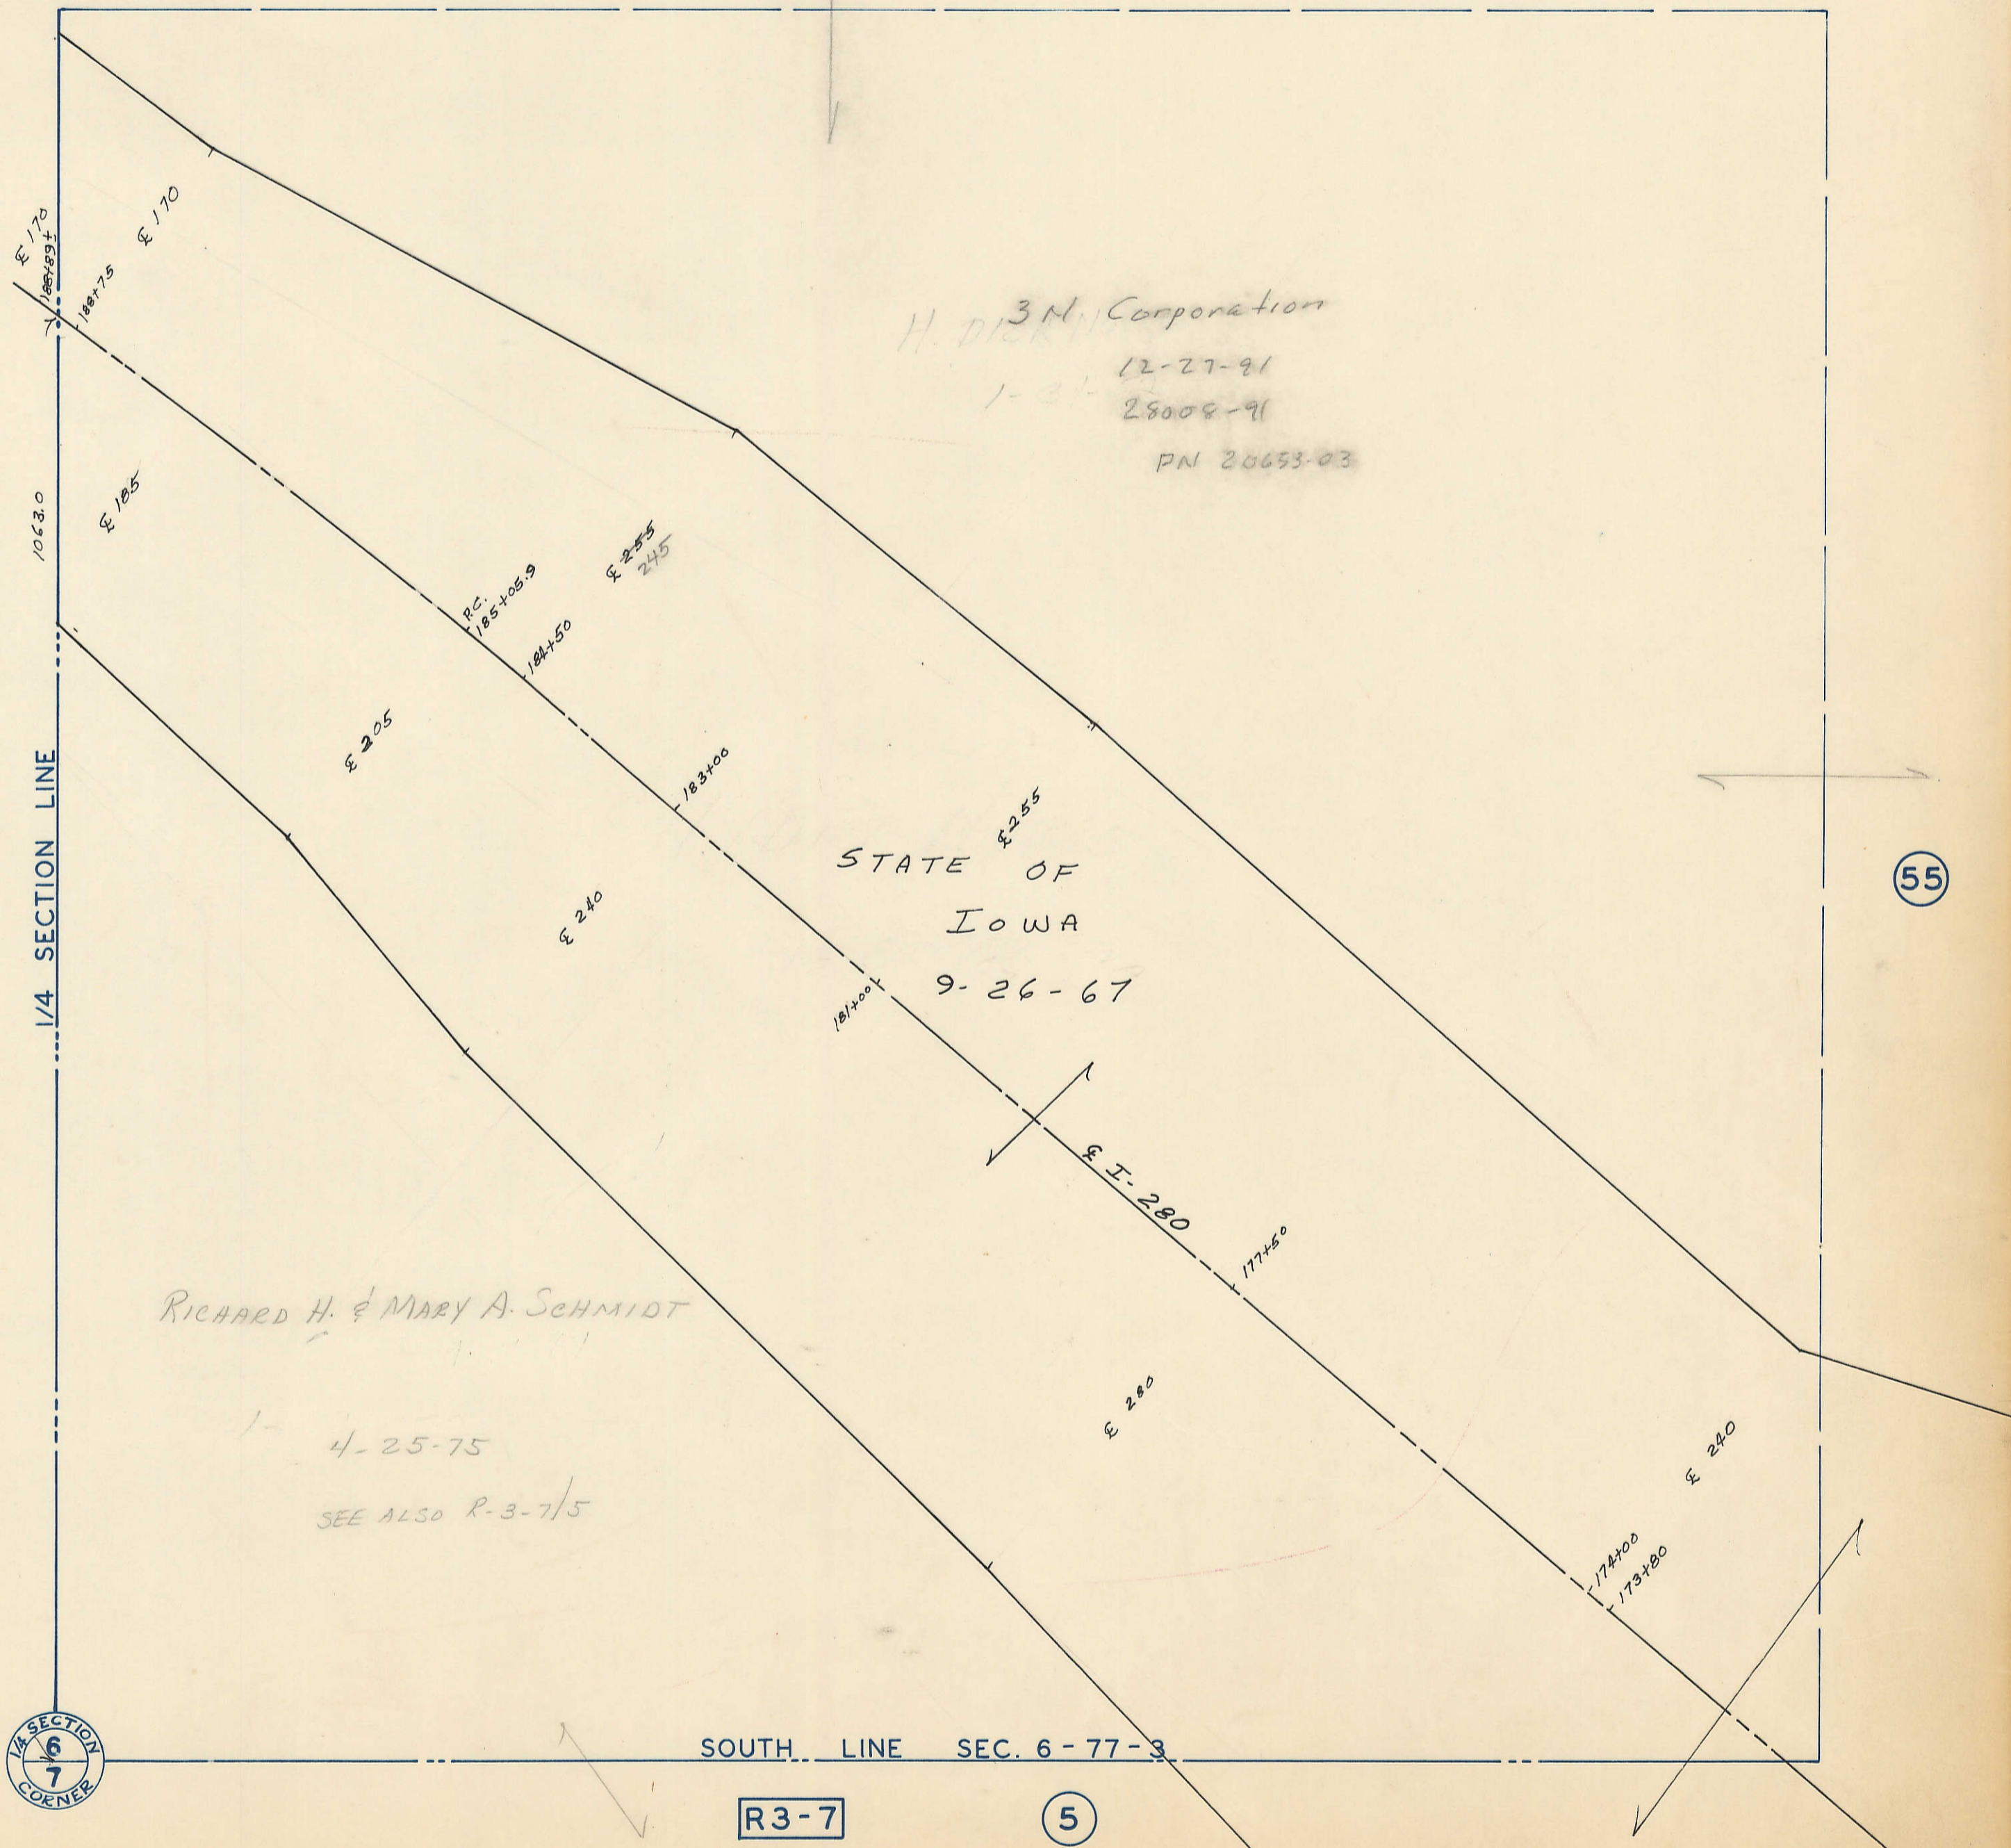

12-27-91  
1-31-28008-91  
PN 20653-03

STATE OF  
IOWA  
9-26-67

RICHARD H. & MARY A. SCHMIDT  
4-25-75  
SEE ALSO R-3-7/5

(51)

(55)



SOUTH LINE SEC. 6-77-3

R3-7

(5)