

R3-8

49

Transfer Page *Blds-420*

SECTION
7 8
18 17
CORNER


880' to E.R.R.

NORTH LINE SEC. 17-77-3

WEST LINE SEC. 17-77-3
1003' to E.R.R.


R3-18

7

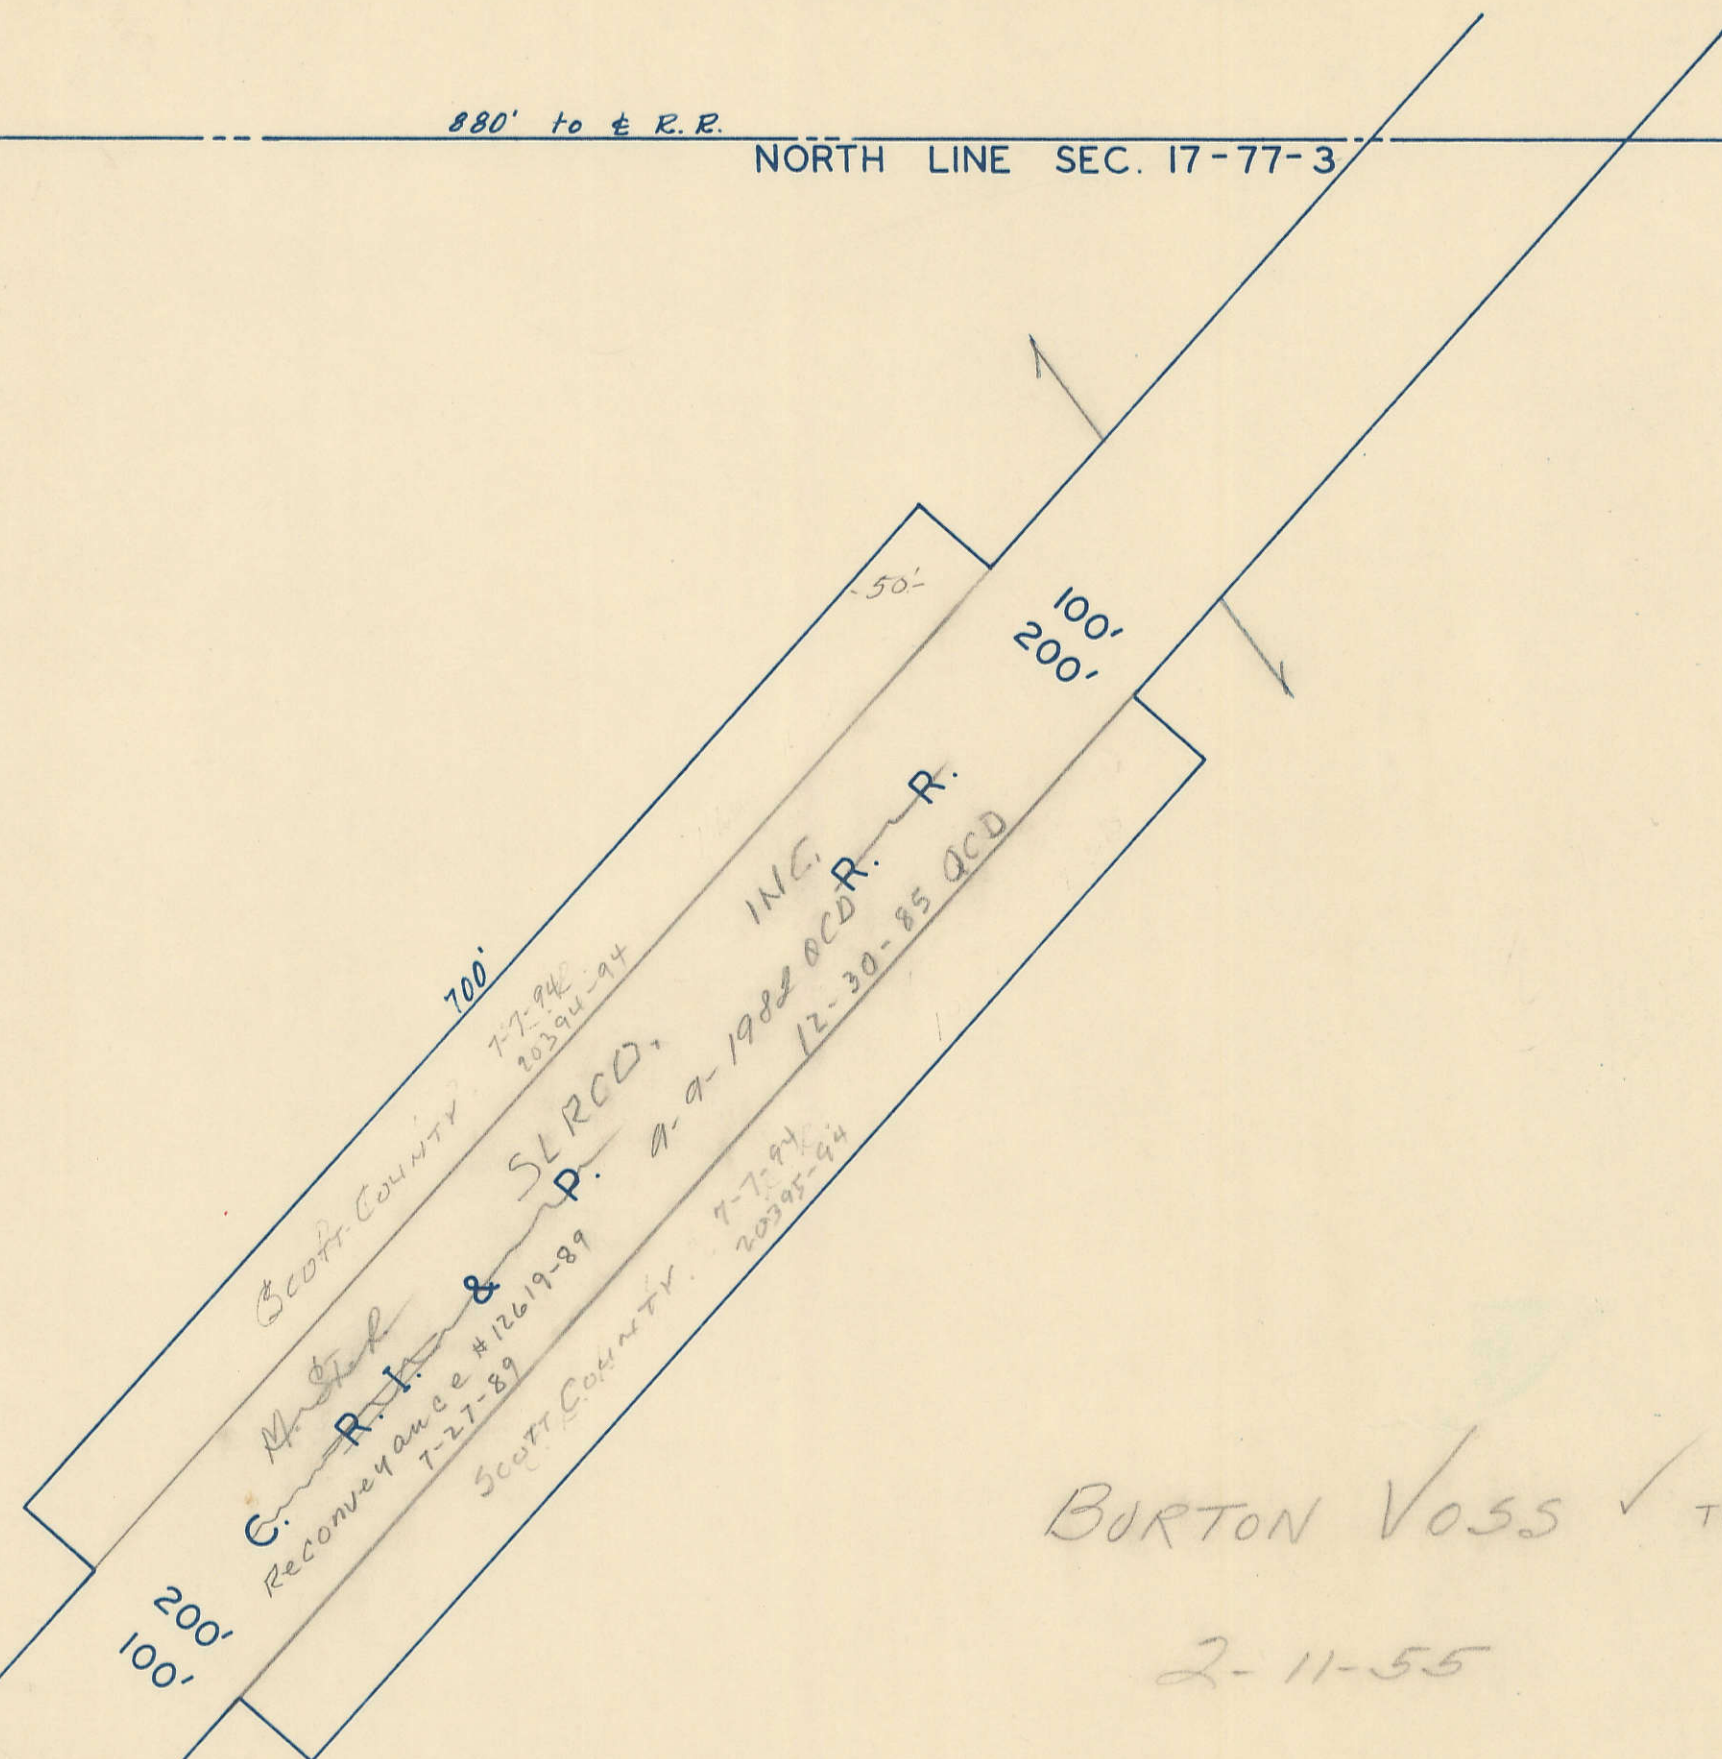

BURTON VOSS ✓ TRUSTEE
7-26-91
15784-91
2-11-55

1601.5' to Road

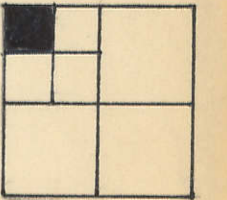

3

17