


35

Transfer Page **8lds-417**

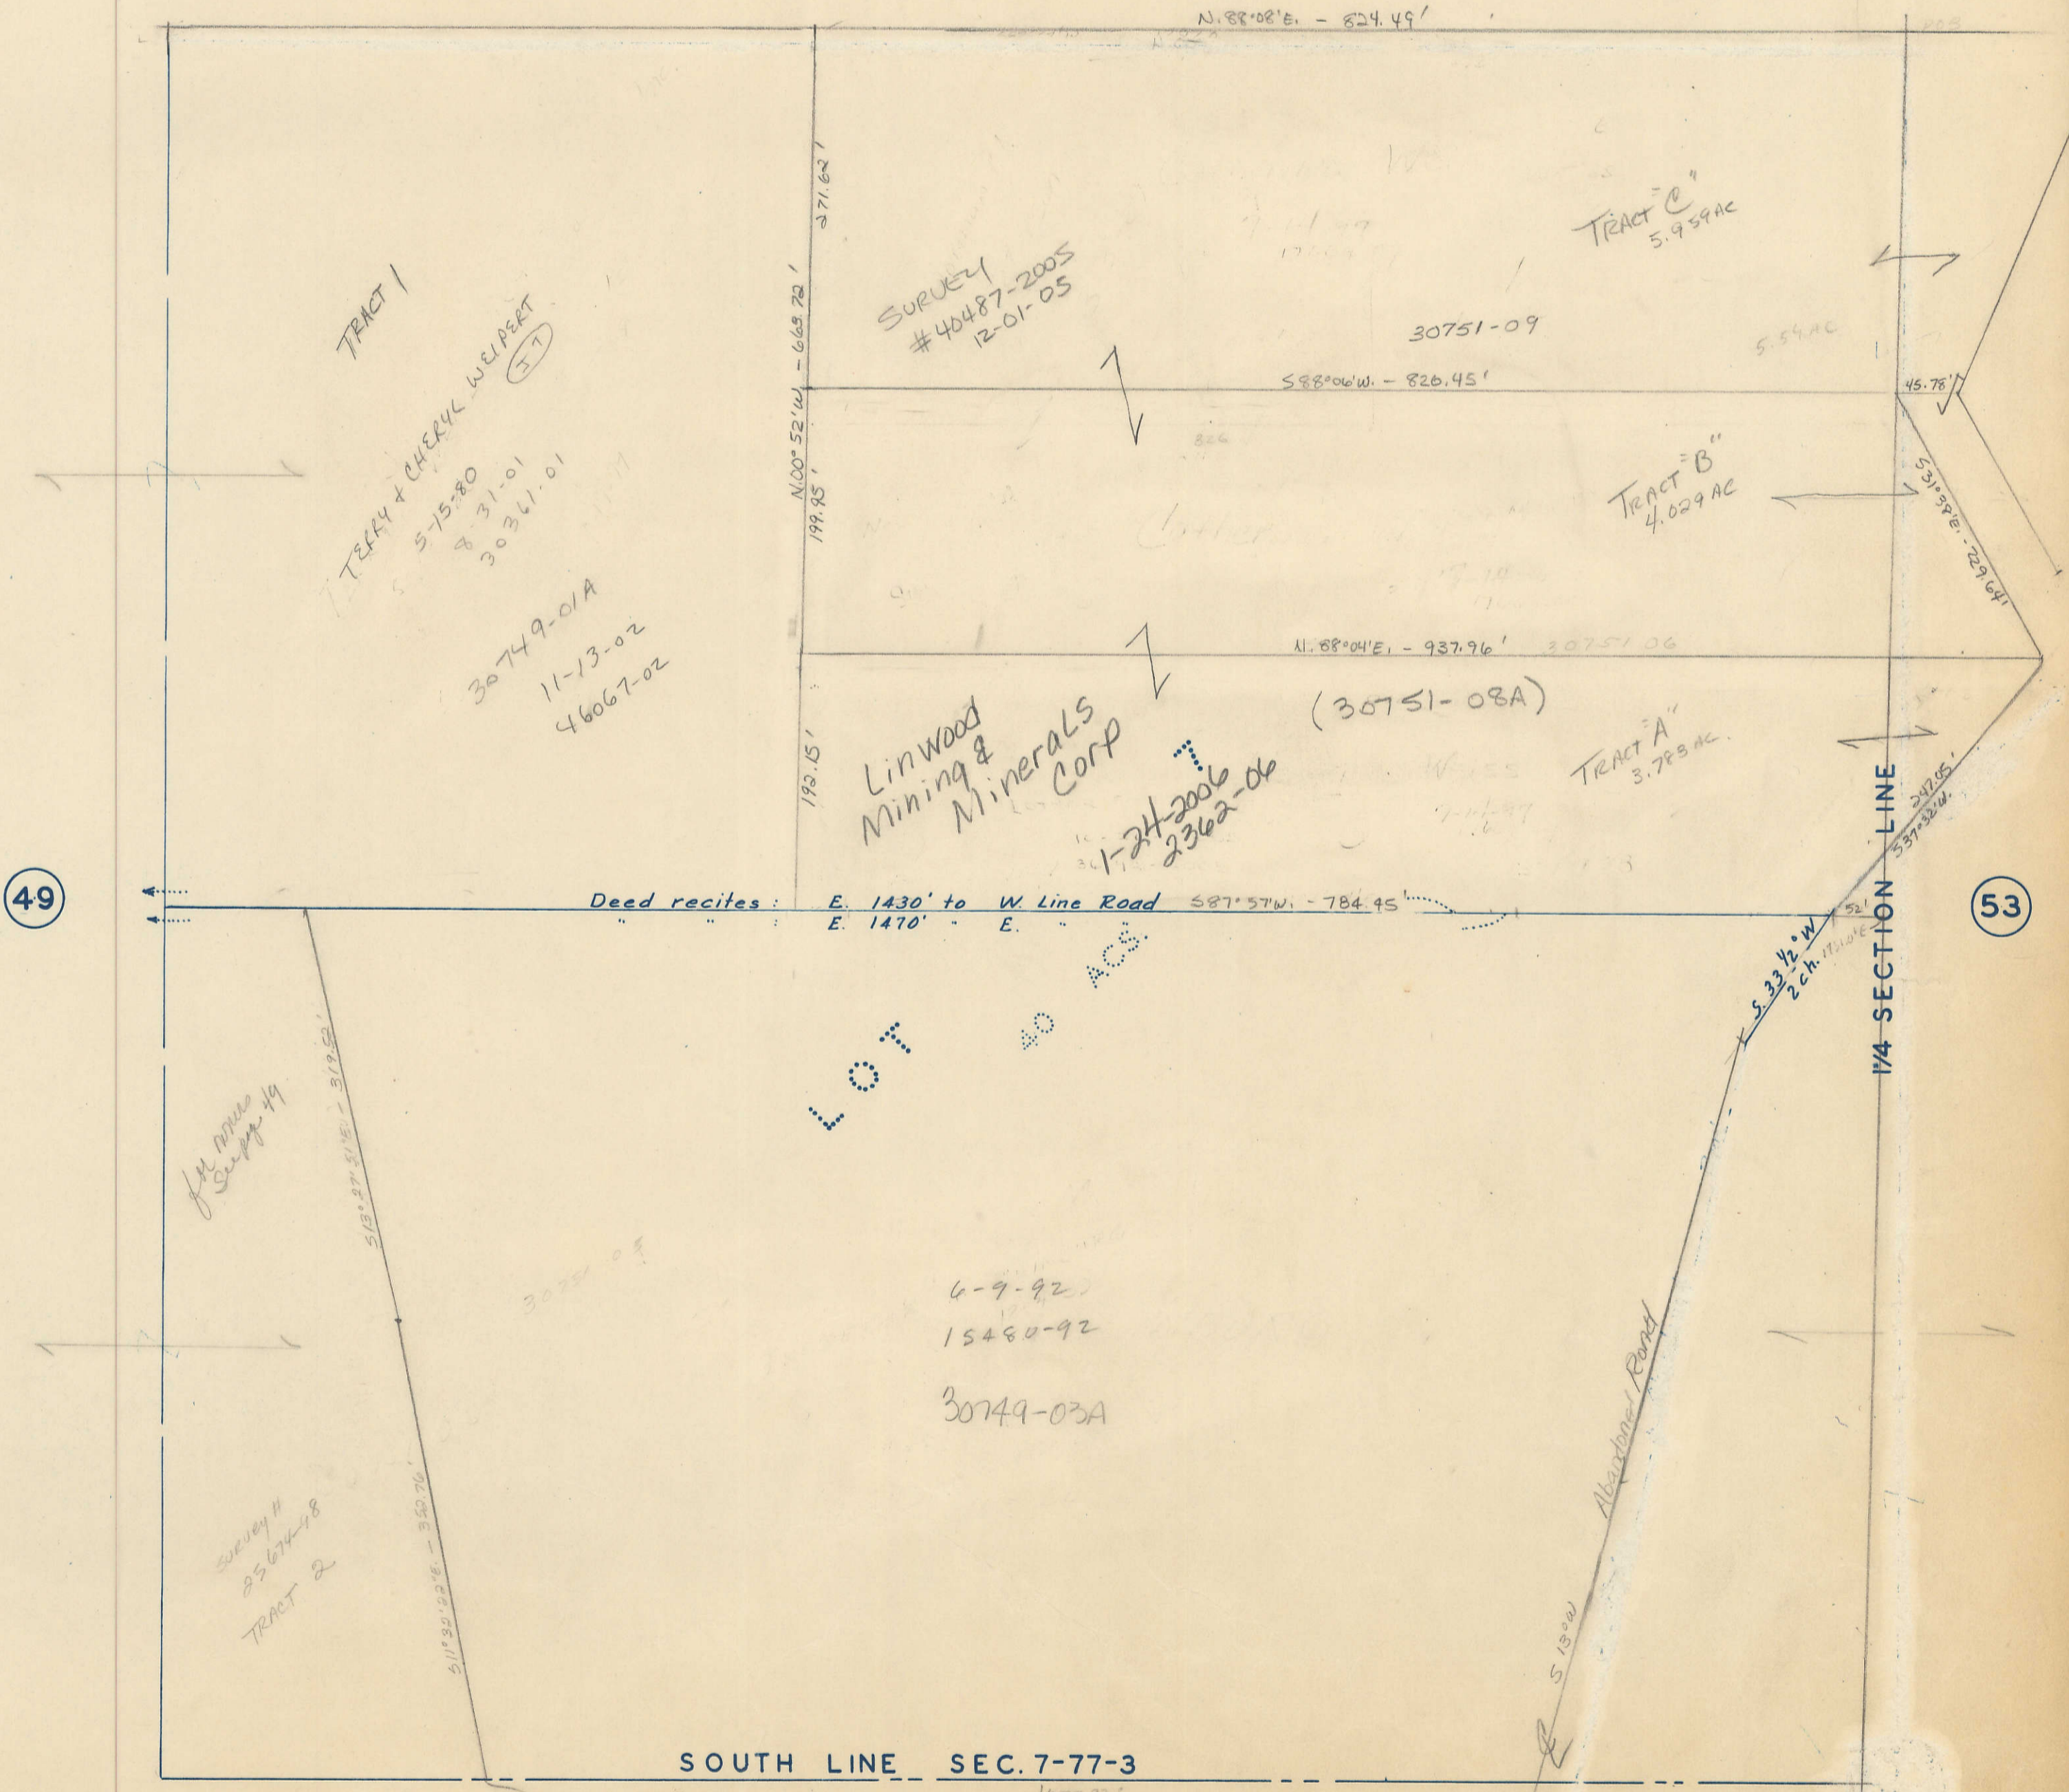

49

53

R3-18

3