S.W.1/4, S.E.1/4
SEC. 18-77-3
SCALE: 1 in. = 100 ft.



(37)
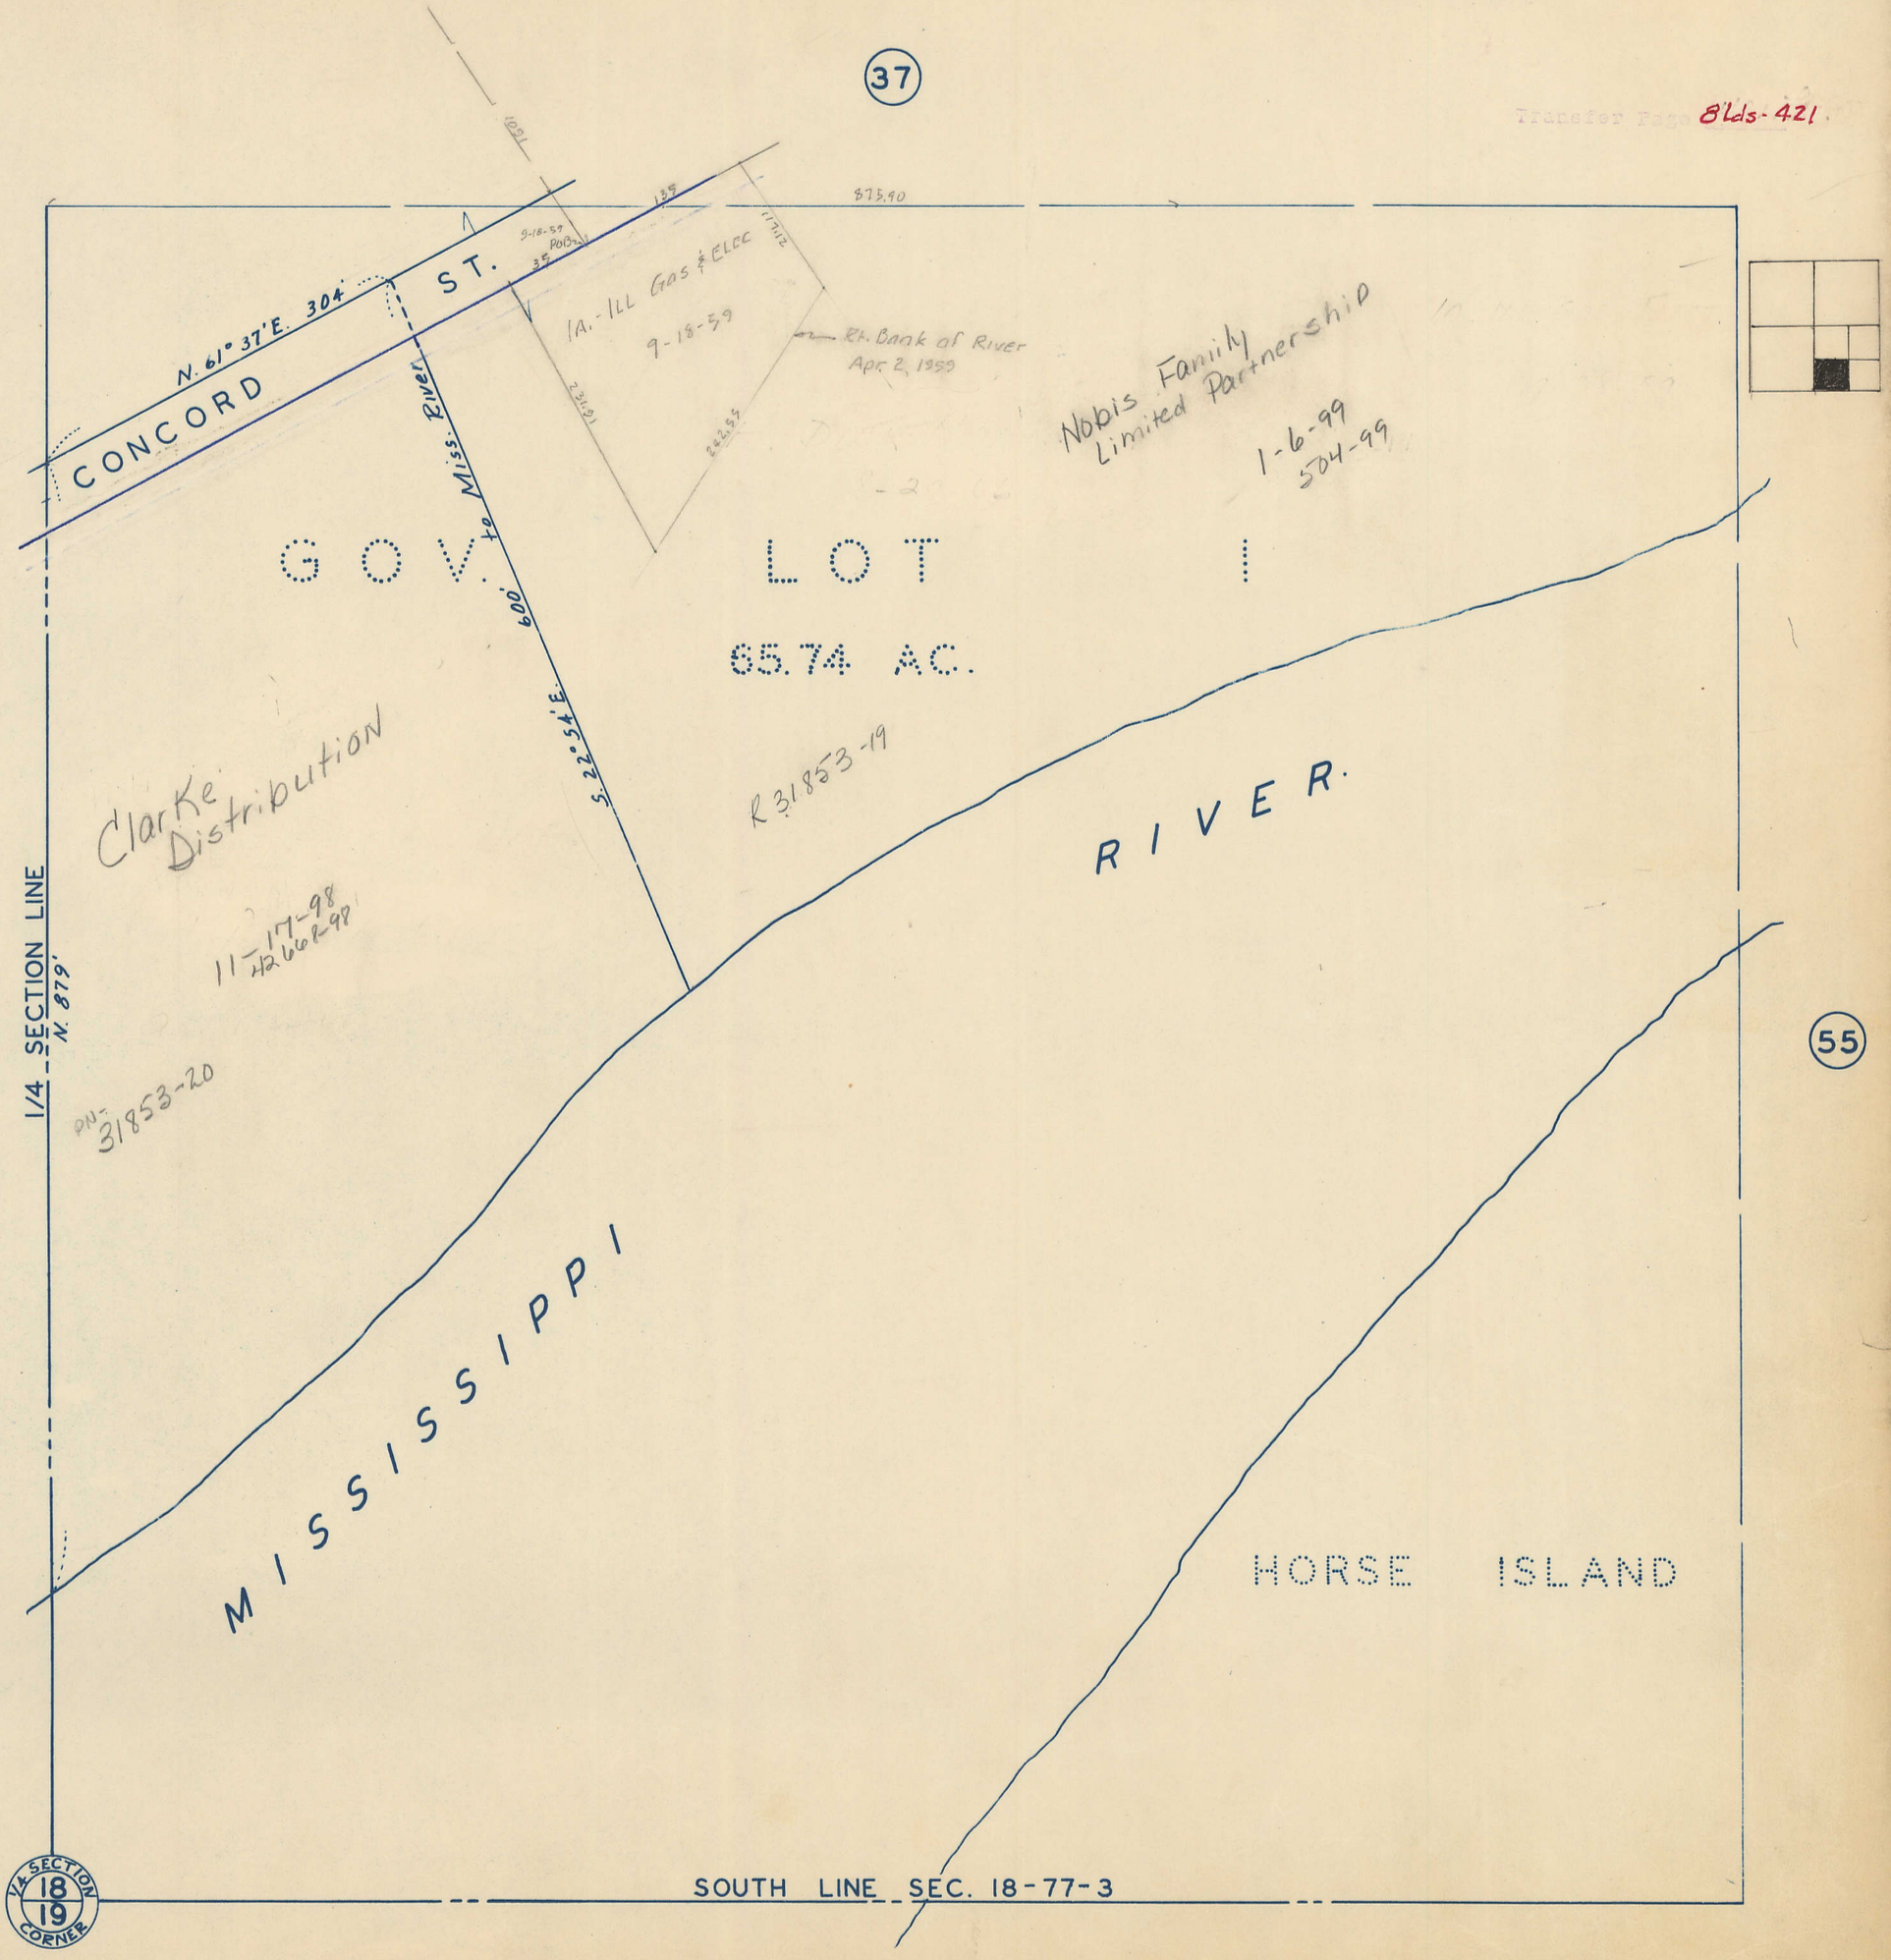
Transfer Page Blds-421.