


(37)

Transfer Page 8lds-4-17

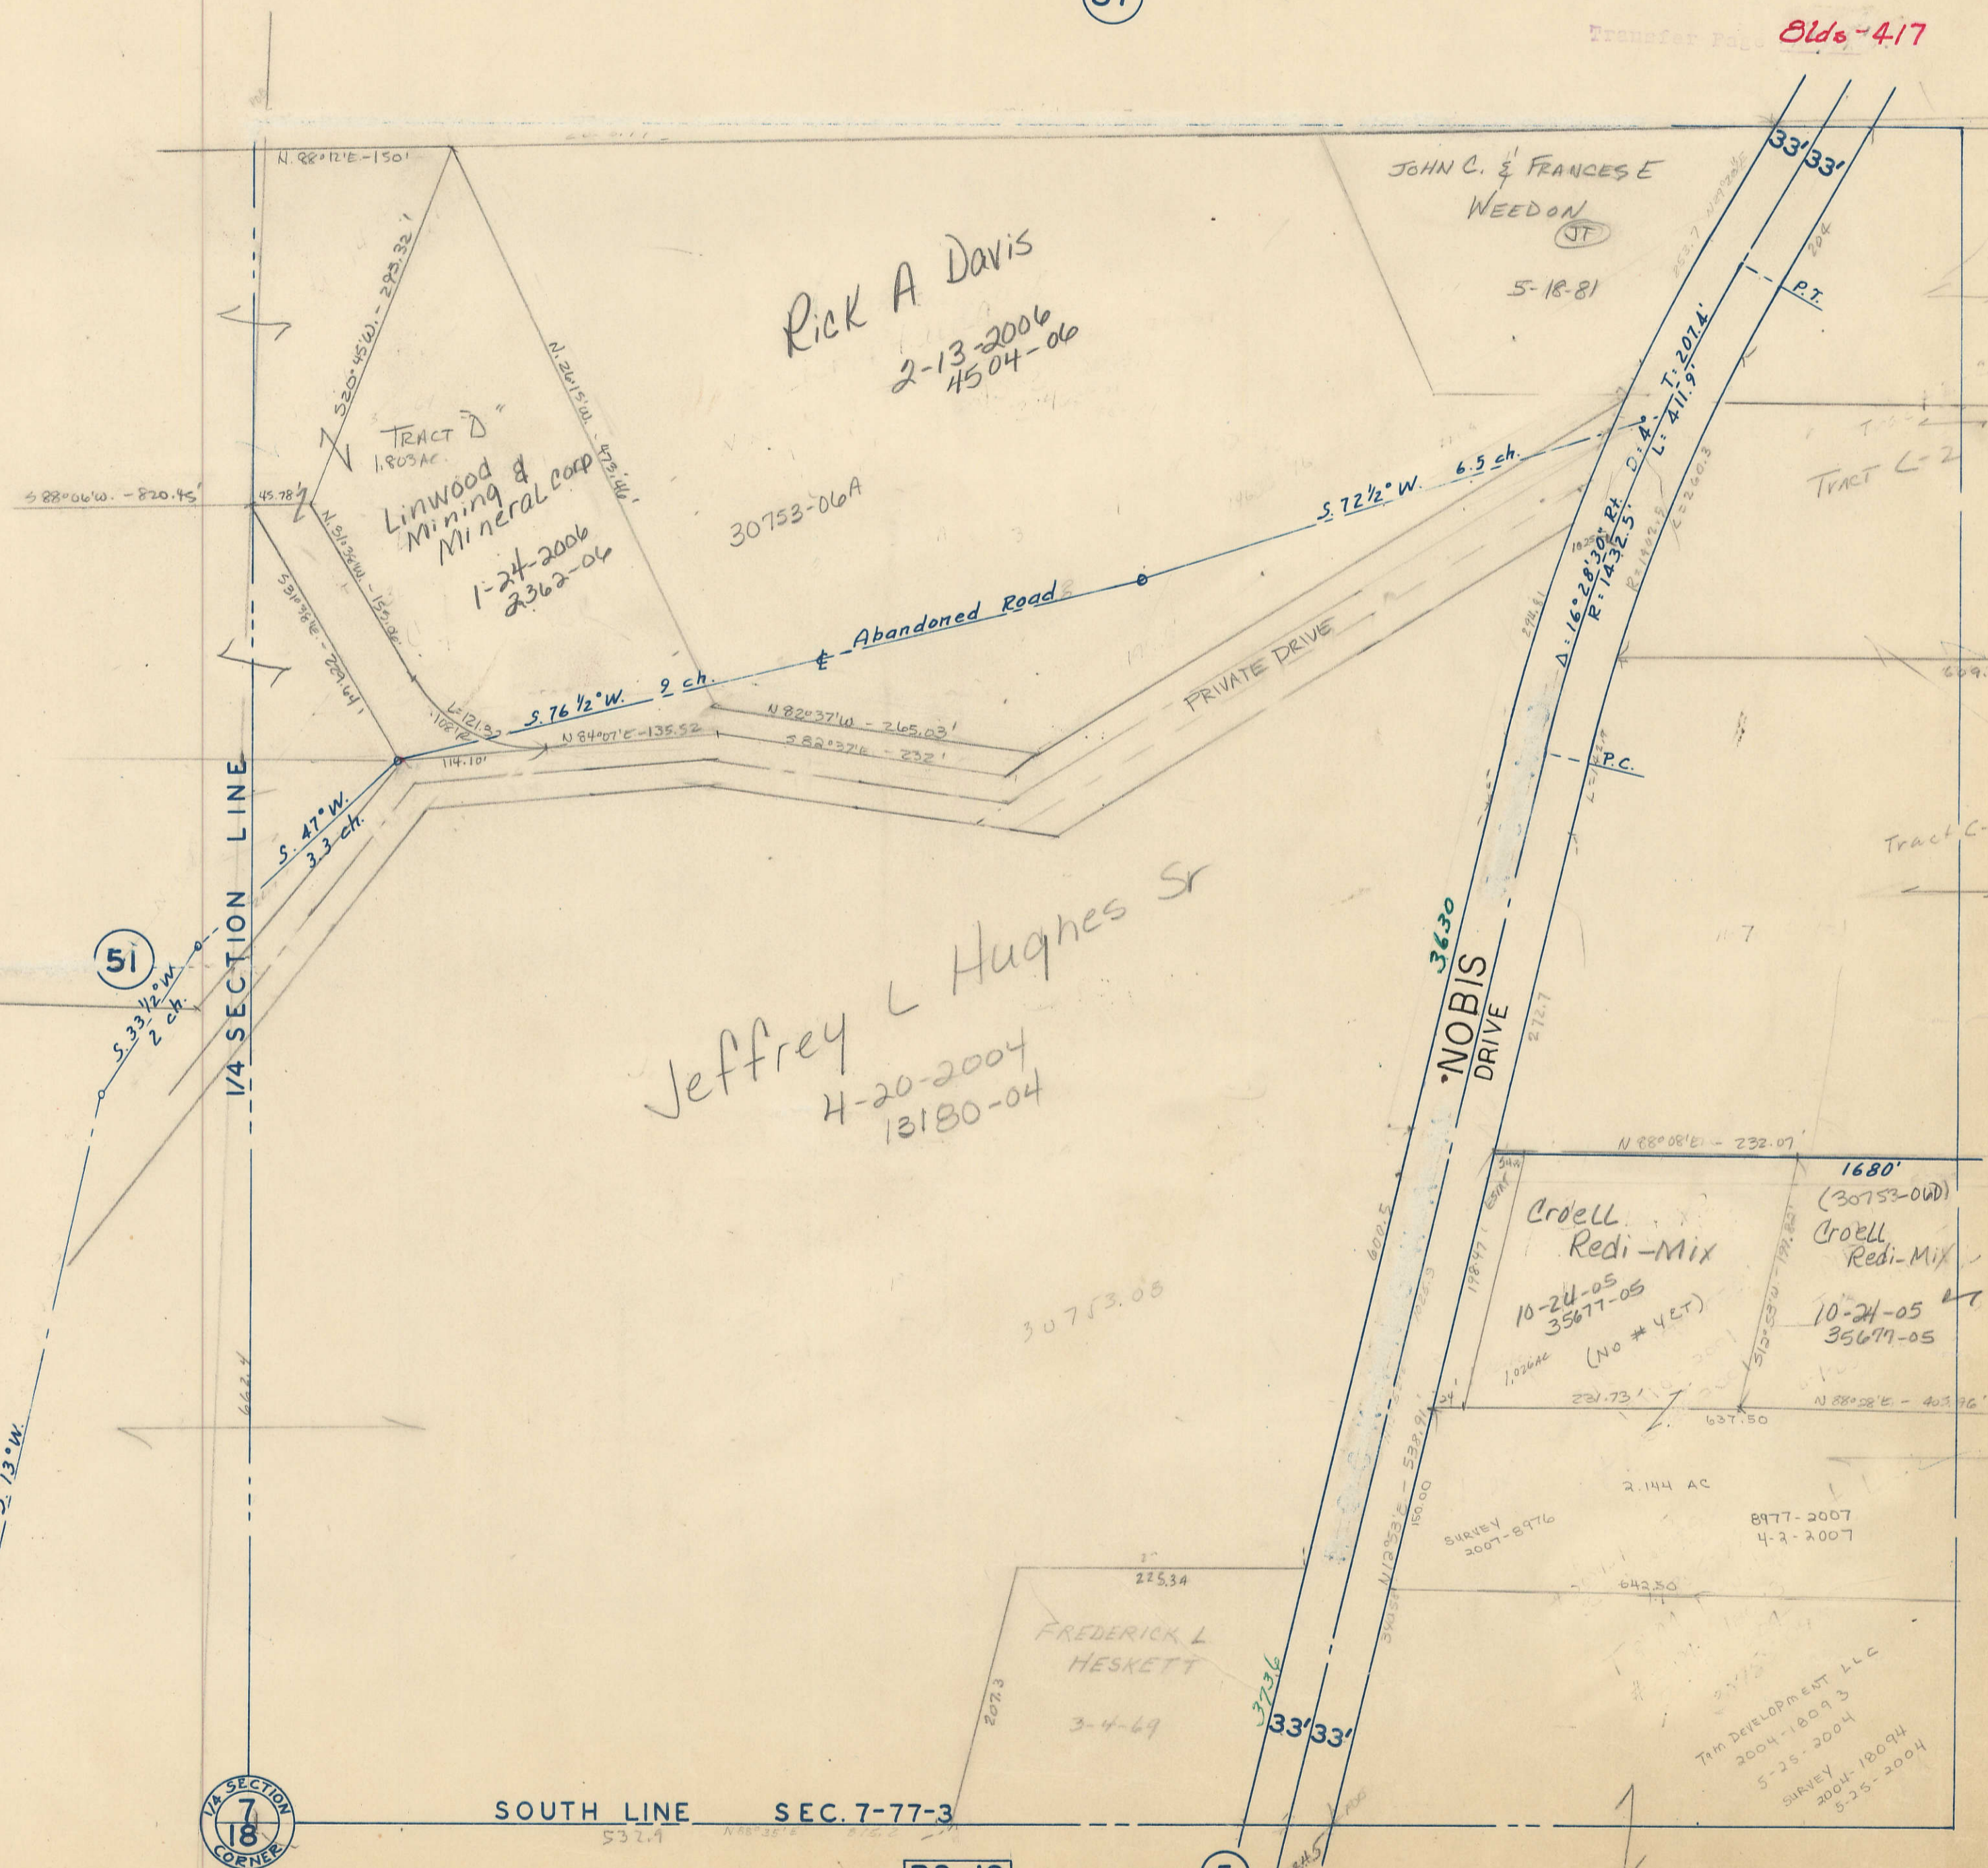

(51)

(55)

1/4 SECTION CORNER
7
18

SOUTH LINE SEC. 7-77-3

R3-18

(5)

TRIN DEVELOPMENT LLC
2004-18093
5-25-2004
SURVEY
2004-18094
5-25-2004