


TRANSFER PAGE Slds - 67

SEC. 25

53

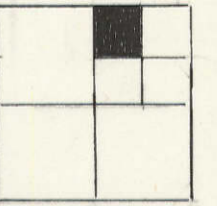


WEST LAKE PARK
Scott Co. Conservation Board

BLUE GRASS TWP

(SEE BLUE GRASS TWP.)

9-3-70

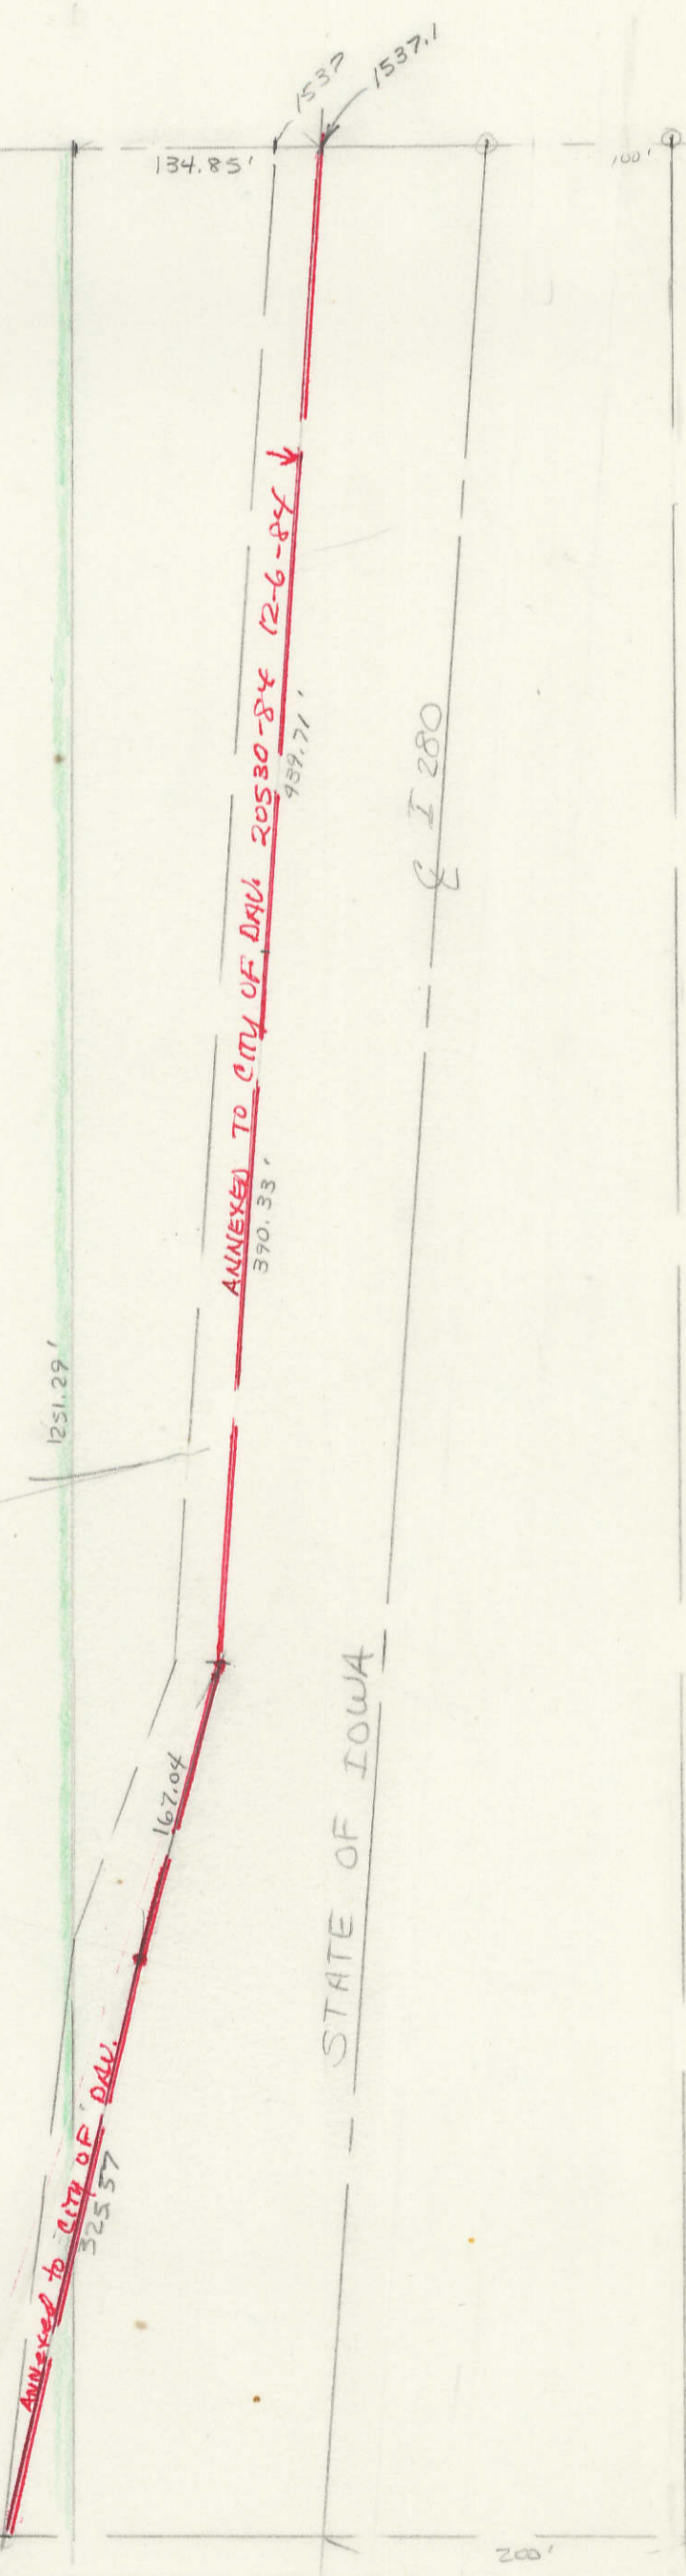

36-7

21