



S.W. 1/4, S.W. 1/4
SEC. 19-78-3
SCALE: 1 in. = 100 ft.

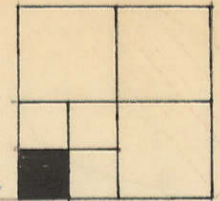

49

33

Transfer Page 645-188

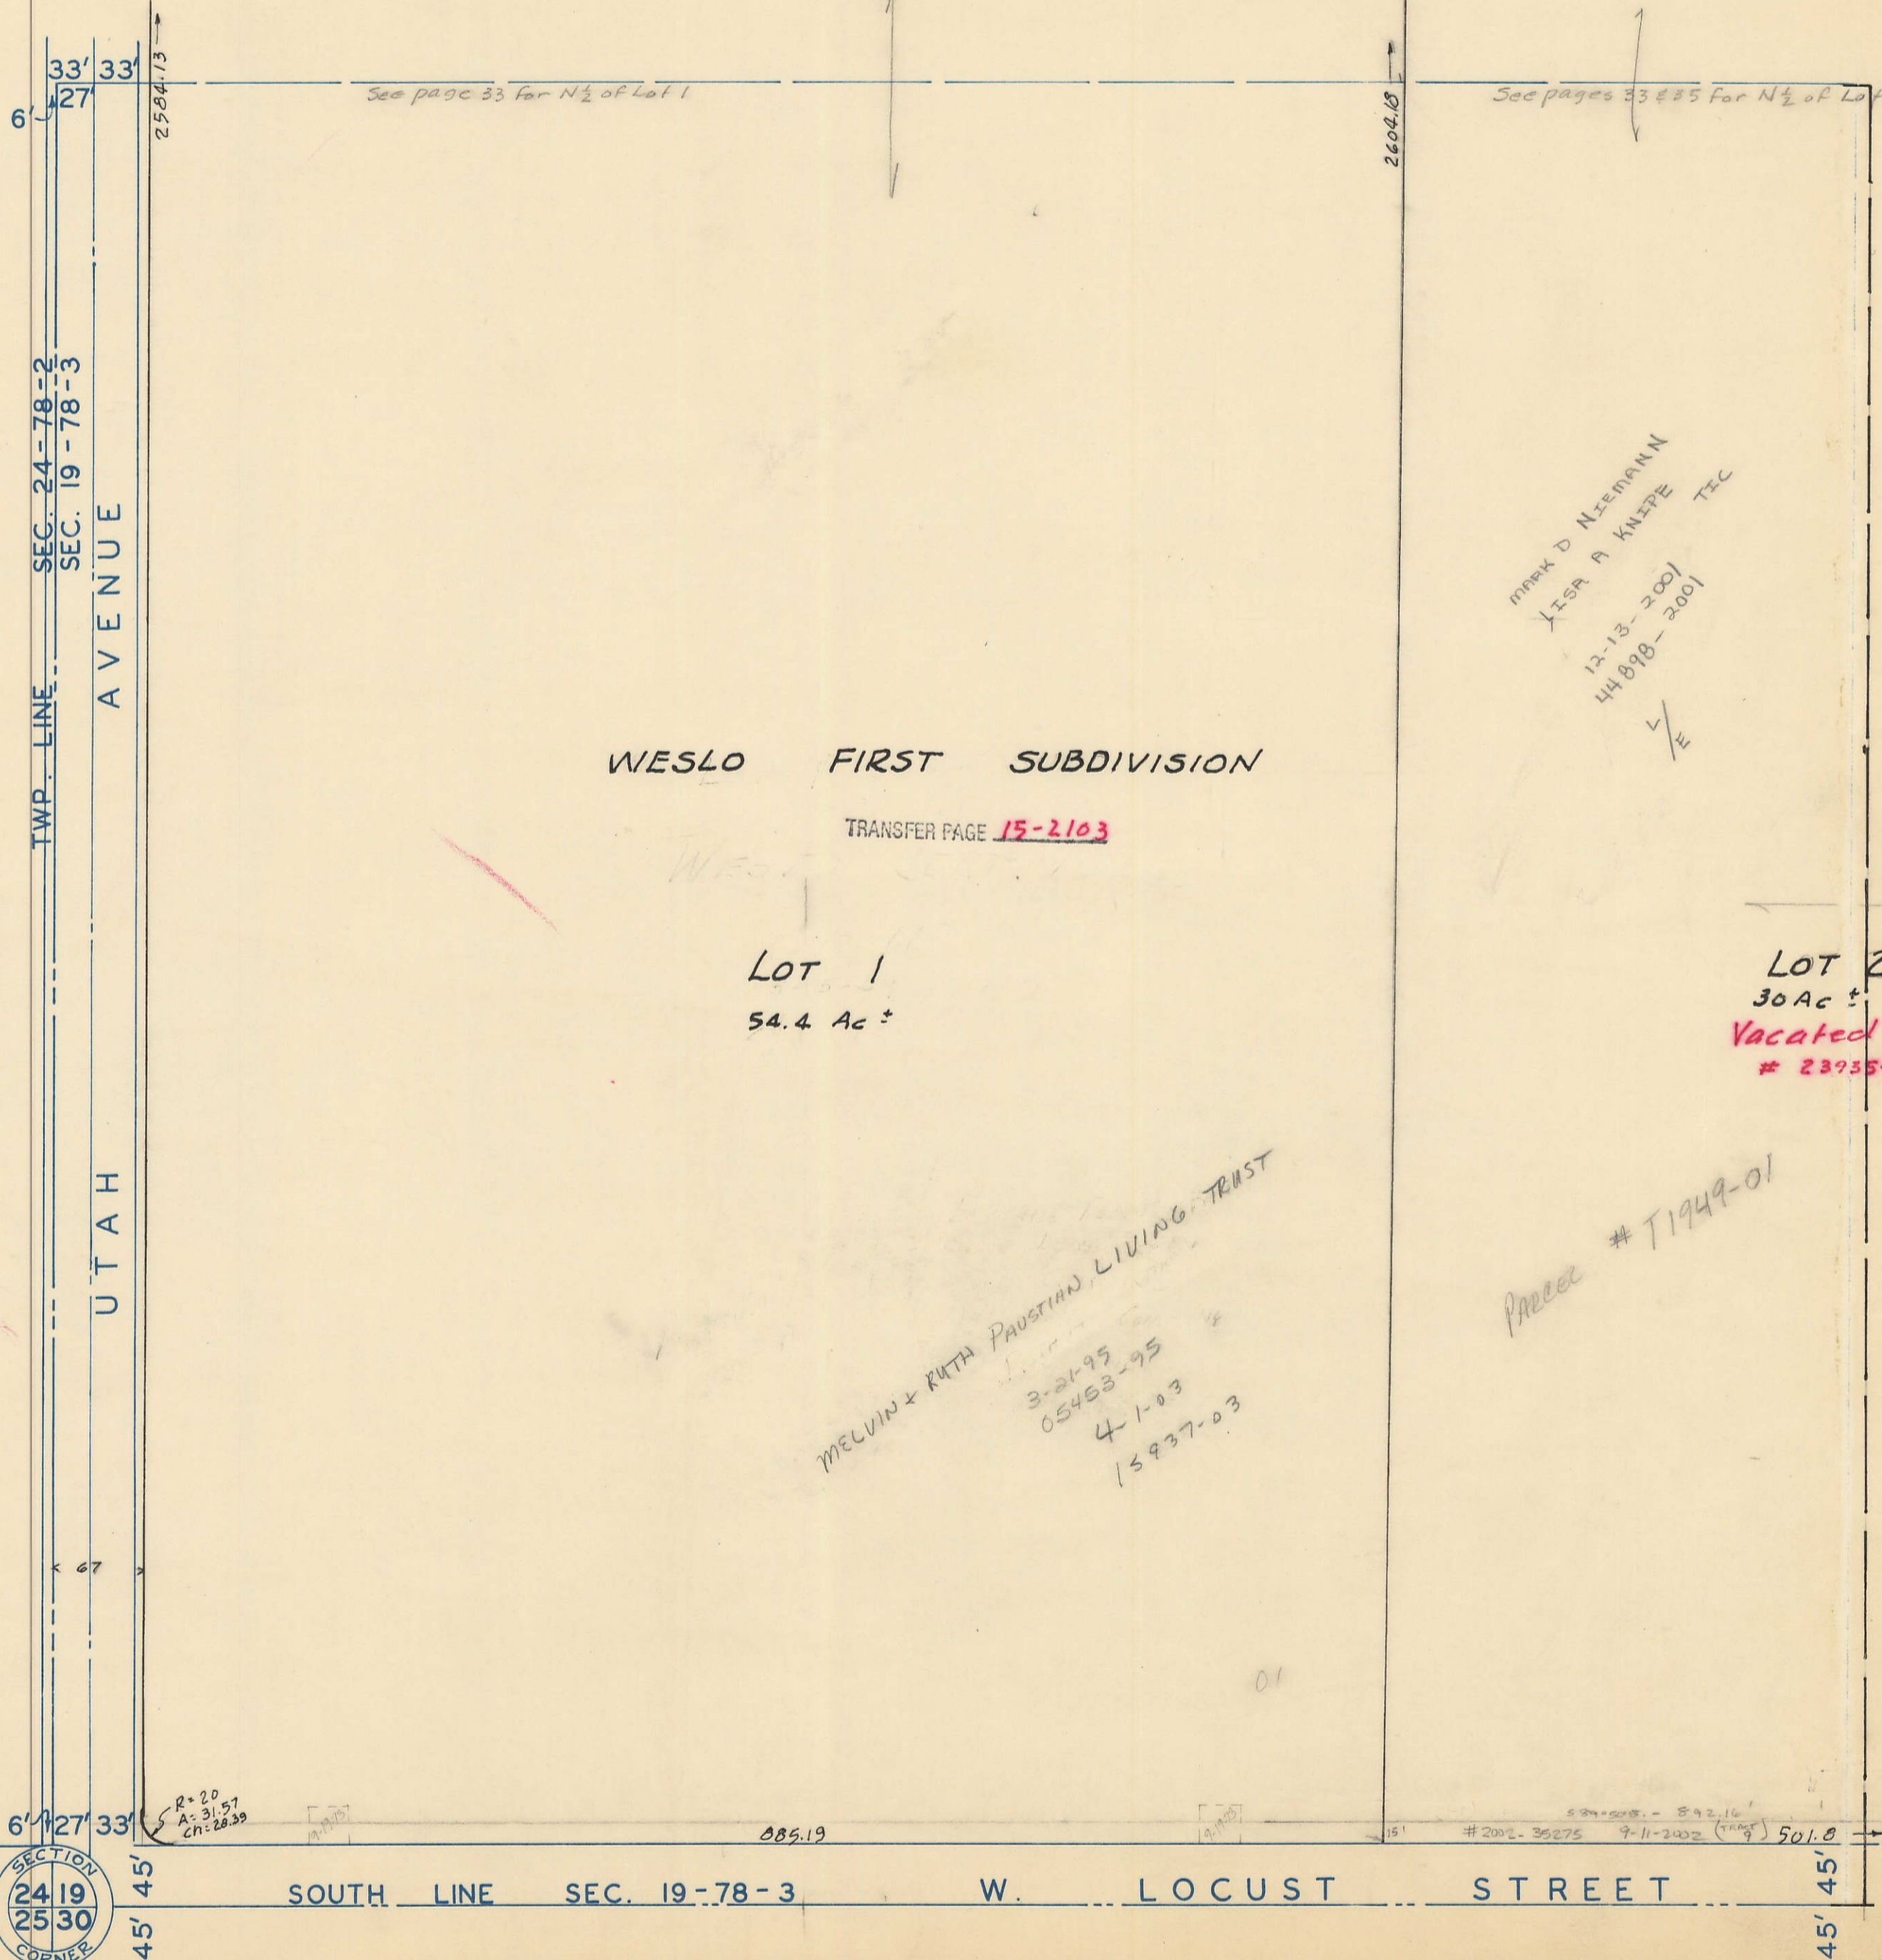

See page 33 for N 1/2 of Lot 1

See pages 33 & 35 for N 1/2 of Lot 2

WESLO FIRST SUBDIVISION

TRANSFER PAGE 15-2103

LOT 1
54.4 Ac ±

LOT 2
30 Ac ±
Vacated 12-23-87
23955-87

MARK D NIEMANN
KISA A KNEPE TIC
12-13-2001
44898-2001
1/2 E

MELVIN + RUTH PAUSTIAN LIVING TRUST
3-21-95
05453-95
4-1-03
15937-03

Parcel # T1949-01

T-24

55

51

SECTION
24 19
25 30
CORNER

S-30

1

R=20
A=31.57
CH=28.39

524-005-892.16
#2002-35275 9-11-2002 (TRAC) 501.8