


TRANSFER PAGE 51ds-44

12-55

SECTION
12.7
13.18
CORNER

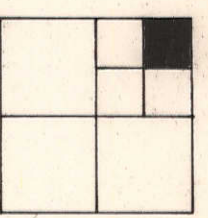


5

12-23-76
24685-76
Dexter,
Dale & Marla

11-29-2000
34644-00
3-2168-2000

ANNEXED TO CITY 2-2-76

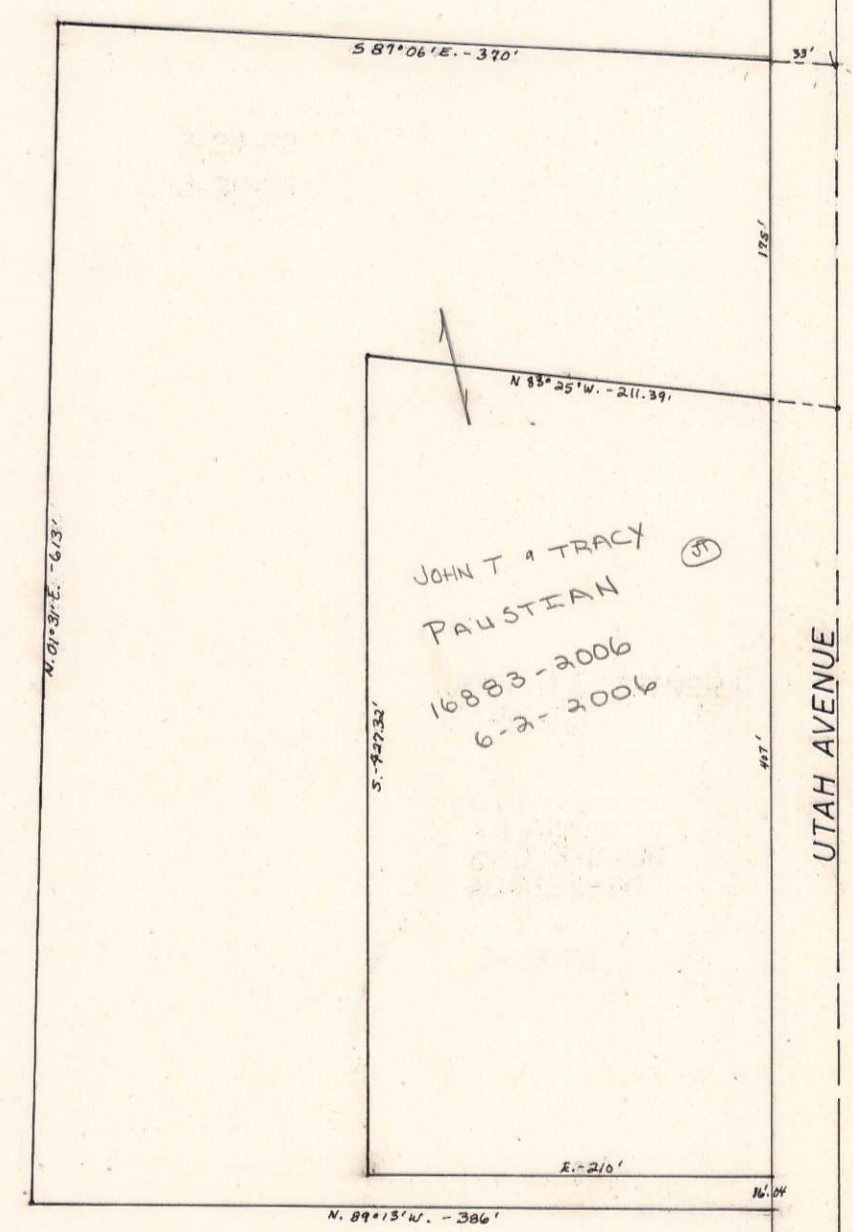

UTAH AVENUE

18-1

23