


Transfer Page *62ds-187*

U-7

55

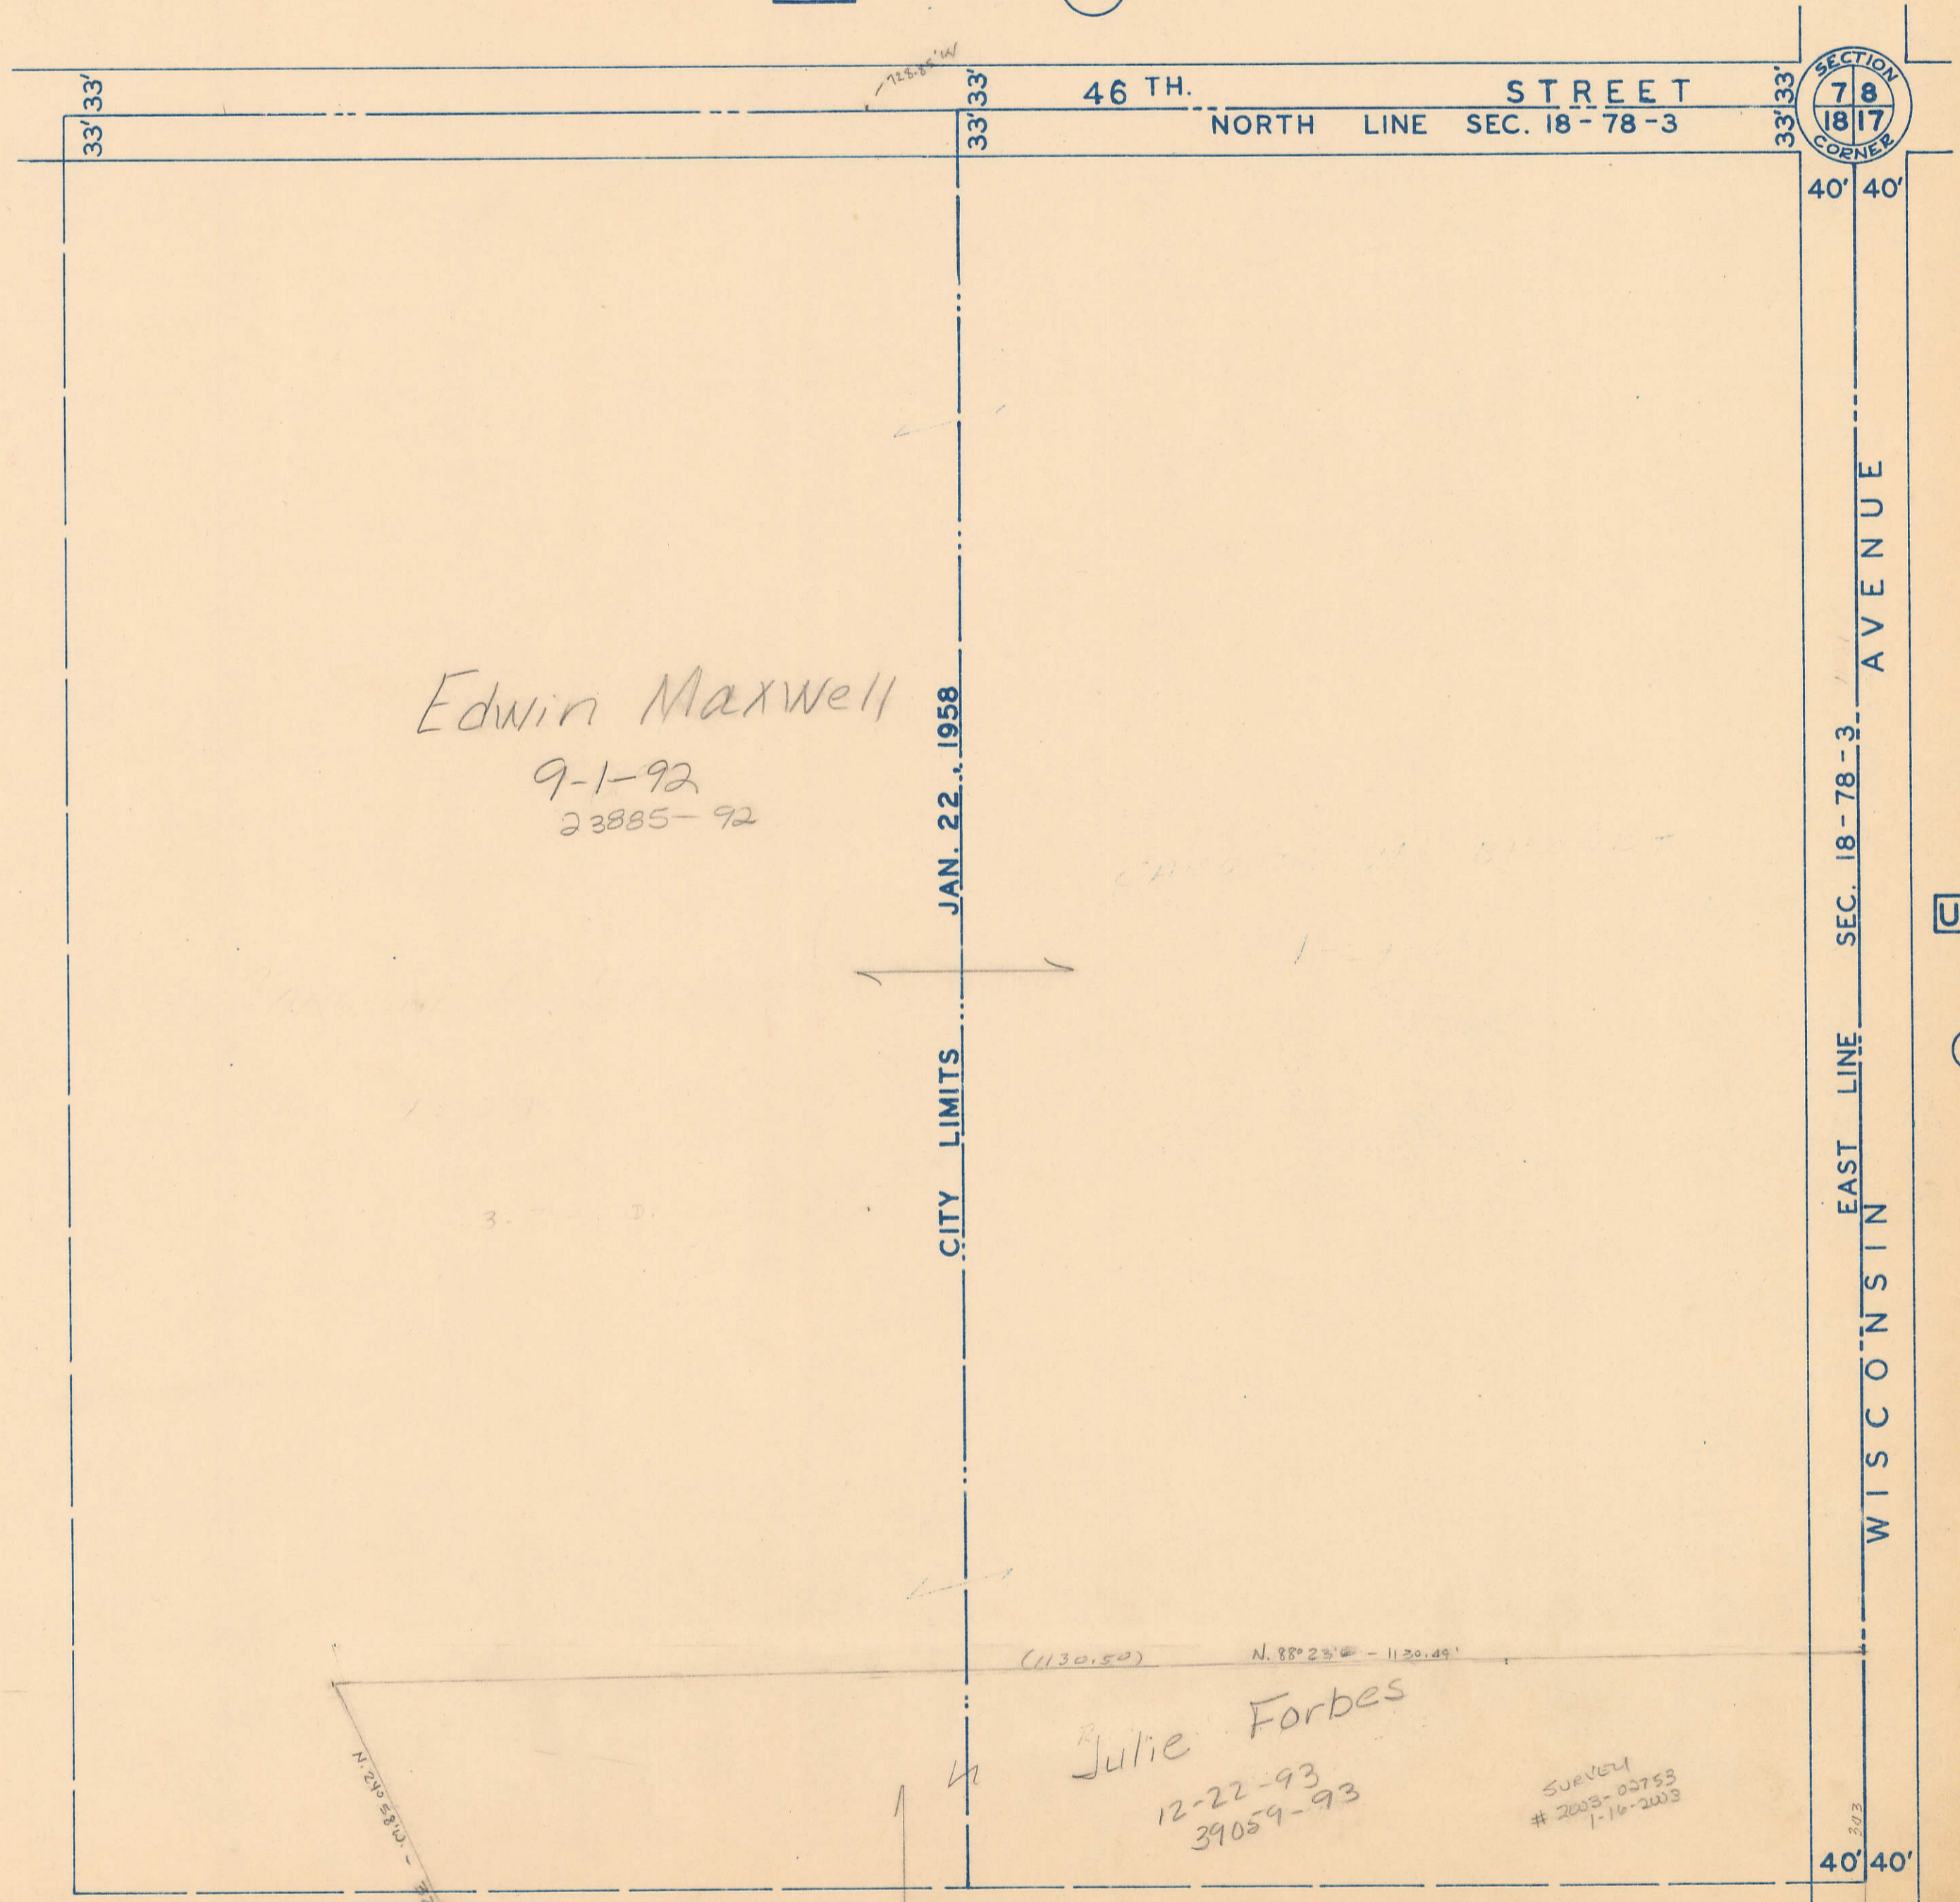

5

U-17

1

23

SURVEY
2003-02753
1-16-2003