

35

2-8-1999

7-5-91
14172-91

49

WILLIAM E PUCK - Trustee


8-13-01
27314-01

4-9-29
10-6-54
8-31-83
11-4-83 cot

53

1/4 SECTION LINE

COMBINED THIS
PIECE INTO FARM
LAND FOR '06

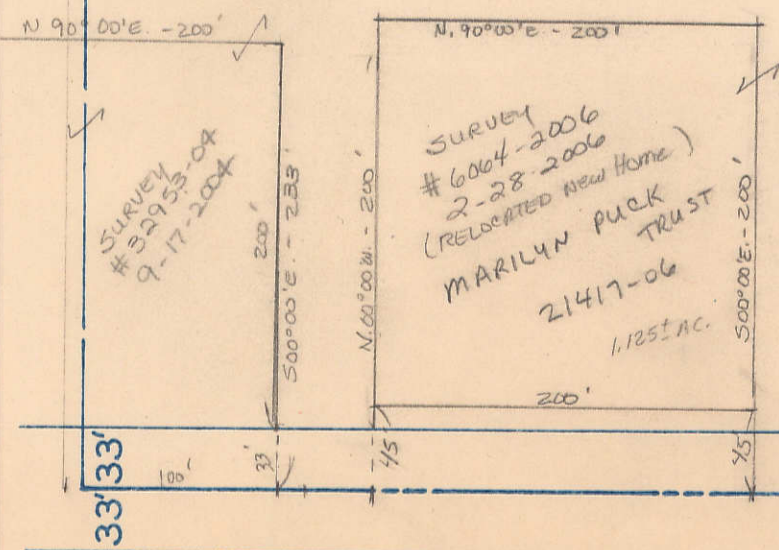

46 TH SOUTH LINE SEC. 7-78-3 STREET

U-18

3

