S.W. 1/4, N.W. 1/4
SEC. 17 - 78 - 3
SCALE: 1 in. = 100 ft.

17

Transfer Page 61ds-186
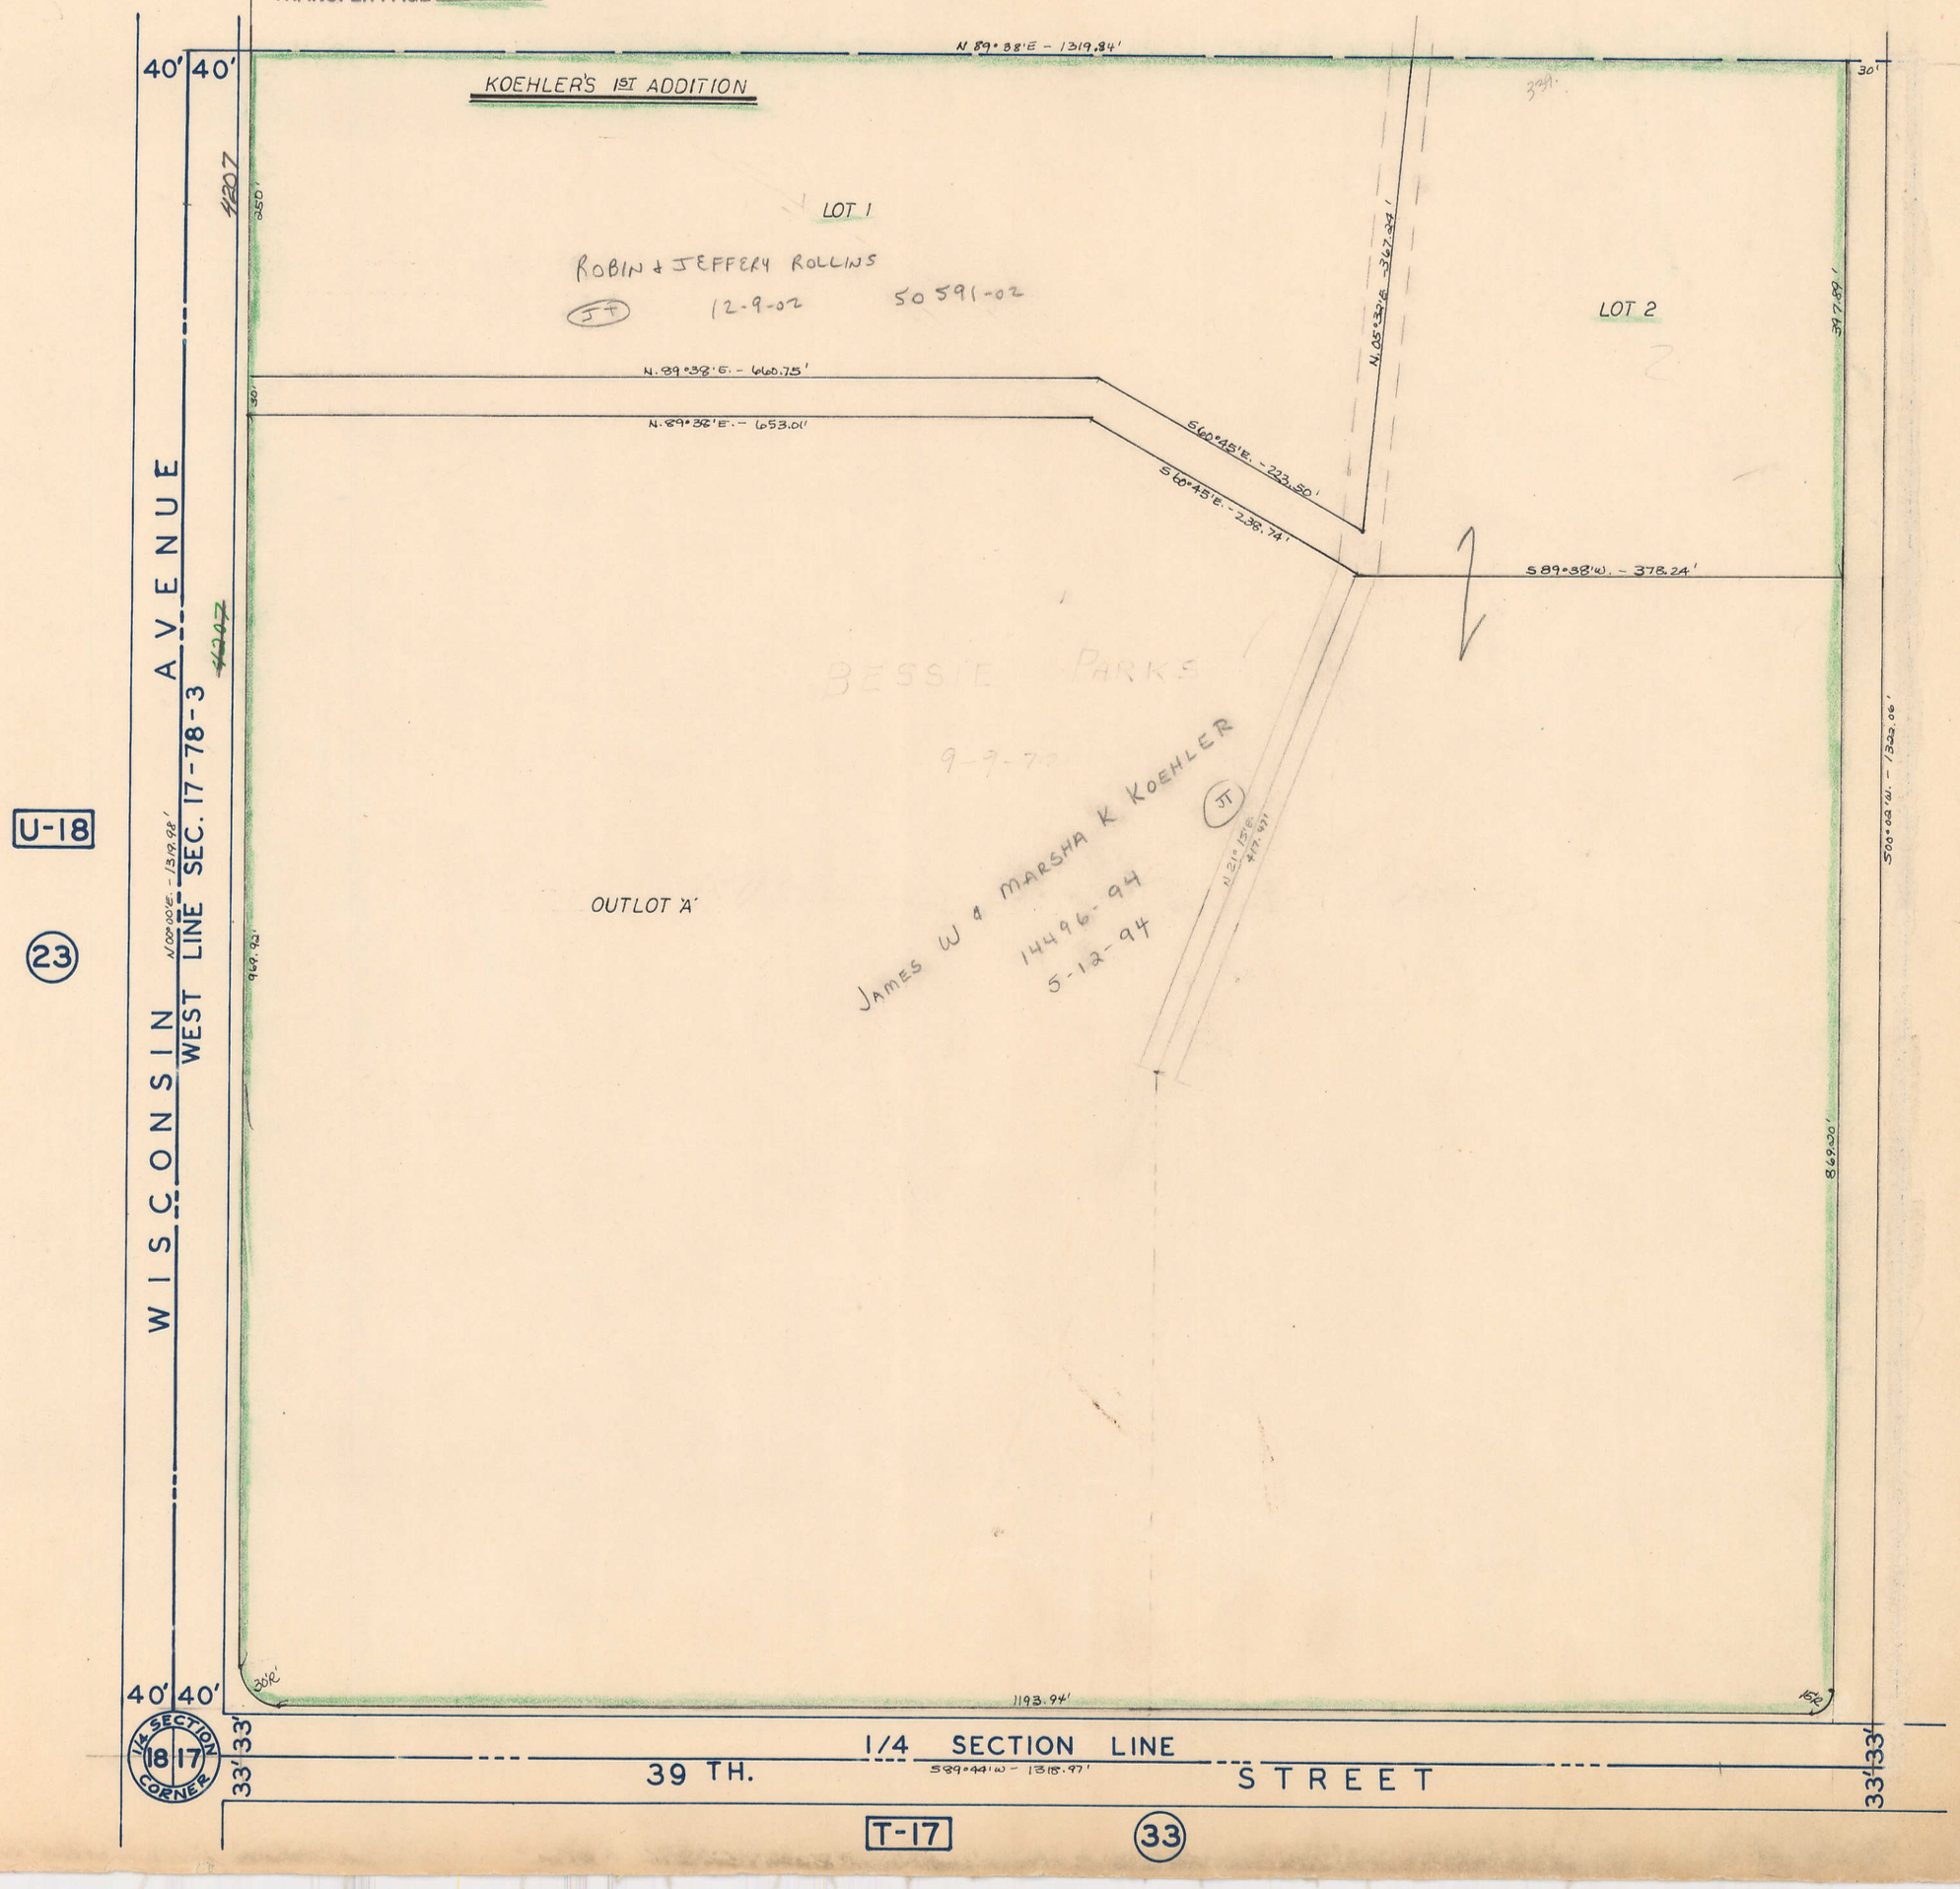
TRANSFER PAGE 15A-2590