



7

Transfer Page 62ds-176

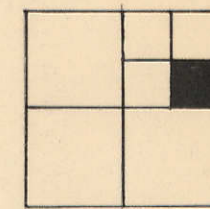

21

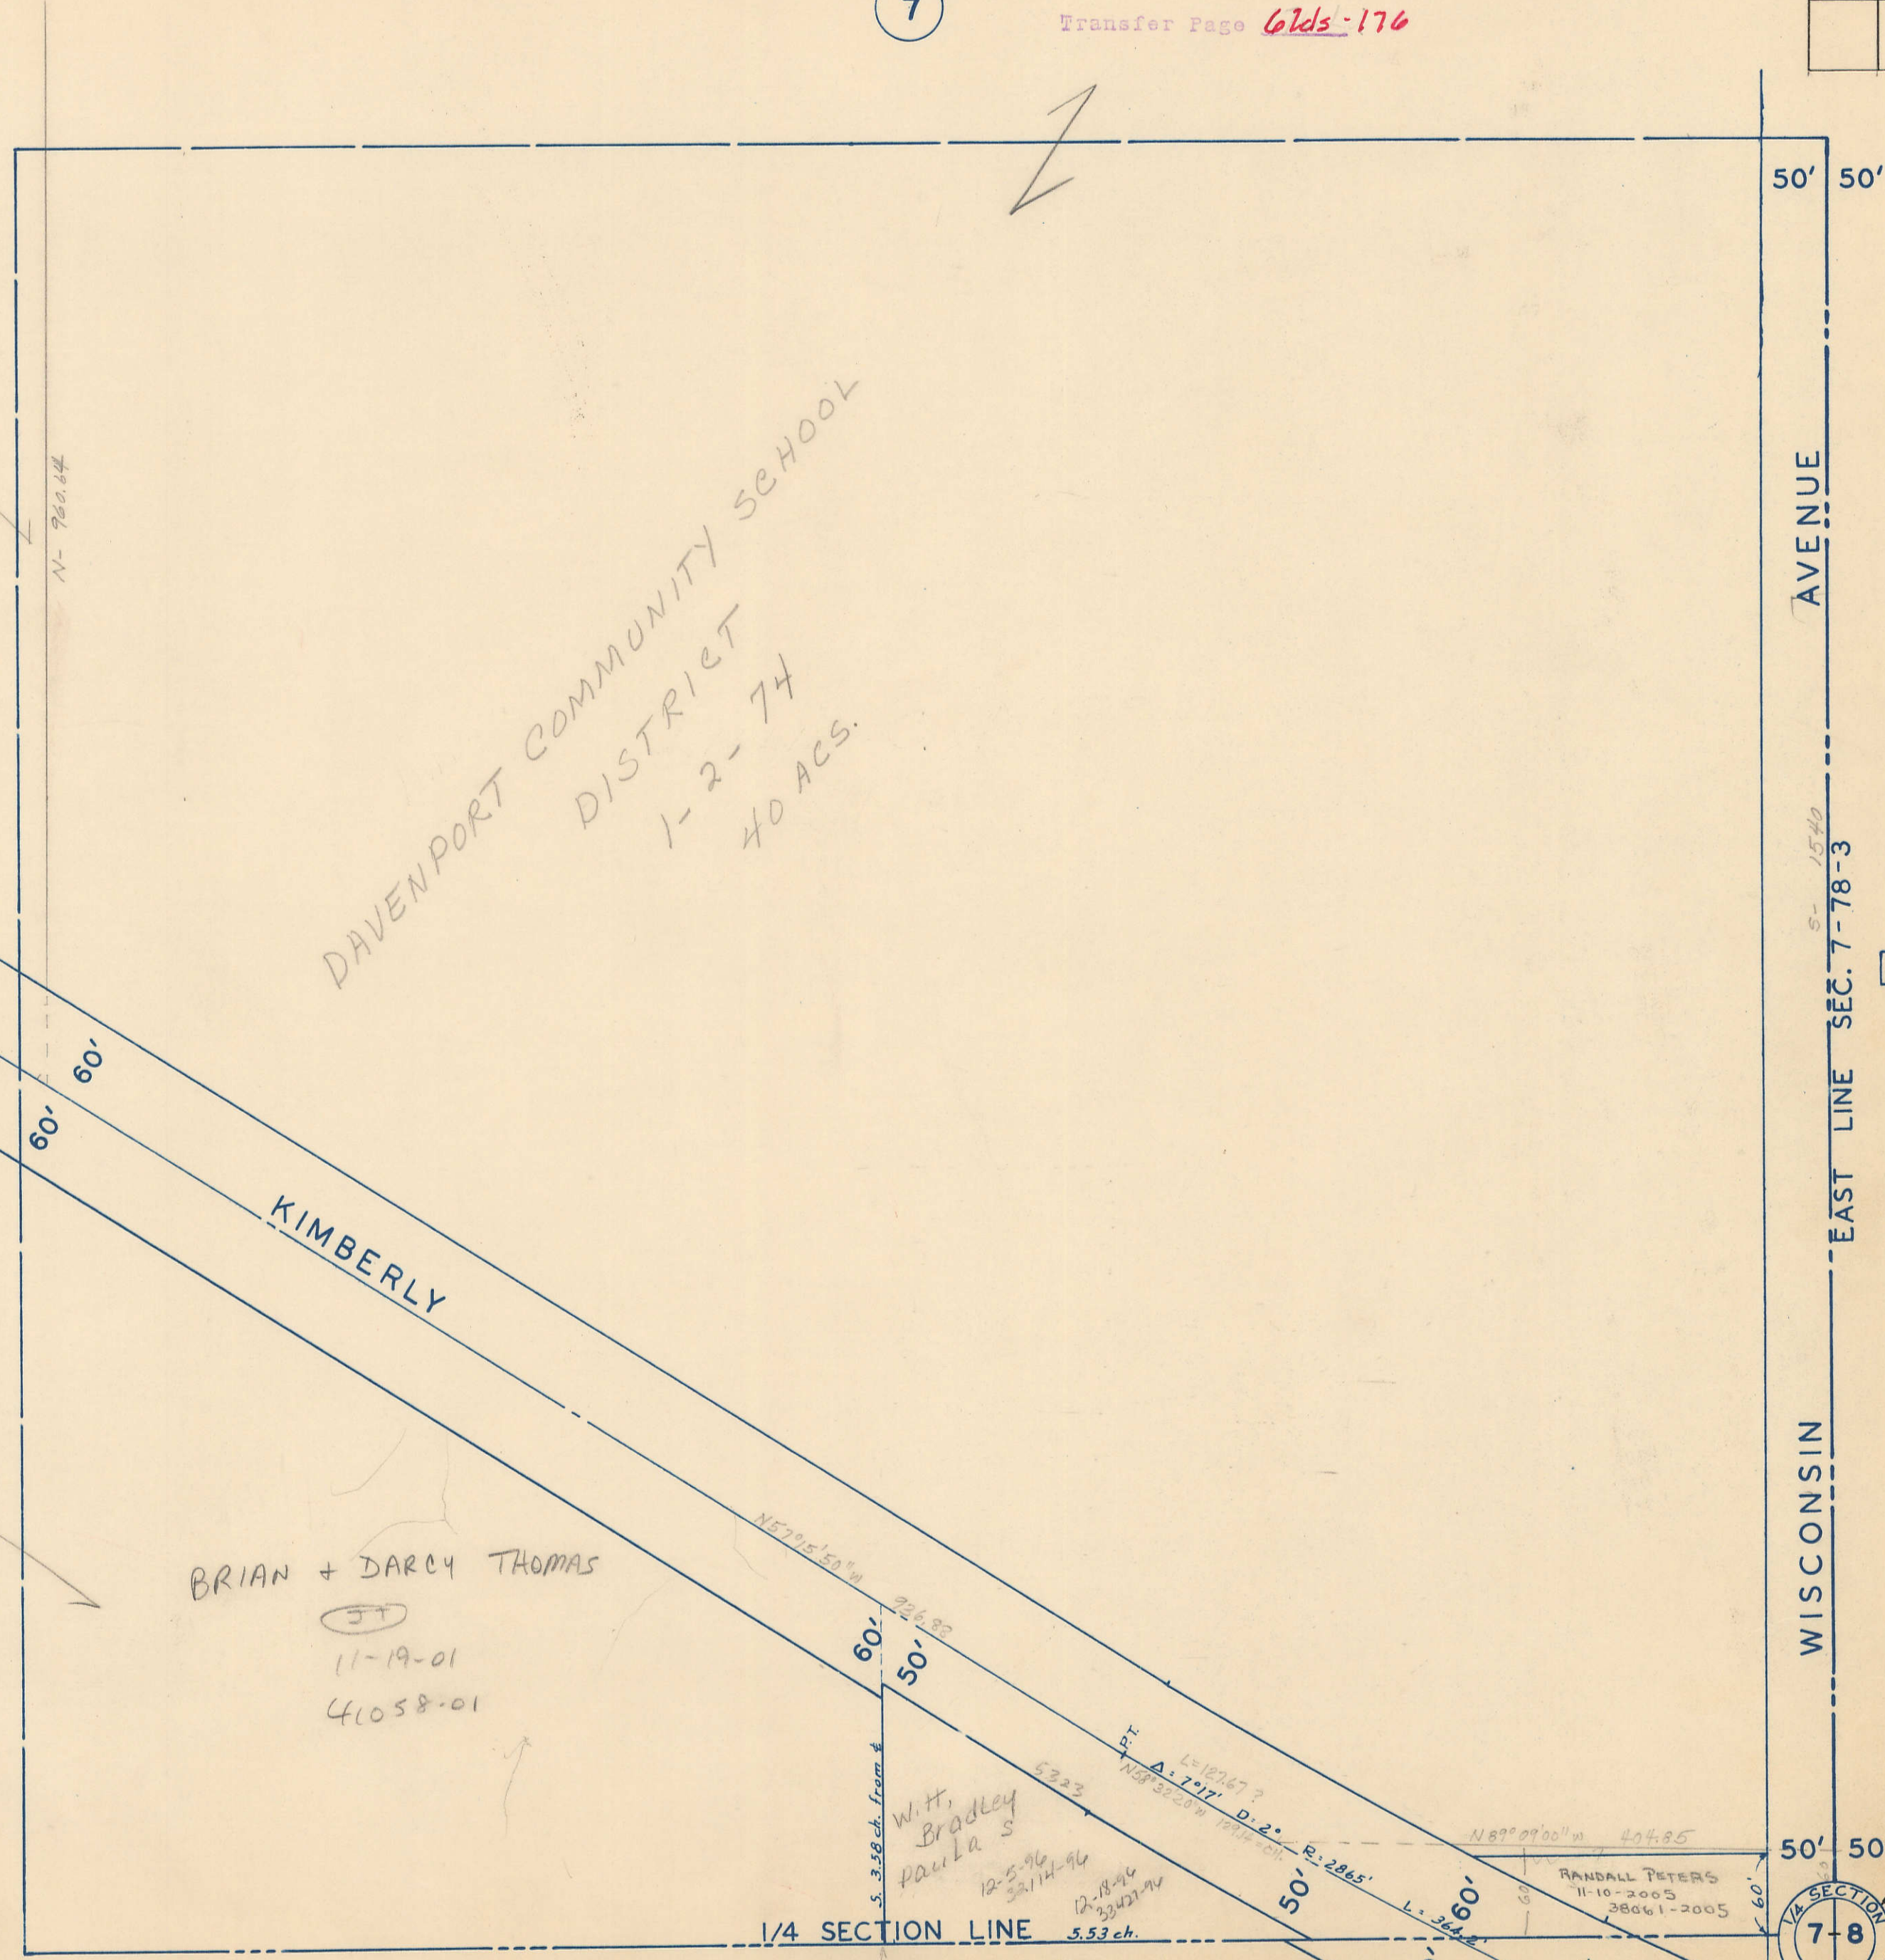

V-8

17

U-7

39

VIA SECTION CORNER 7-8

E. 1/4 Corner SEC. 7