


TRANSFER PAGE *81ds-455*

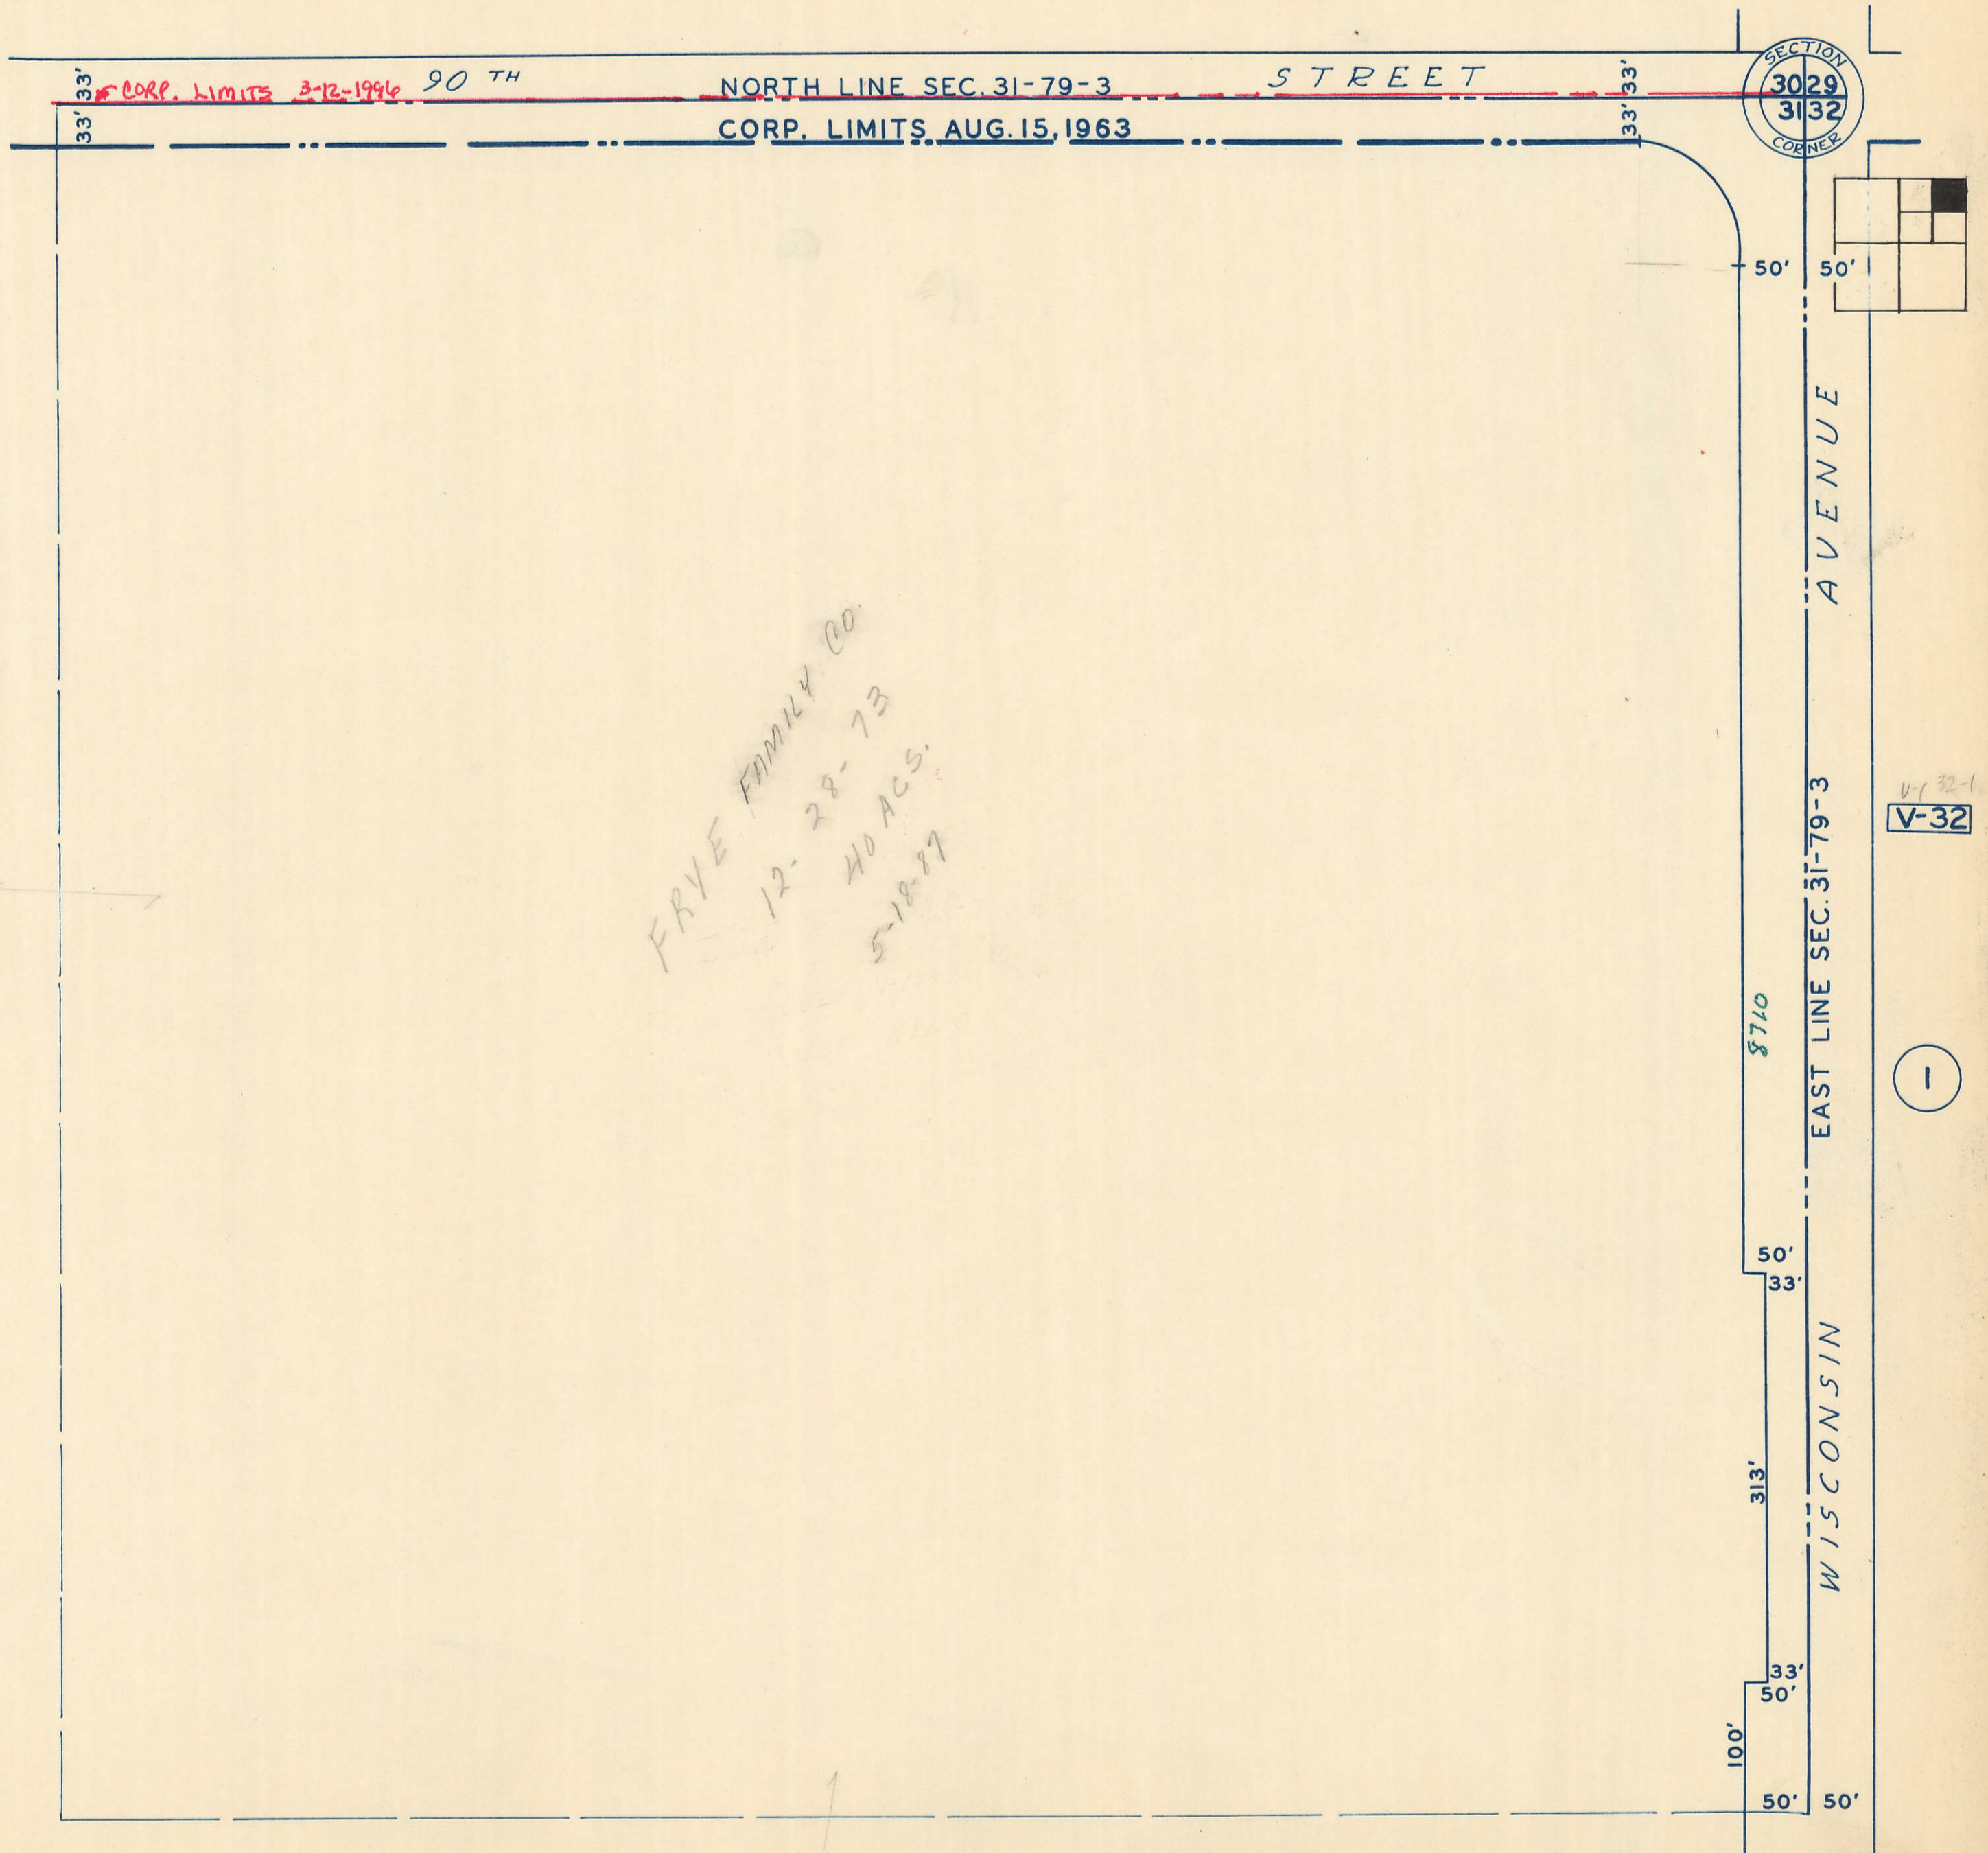

5

*FRYE FAMILY CO.
12-28-73
40 AC.S.
5-18-87*

V-32-1
V-32

1

23