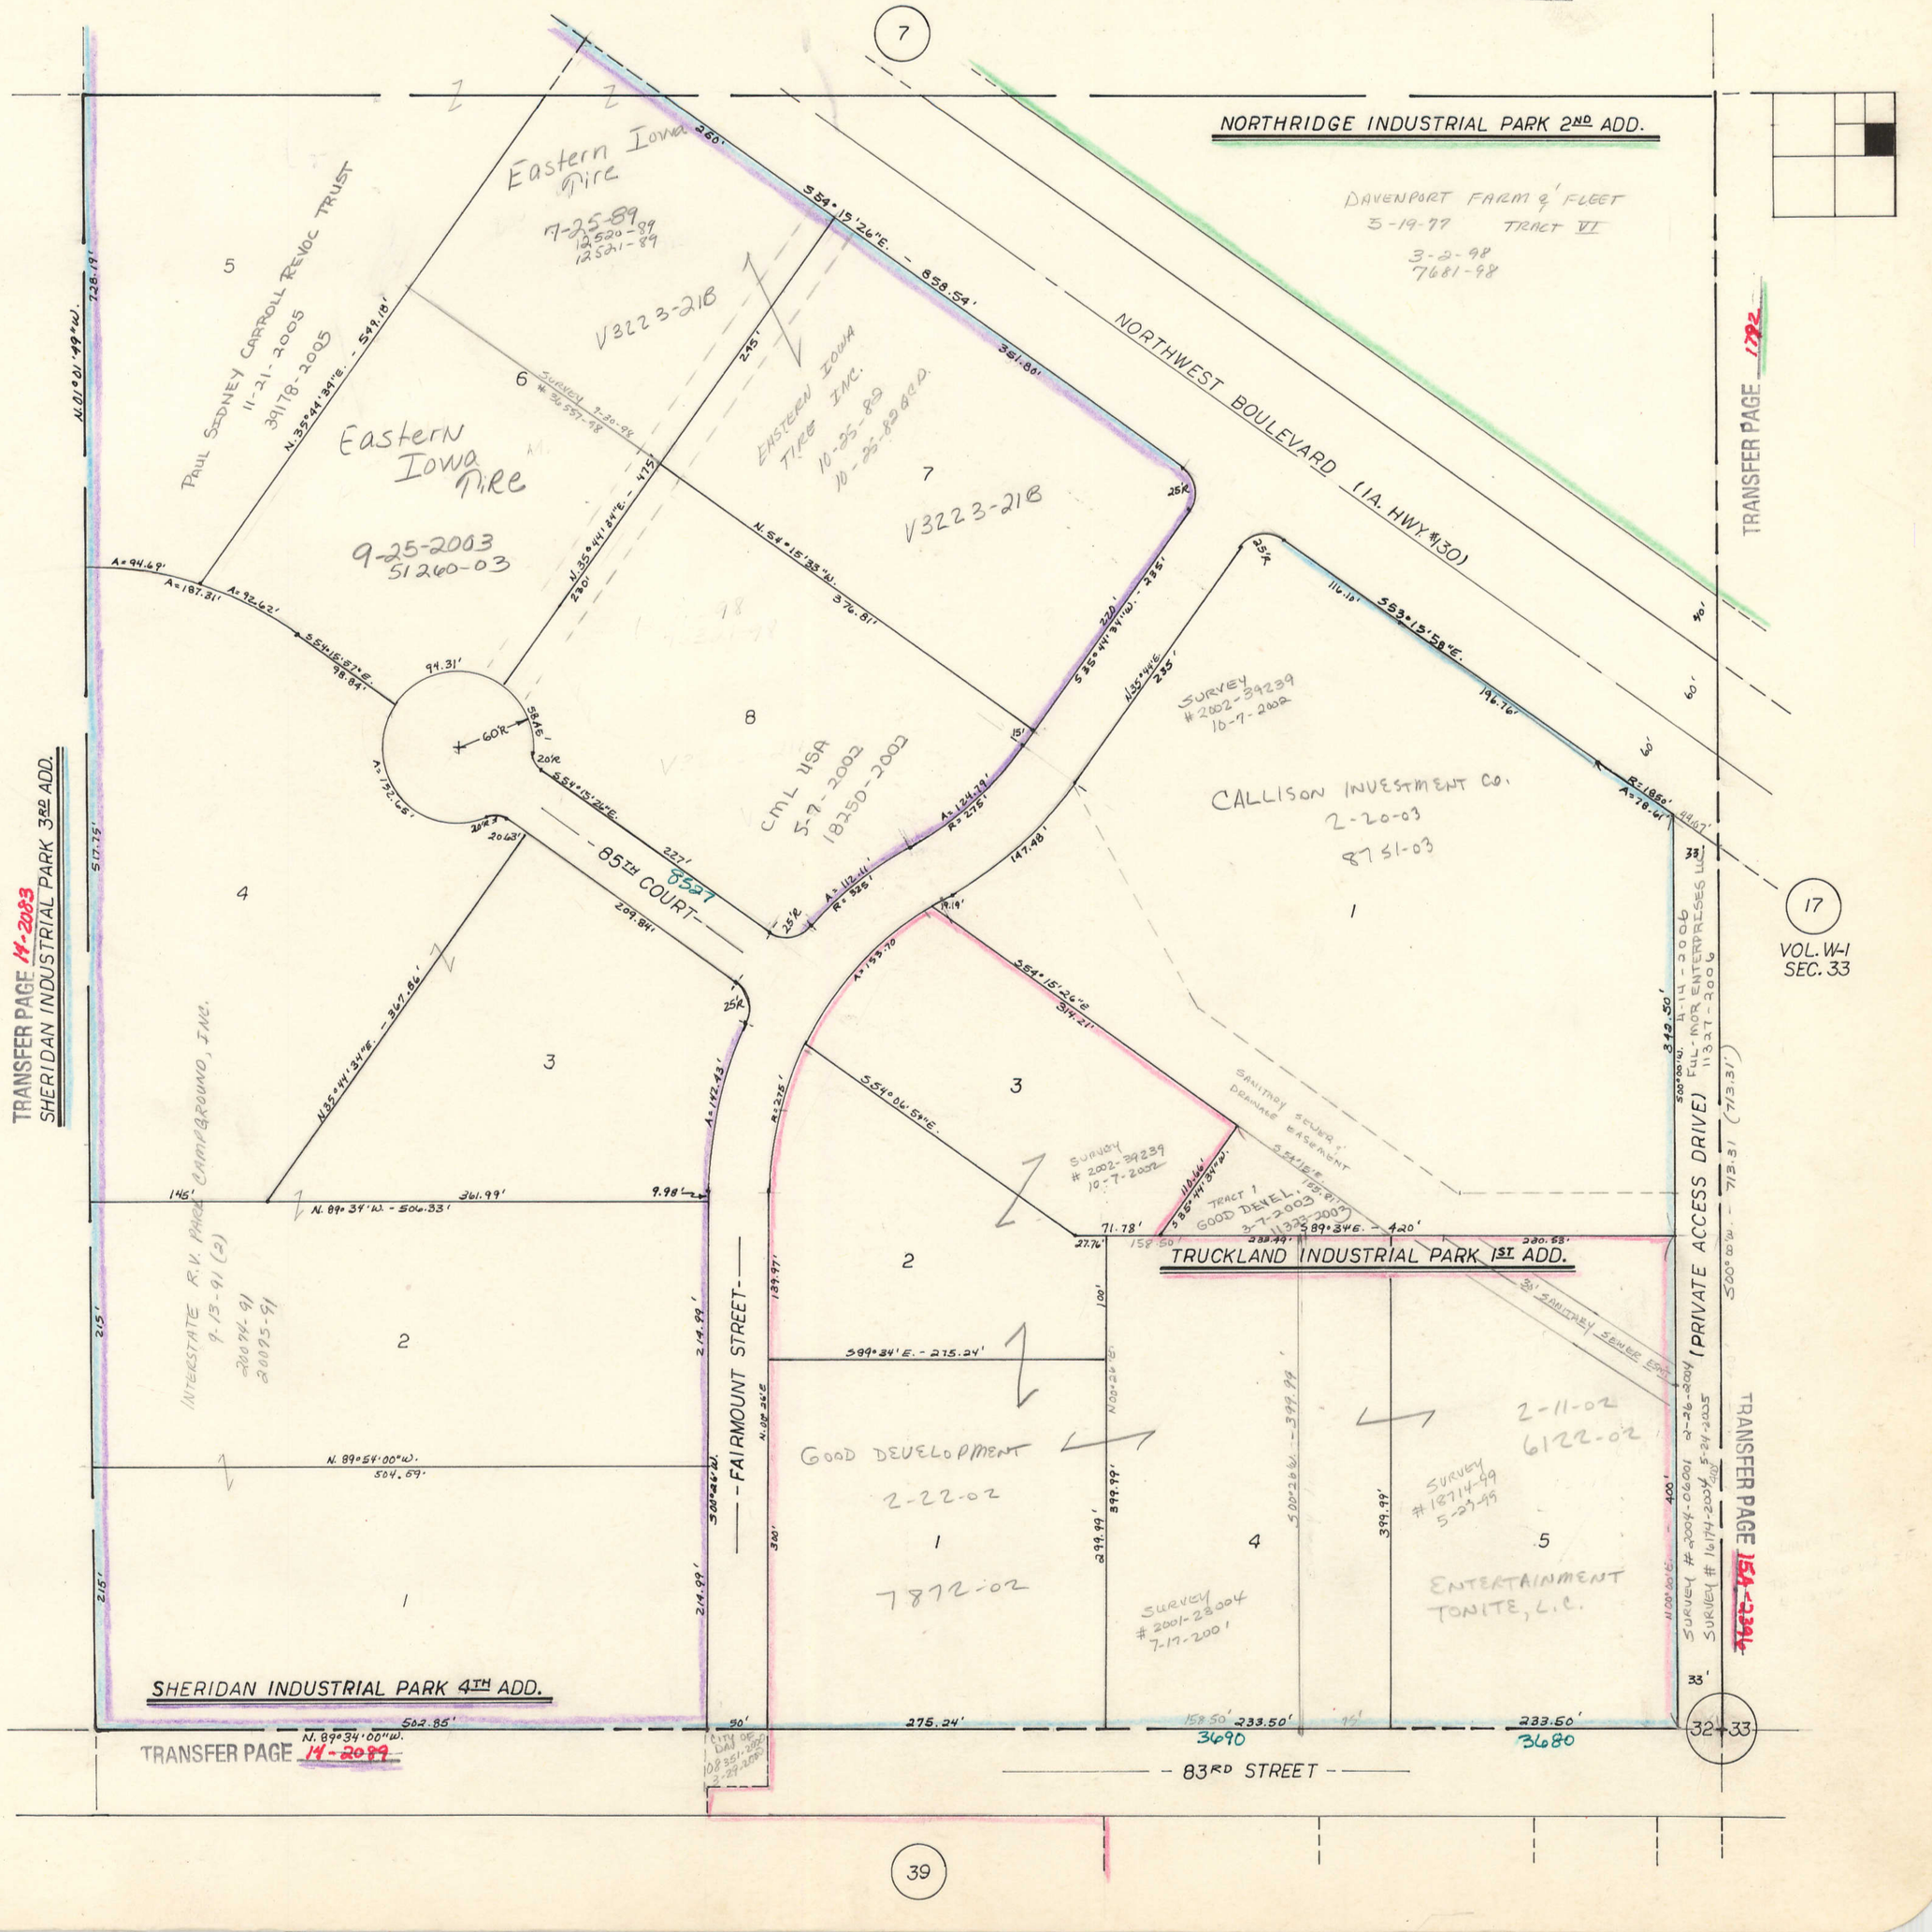
NORTHRIDGE INDUSTRIAL PARK 2ND ADD.
NORTHWEST BOULEVARD (IA. HWY #30)
DAVENPORT FARM & FLEET
5-19-99 TRACT VI
3-2-98
7681-98
TRANSFER PAGE 1782
Eastern Iowa Tire
7-25-89
12520-89
12521-89
V3223-218
PAUL SIDNEY CARROLL REVOC TRUST
11-21-2005
39178-2005
Eastern Iowa Tire
9-25-2003
51260-03
EASTERN IOWA TIRE INC.
10-25-89
10-25-89 AGR.
CML USA
5-7-2002
18250-2002
SURVEY #2002-39239
10-7-2002
CALLISON INVESTMENT CO.
2-20-03
8751-03
85TH COURT
8527
INTERSTATE R.V. PARK CAMPGROUND, INC.
9-13-91 (2)
20094-91
20095-91
SHERIDAN INDUSTRIAL PARK 3RD ADD.
TRANSFER PAGE 14-2083
SHERIDAN INDUSTRIAL PARK 4TH ADD.
TRANSFER PAGE 14-2089
FAIRMOUNT STREET
GOOD DEVELOPMENT
2-22-02
7872-02
SURVEY #2002-39239
10-7-2002
TRACT 1 GOOD DEVEL.
3-7-2003
11335-2003
TRUCKLAND INDUSTRIAL PARK 1ST ADD.
SURVEY #18714-99
5-23-99
2-11-02
6122-02
ENTERTAINMENT TONITE, L.L.
SURVEY #2001-28004
7-17-2001
(PRIVATE ACCESS DRIVE)
FUL-MOR ENTERPRISES LLC
4-14-2006
11327-2006
SURVEY #2004-06001
2-26-2004
SURVEY #16174-2004
5-24-2005
TRANSFER PAGE 154-2346
83RD STREET
3690
3680
TRANSFER PAGE 1782
VOL. W-1
SEC. 33
21
17
32-33
39