


TRANSFER PAGE ~~15A-2367~~  
SMARTIS 1ST ADD.

19

3  
SECTION

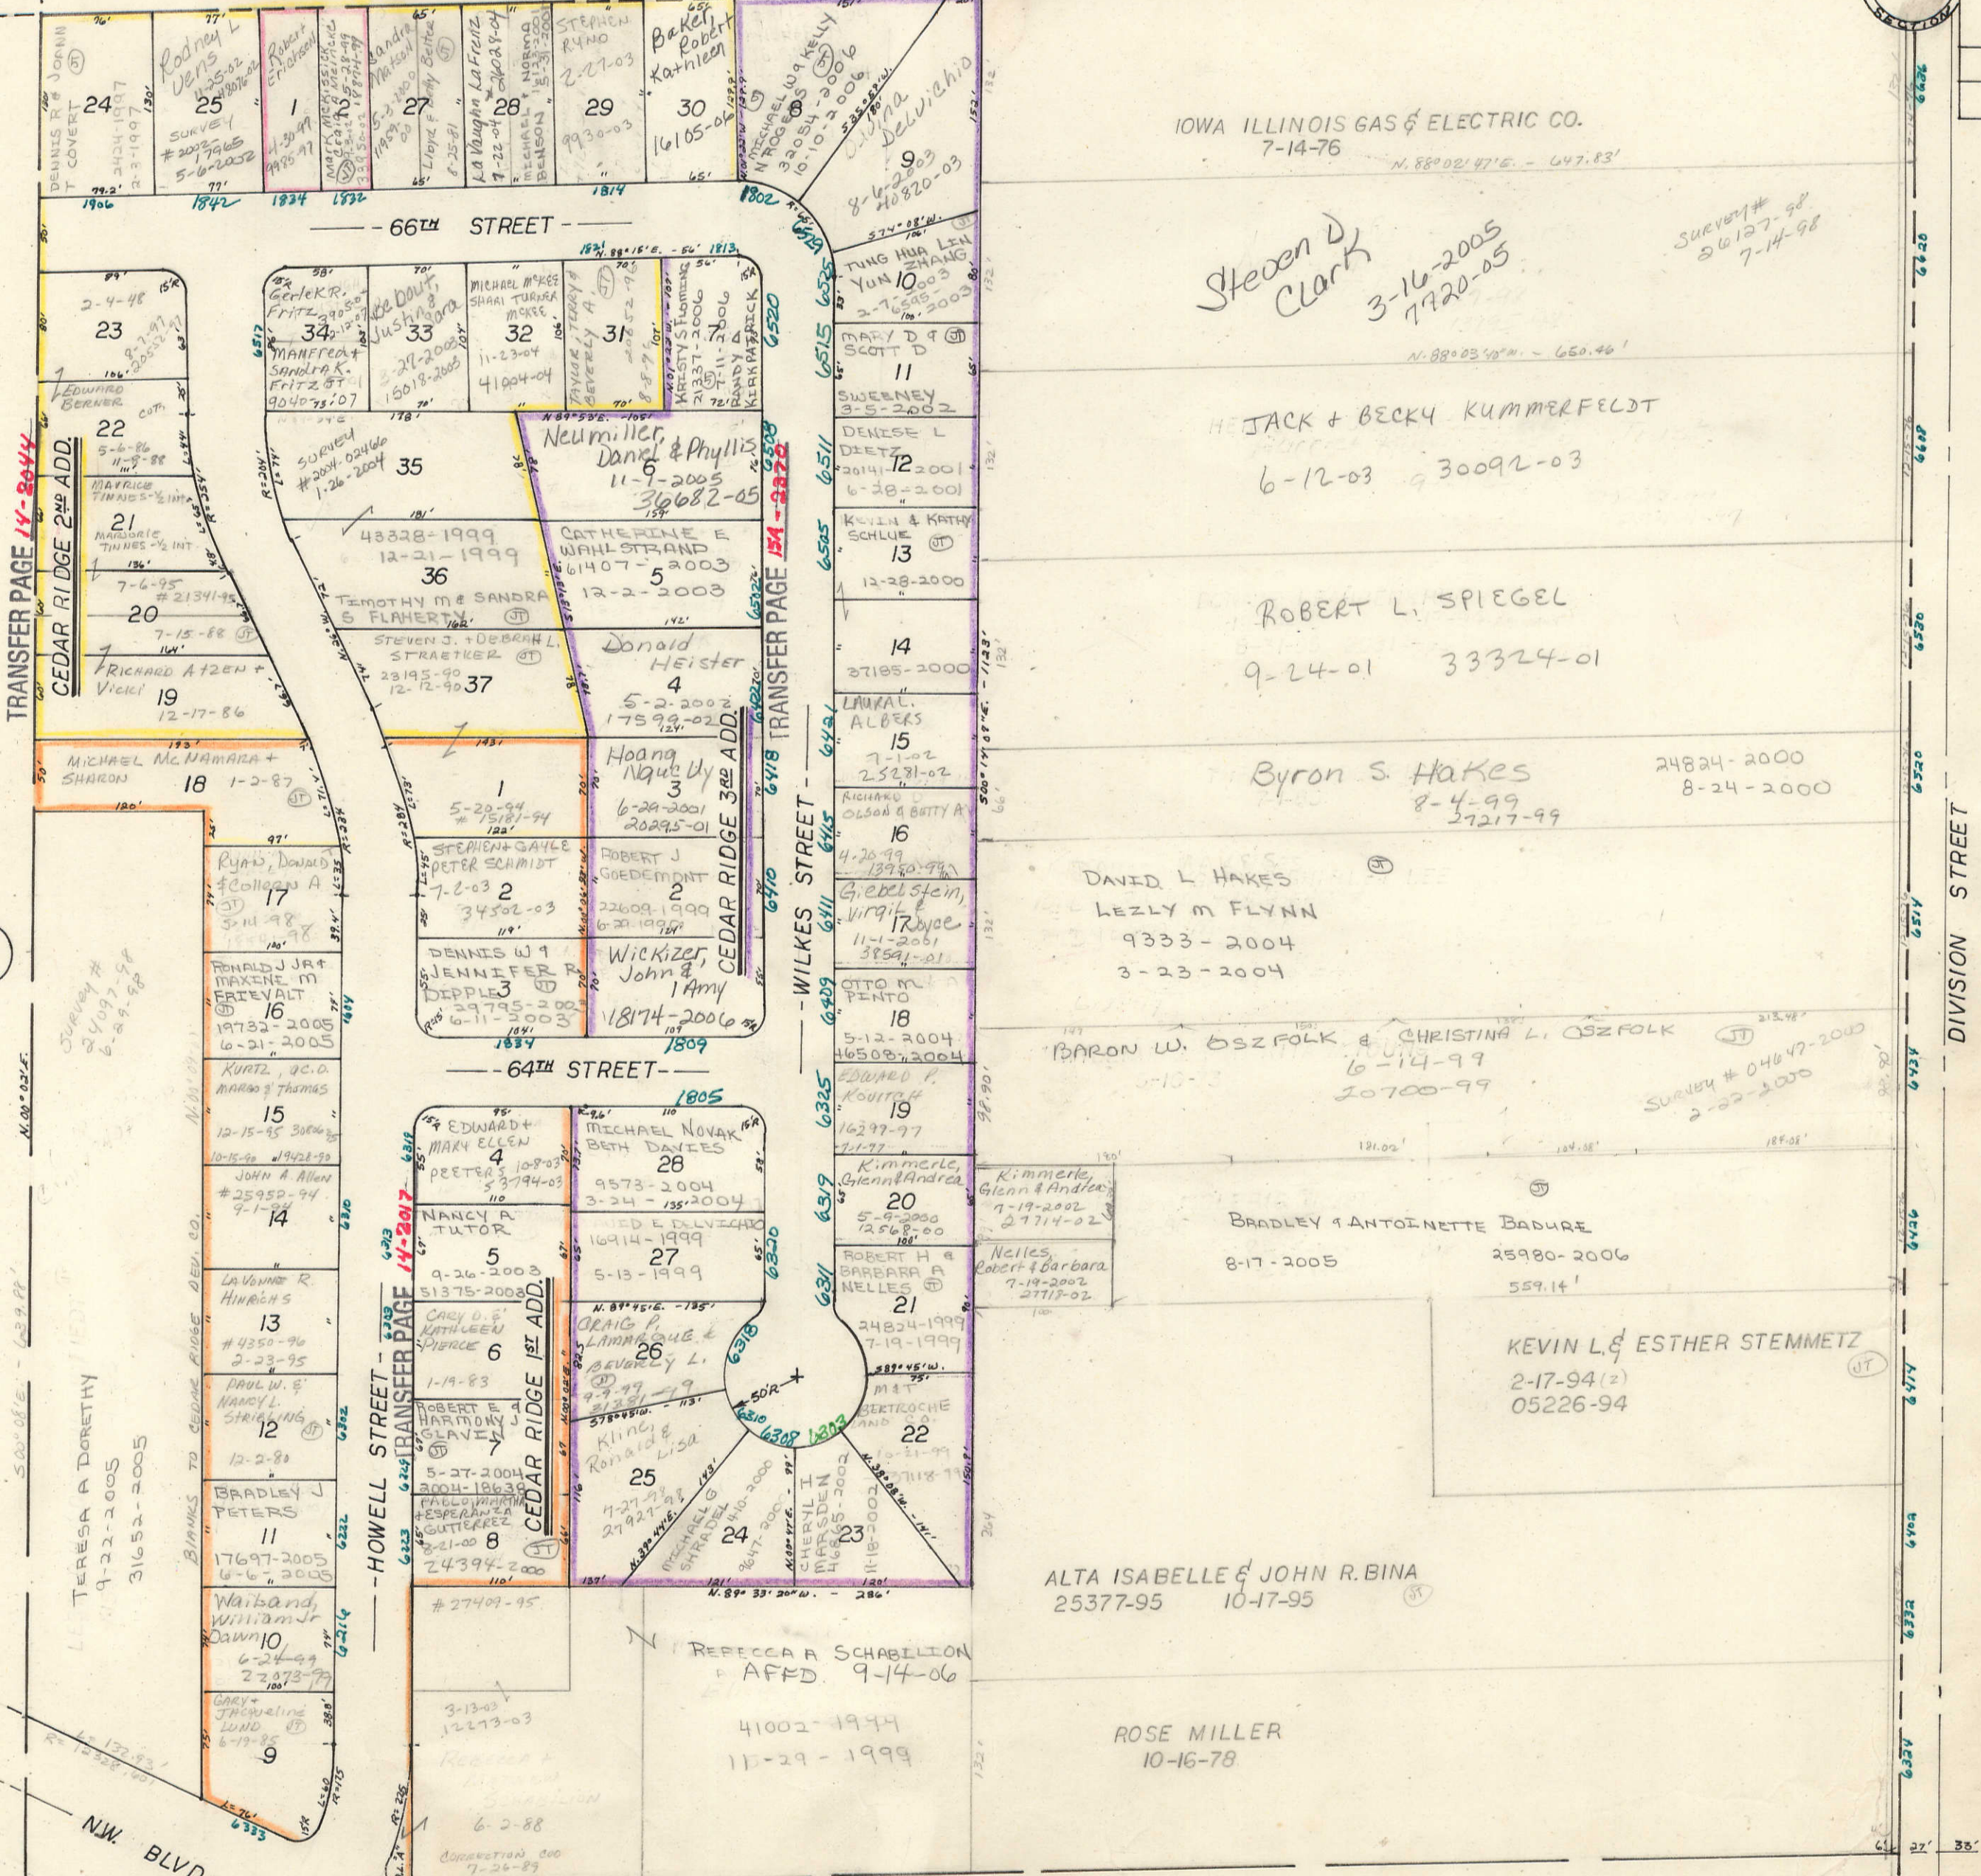

TRANSFER PAGE 14-2044  
CEDAR RIDGE 2ND ADD.

TRANSFER PAGE 15A-2322  
CEDAR RIDGE 3RD ADD.

TRANSFER PAGE 14-2017  
CEDAR RIDGE 1ST ADD.

33

37

51

SEC. 3-78-3