

SECTION
3
CENTER

6' - 2733'

STREET


1/4 SECTION LINE

DIVISION

6' - 2733'

TRANSFER PAGE 15A-2484

Transfer Page 62d-172

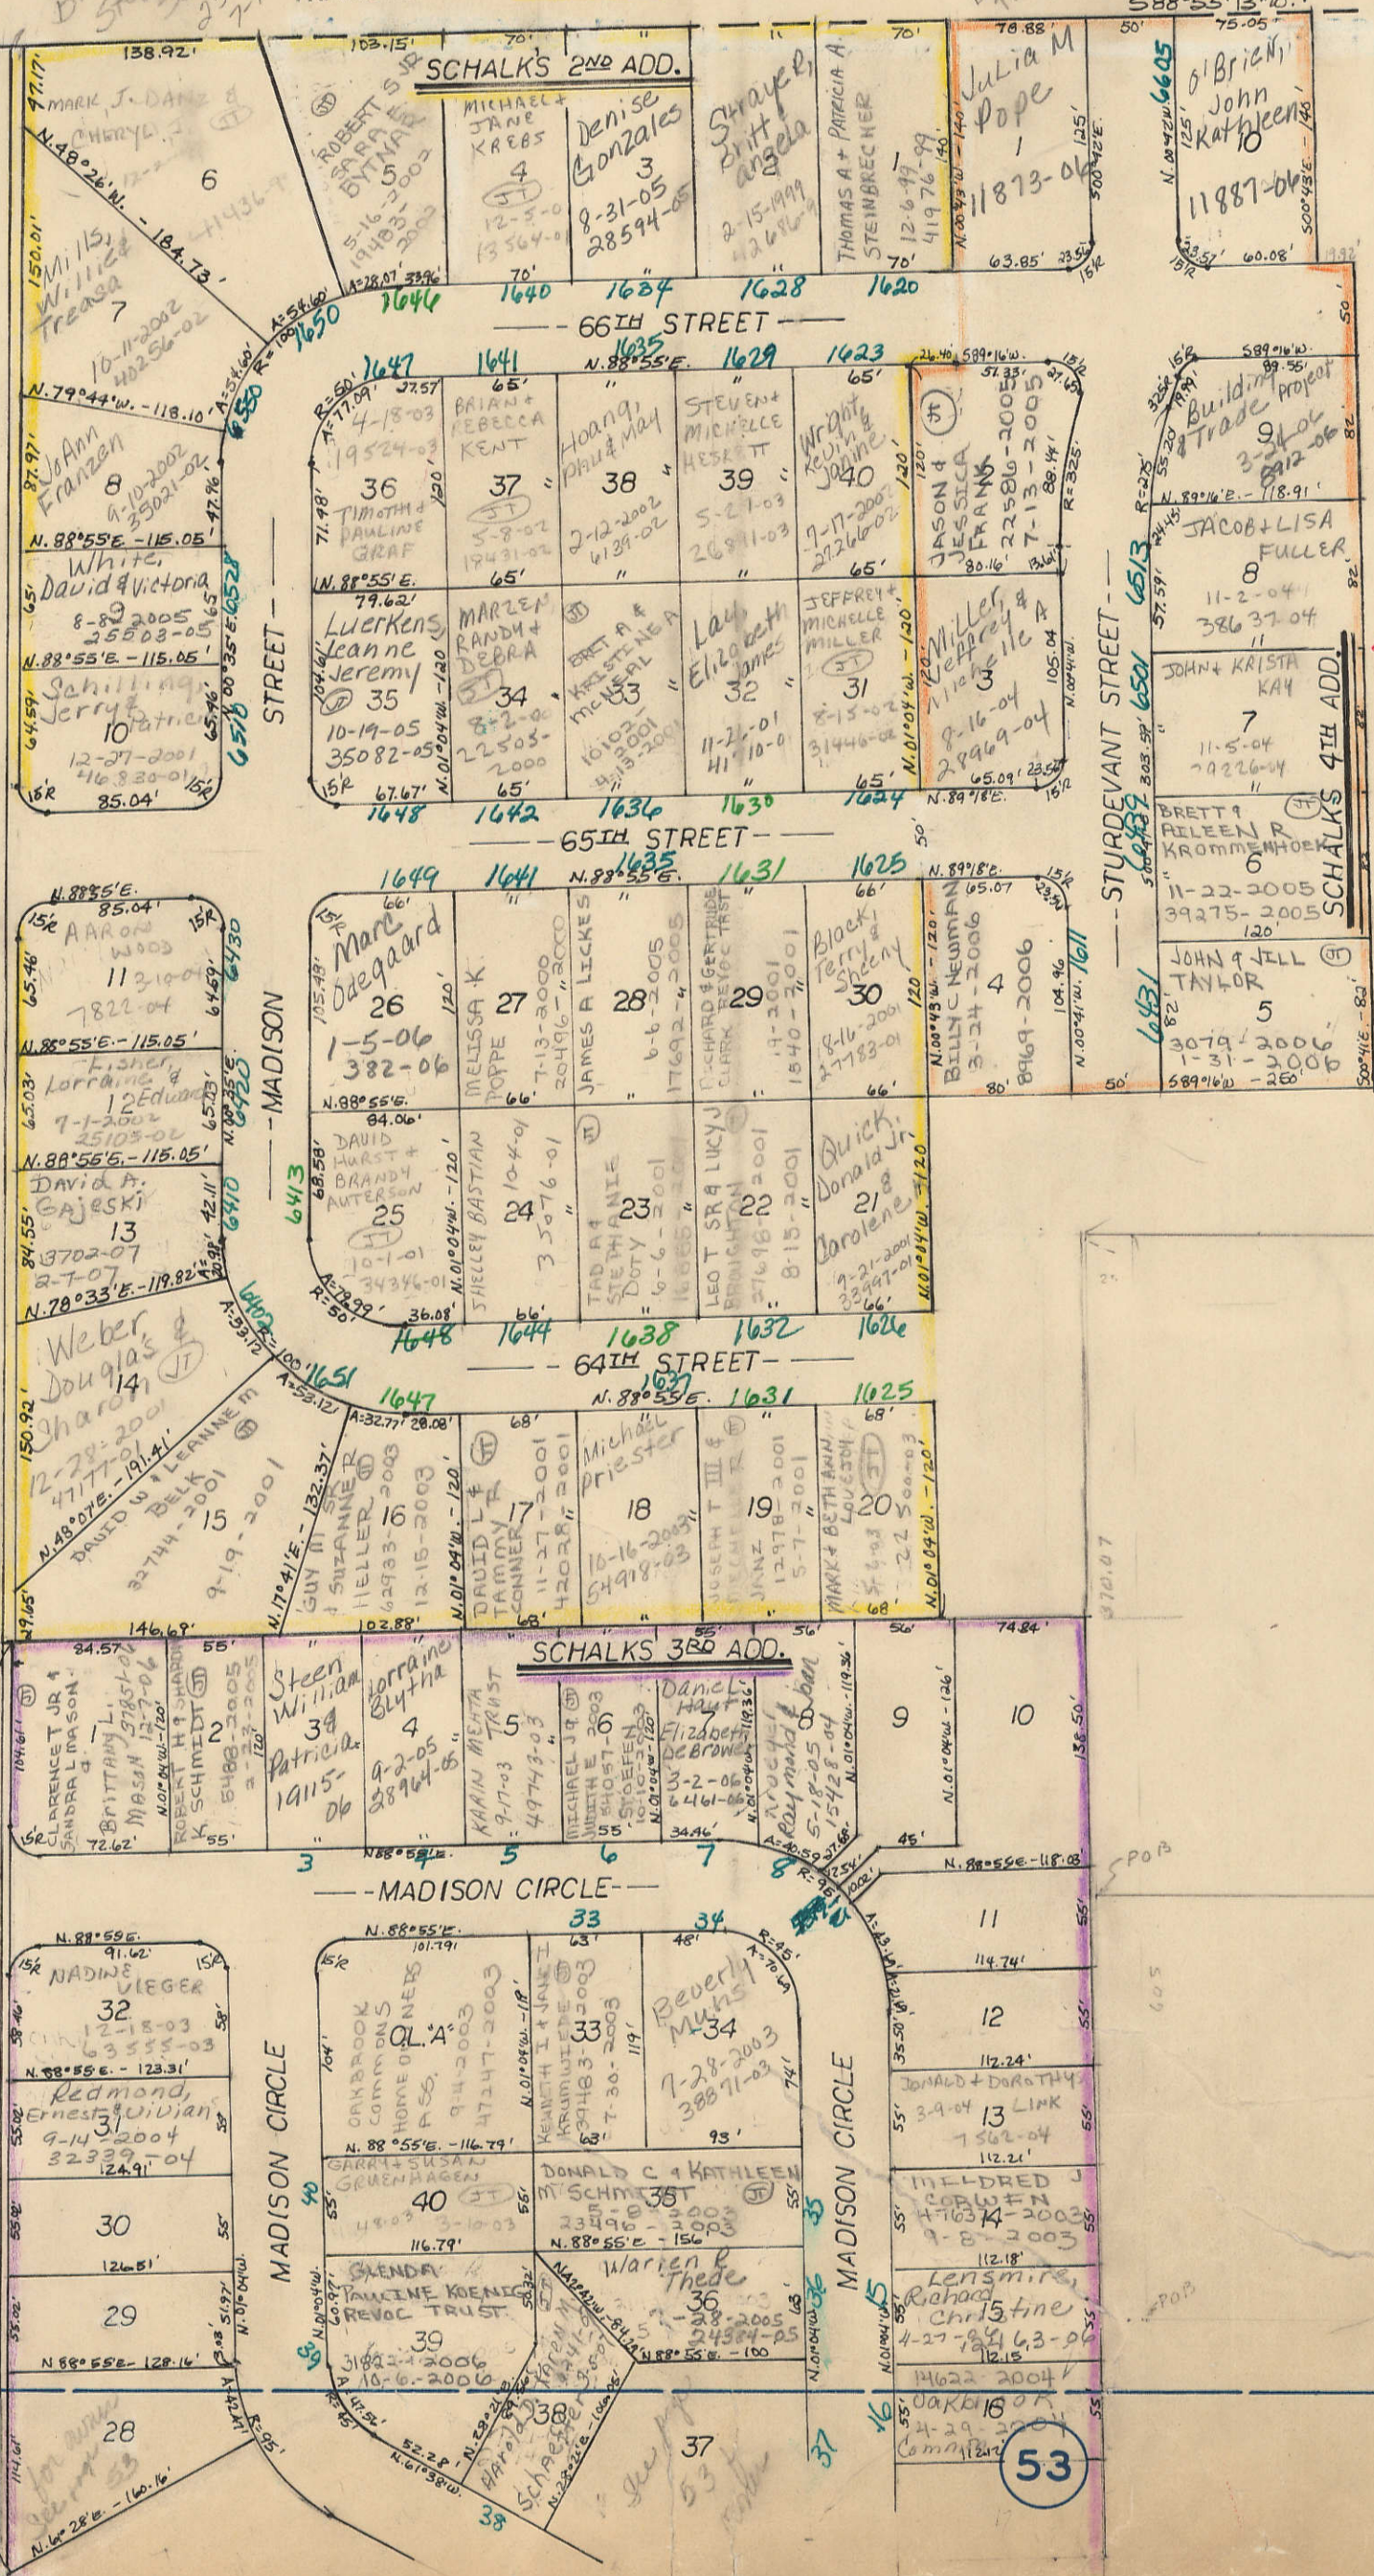

35

39

TRANSFER PAGE 15A-2603

STEPHEN L. SCHALK
8-24-89

Rob Fick, Inc
19131-2006

BLANKS TO
THUNDERBOLT INVESTMENT CORP.
2002-2004/6
8-24-2002

BLANKS TO
THUNDERBOLT INVESTMENT CORP.
2004-07/100
3-11-2004

53